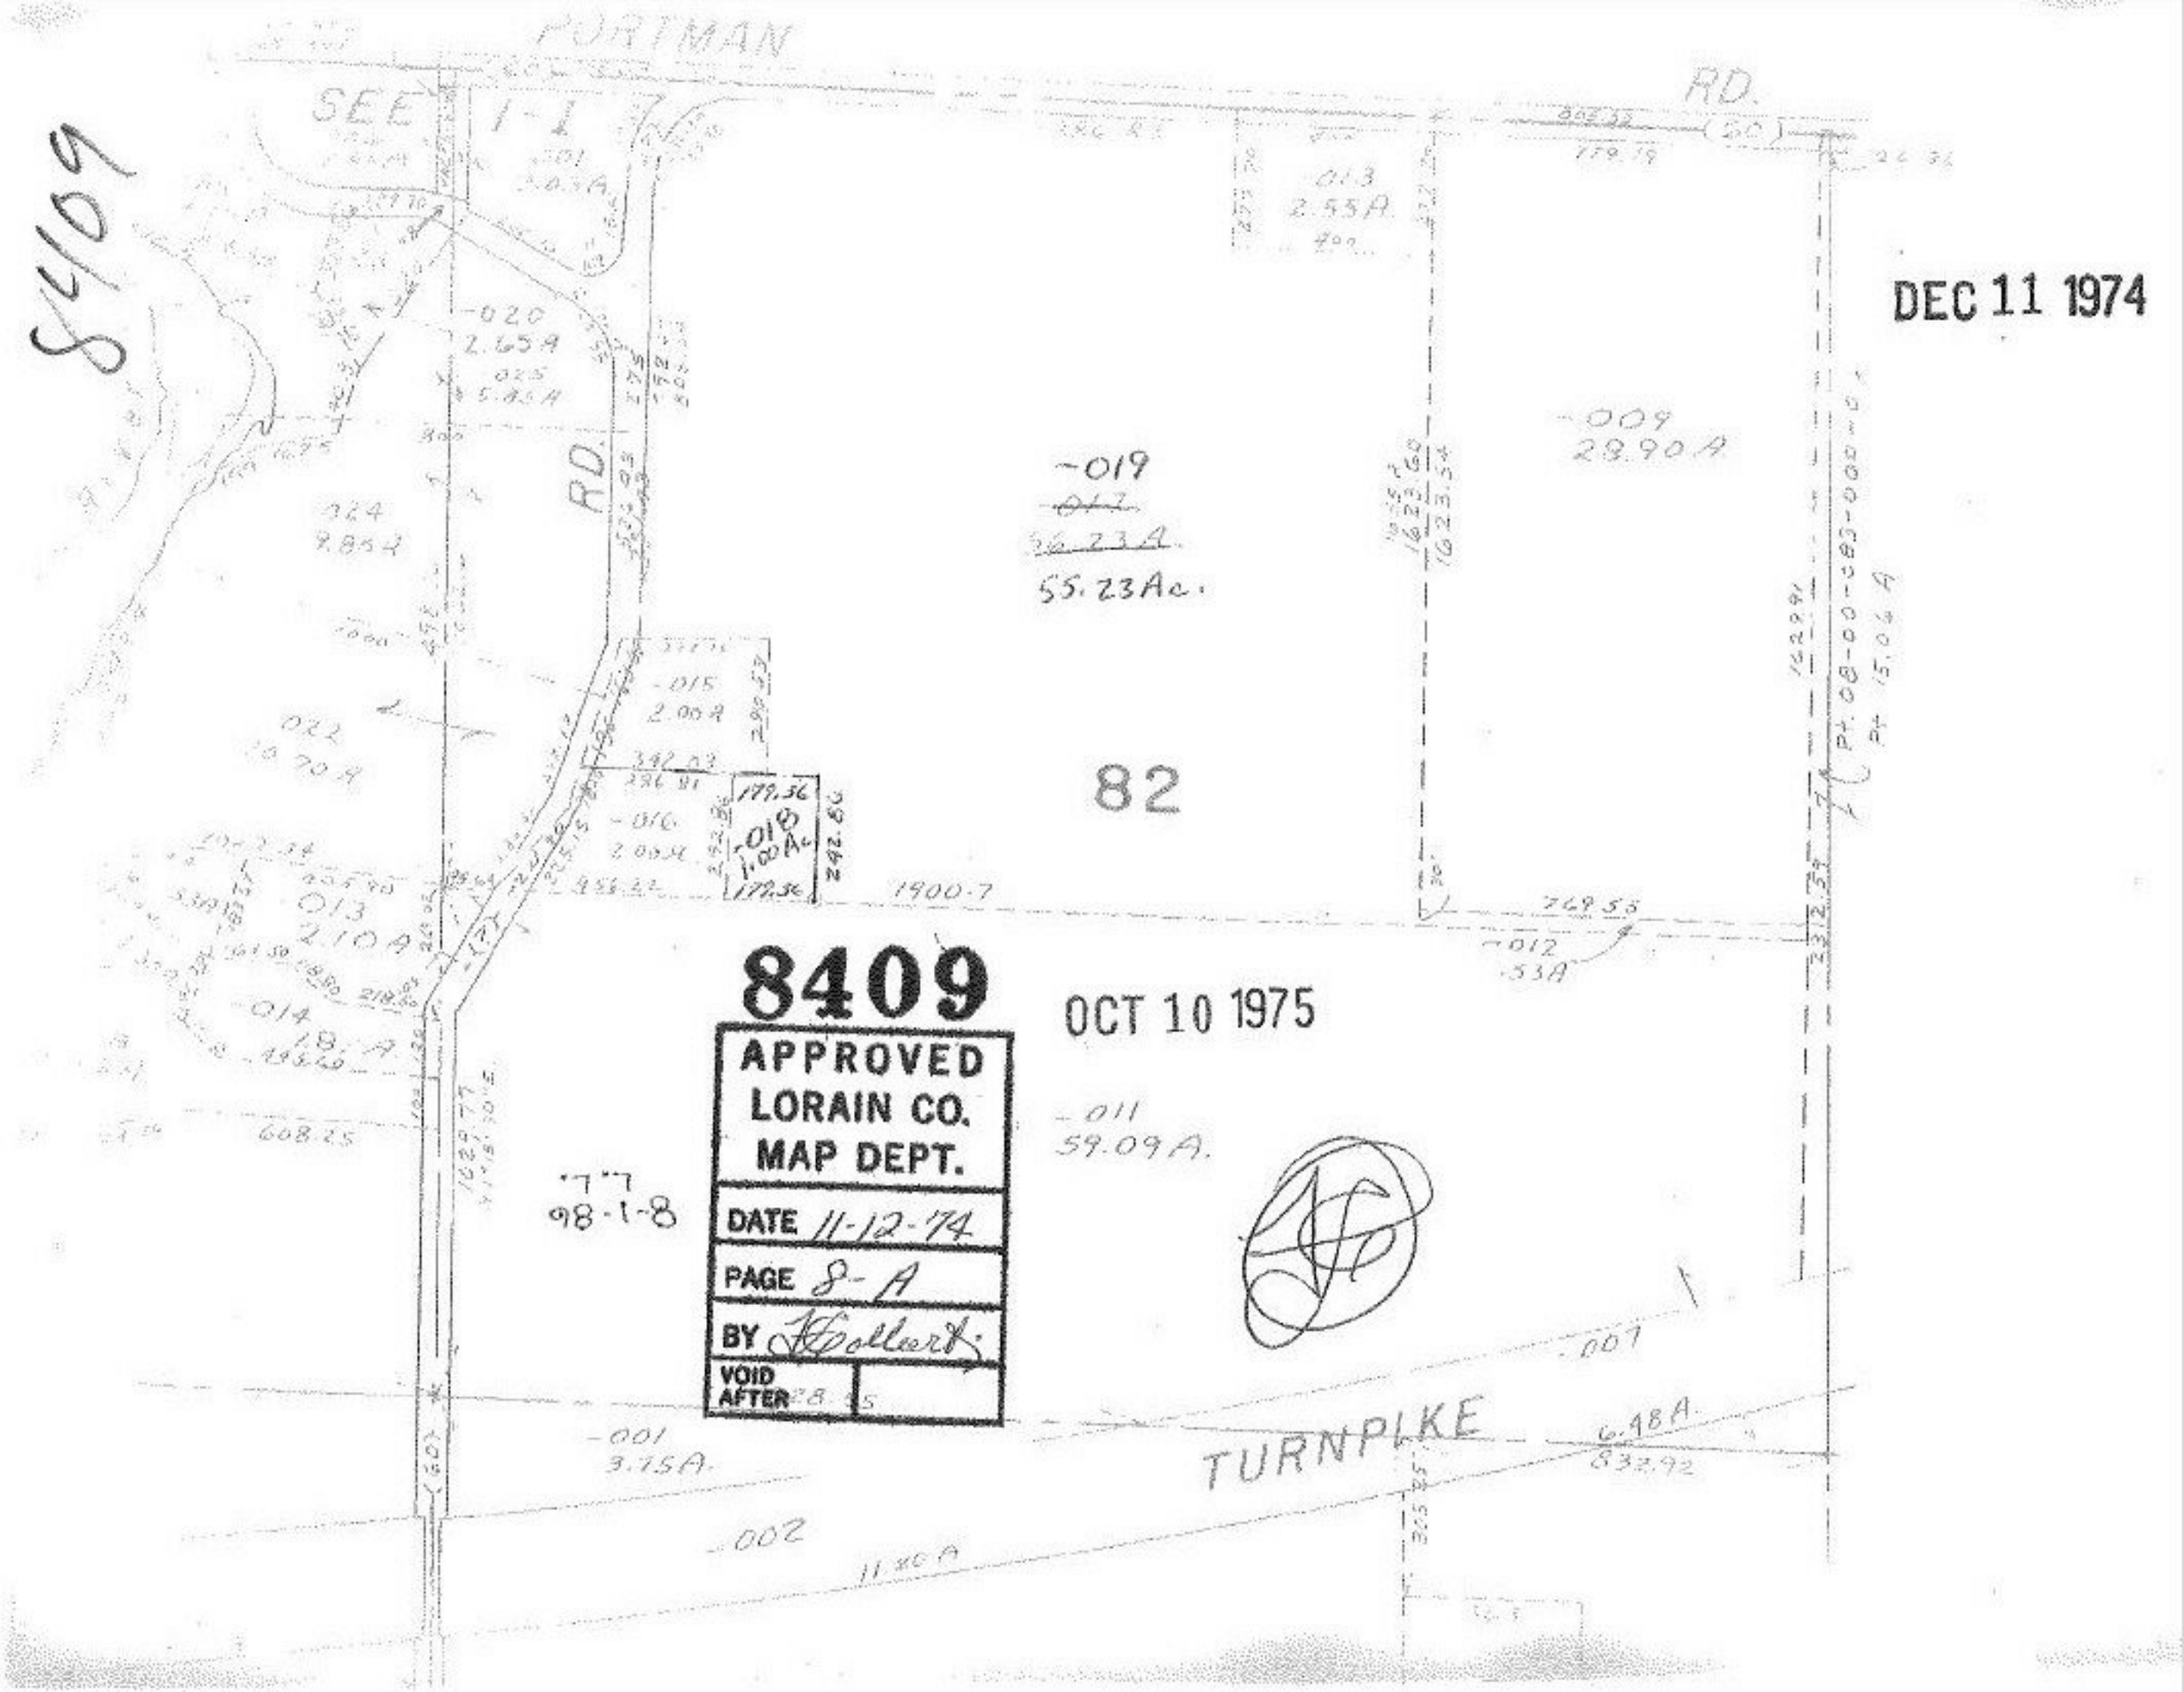

PORTMAN
RD.
SEE 1-1
8409
DEC 11 1974
-020
2.65A
-019
55.23Ac.
-009
28.90A
-015
2.00A
-016
2.00A
-018
1.00Ac
82
1900.7
-012
.53A
8409
OCT 10 1975
APPROVED
LORAIN CO.
MAP DEPT.
DATE 11-12-74
PAGE 8-A
BY
VOID AFTER
-011
59.09A.
98-1-8
-007
-001
3.75A.
TURNPIKE
6.48A
832.92
-002
11.80A