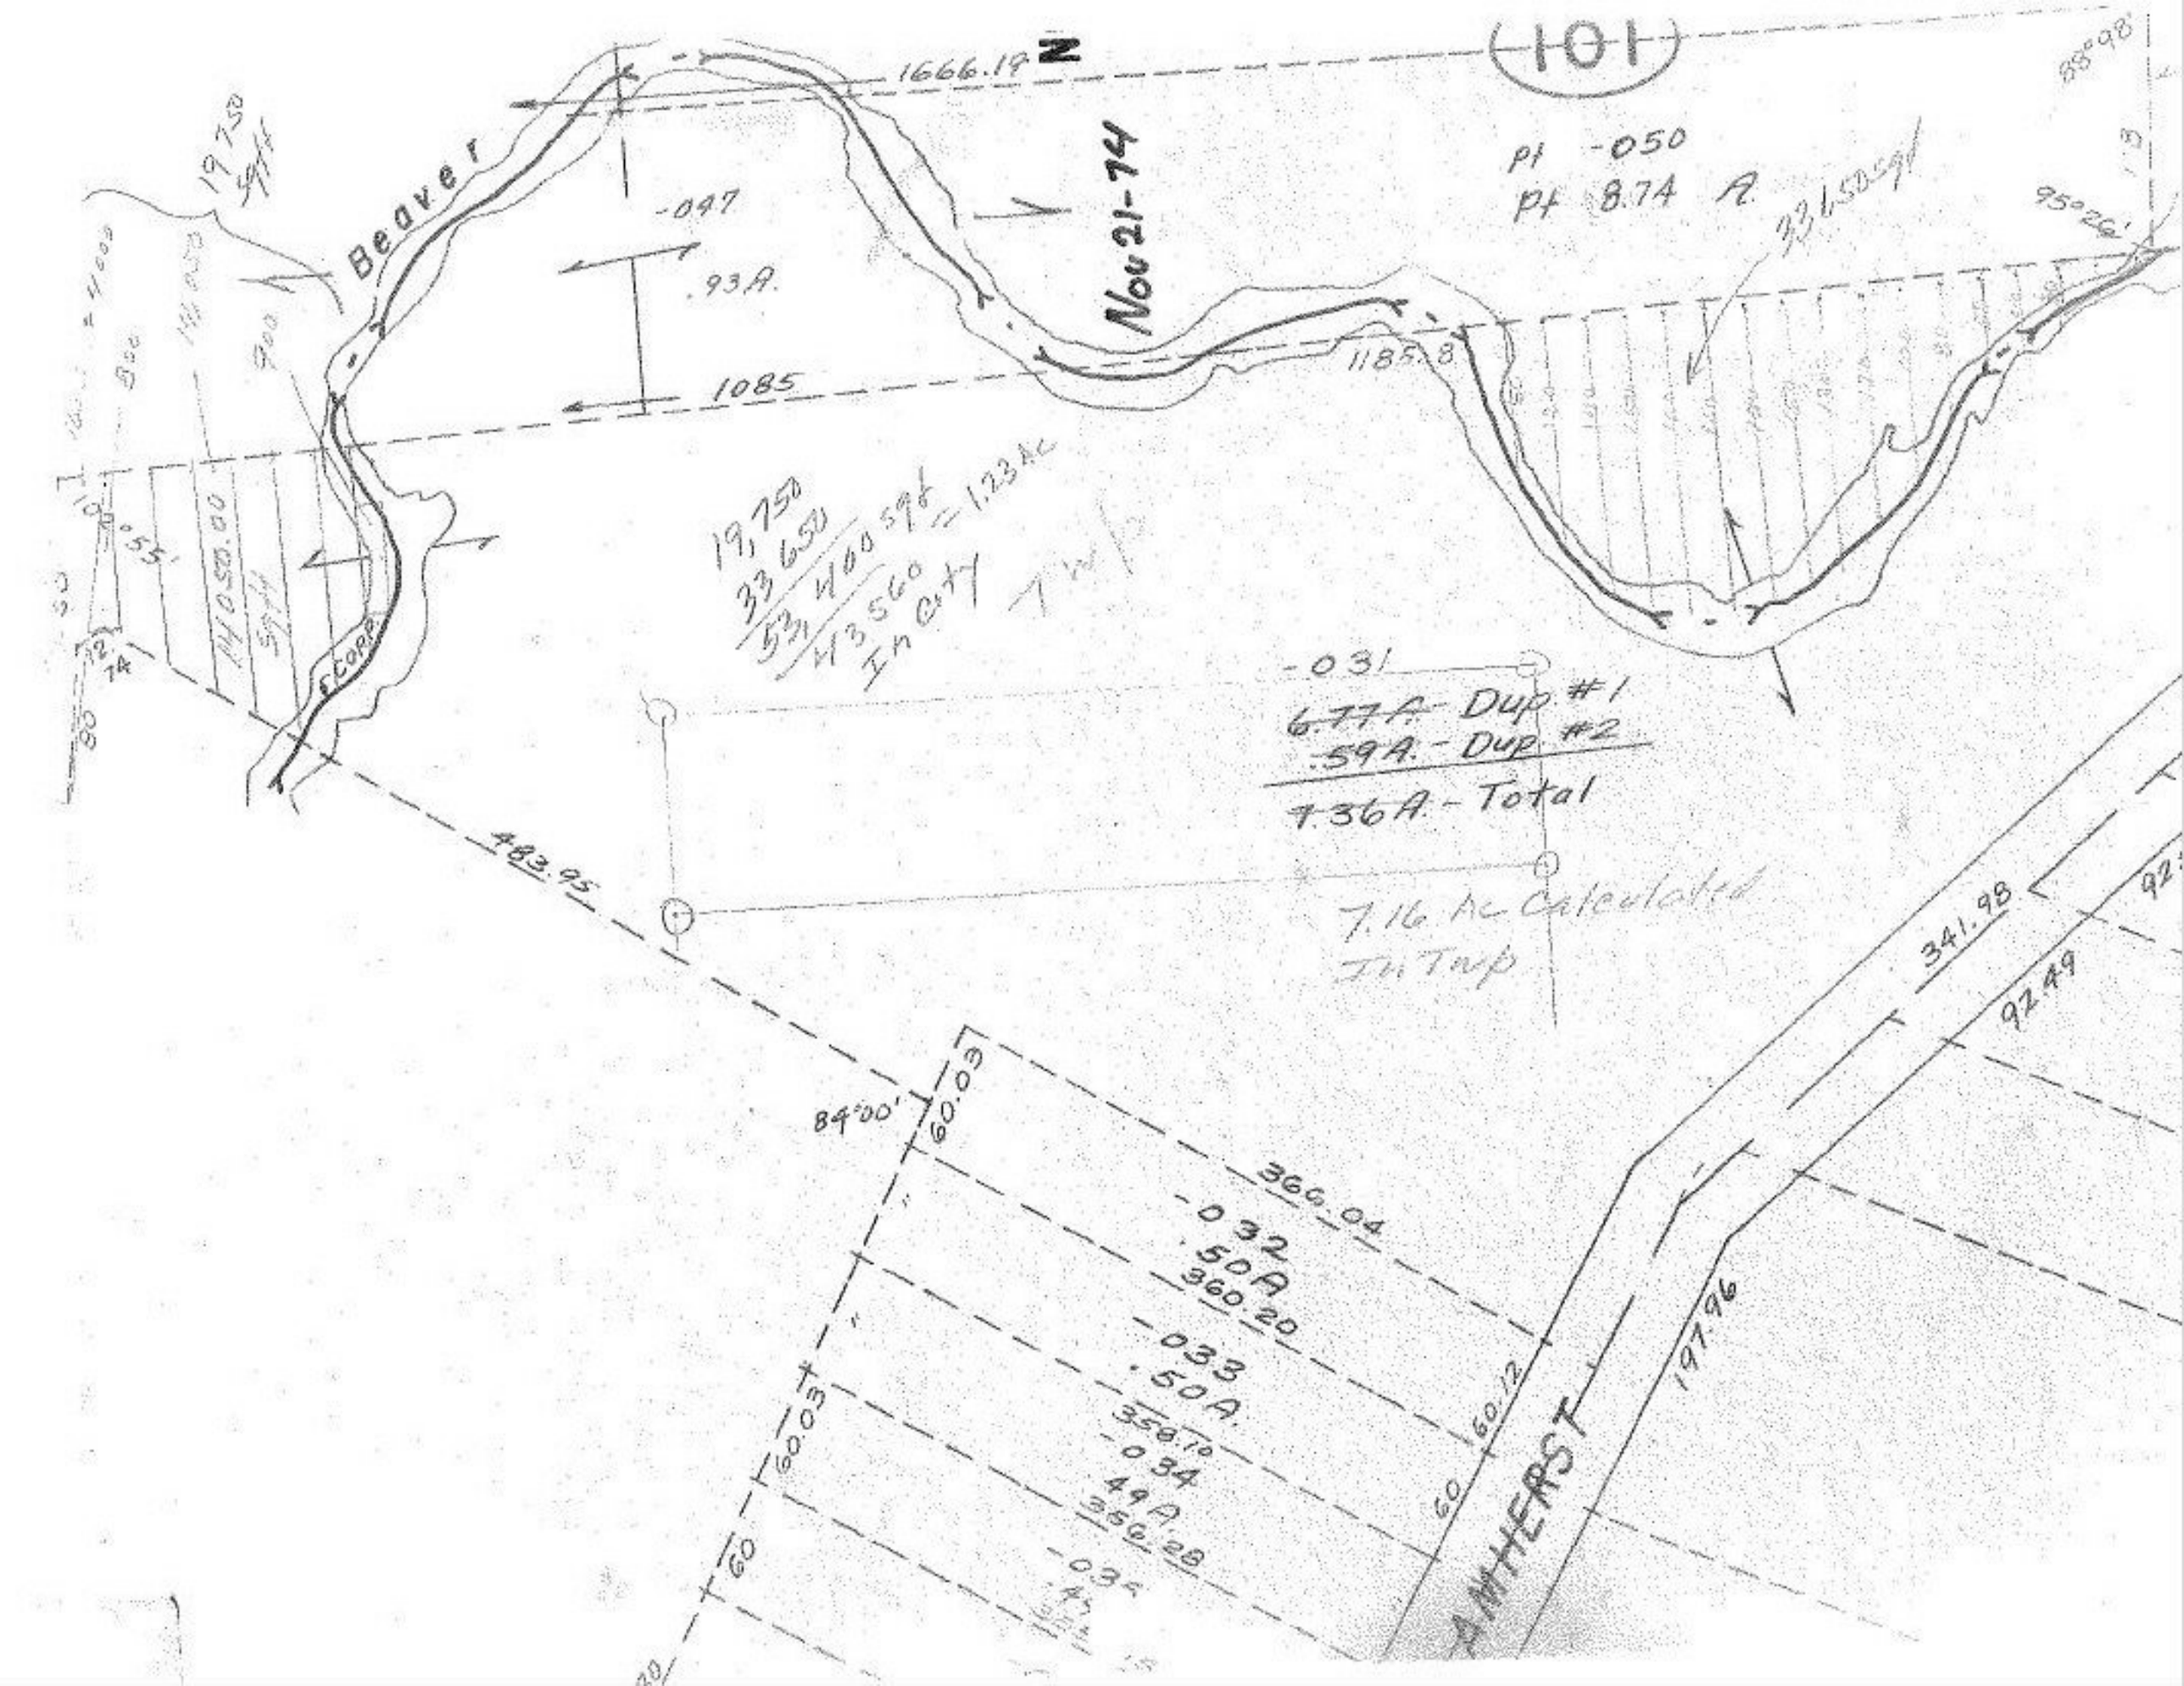
101
N
1666.19
Beaver
Nov 21-74
Pt -050
Pt 8.74 A.
33,650 sqft
95°26'
88°98'
-047
.93A.
1085
1185.8
19,750 sqft
14,050.00 sqft
19,750
33,650
53,400 sqft = 1.23 Ac
43,560
In City
-031
6.77A. - Dup #1
.59A. - Dup #2
7.36A. - Total
7.16 Ac Calculated
In Twp
483.95
84°00'
60.03
366.04
-032
.50A
360.20
-033
.50A.
358.10
-034
.49A
356.28
60.12
60
AMHERST
197.96
341.98
92.49