APPROVED
LORAIN CO.
MAP DEPT.
DATE 11-26-74
PAGE 6-11
BY L.H. Hall
VOID AFTER

DEC 1 1975

8436
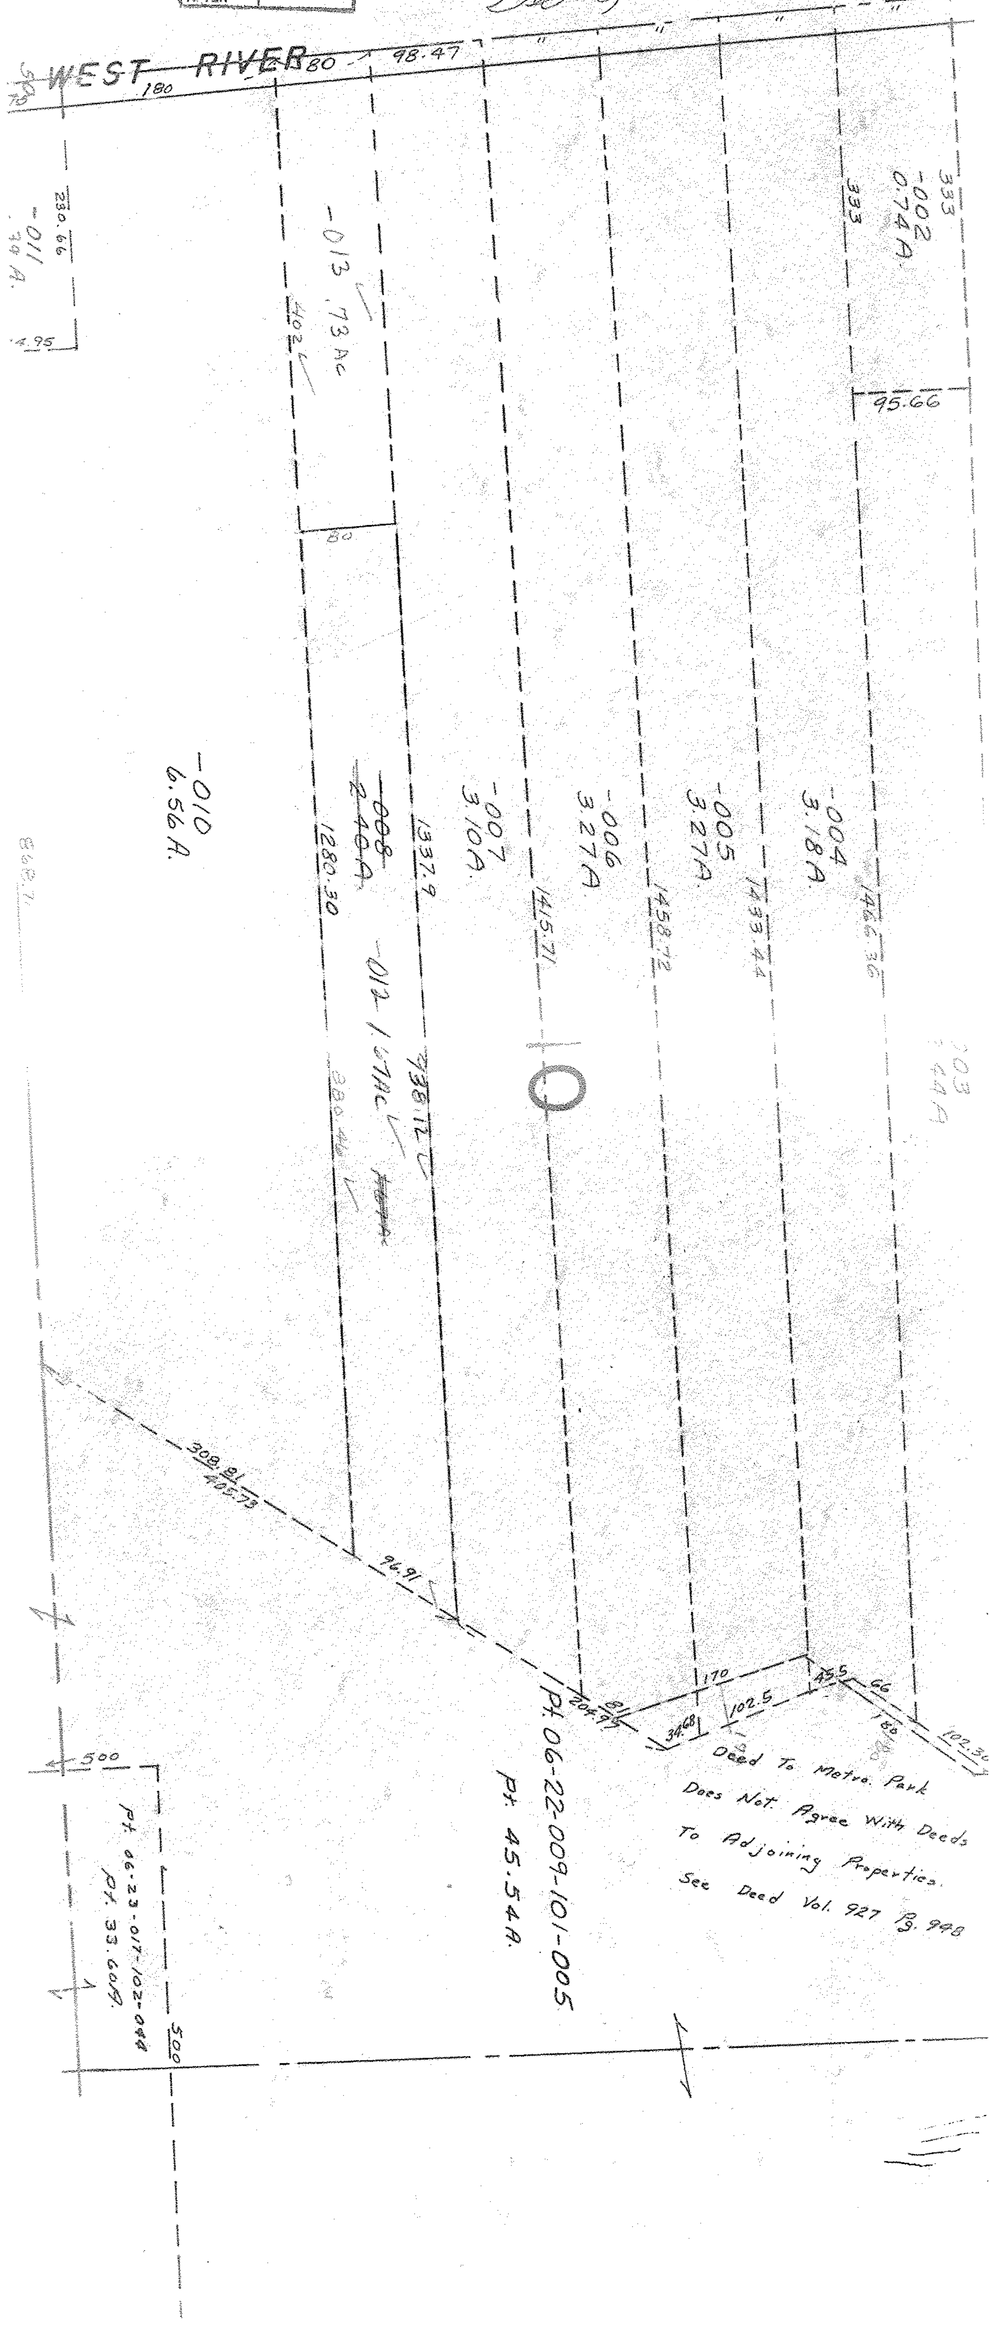
Dec 3, 1974