#8437

DEC 3 1974

JAN 20 1975

8437

APPROVED
LORAIN CO.
MAP DEPT.

DATE 11-27-74

PAGE 11-00-093 B

BY L W Hall
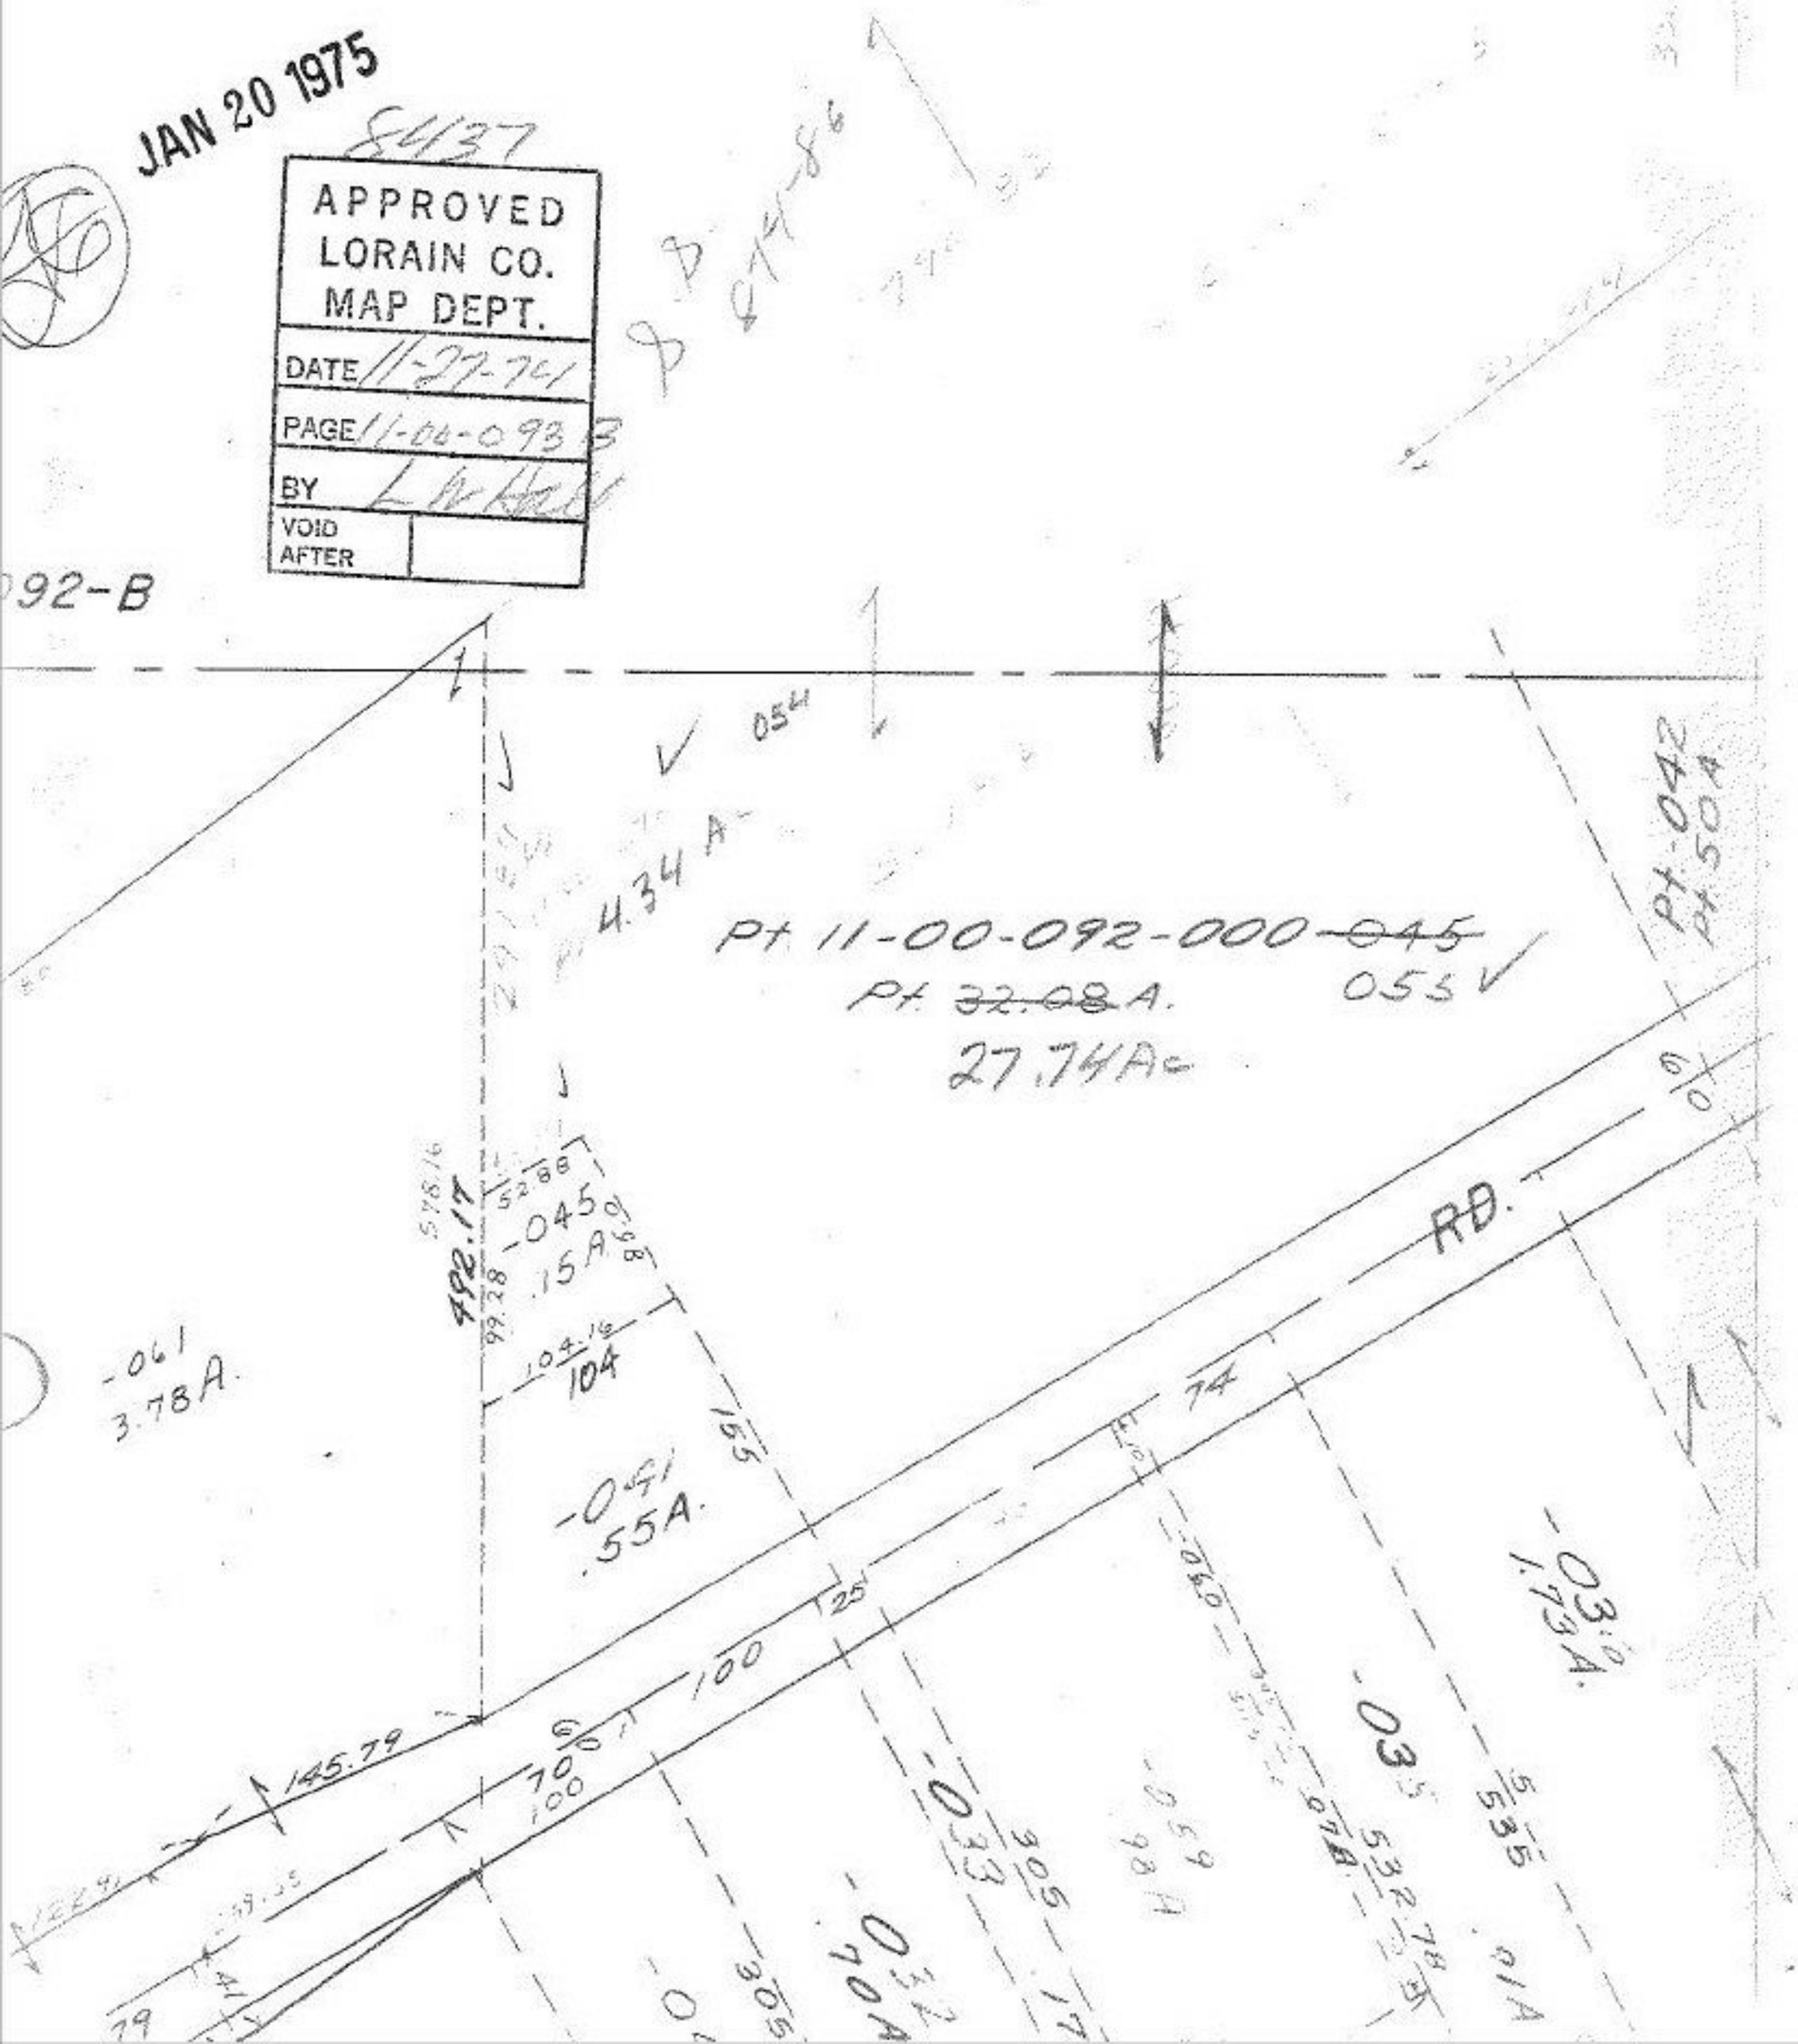
VOID AFTER