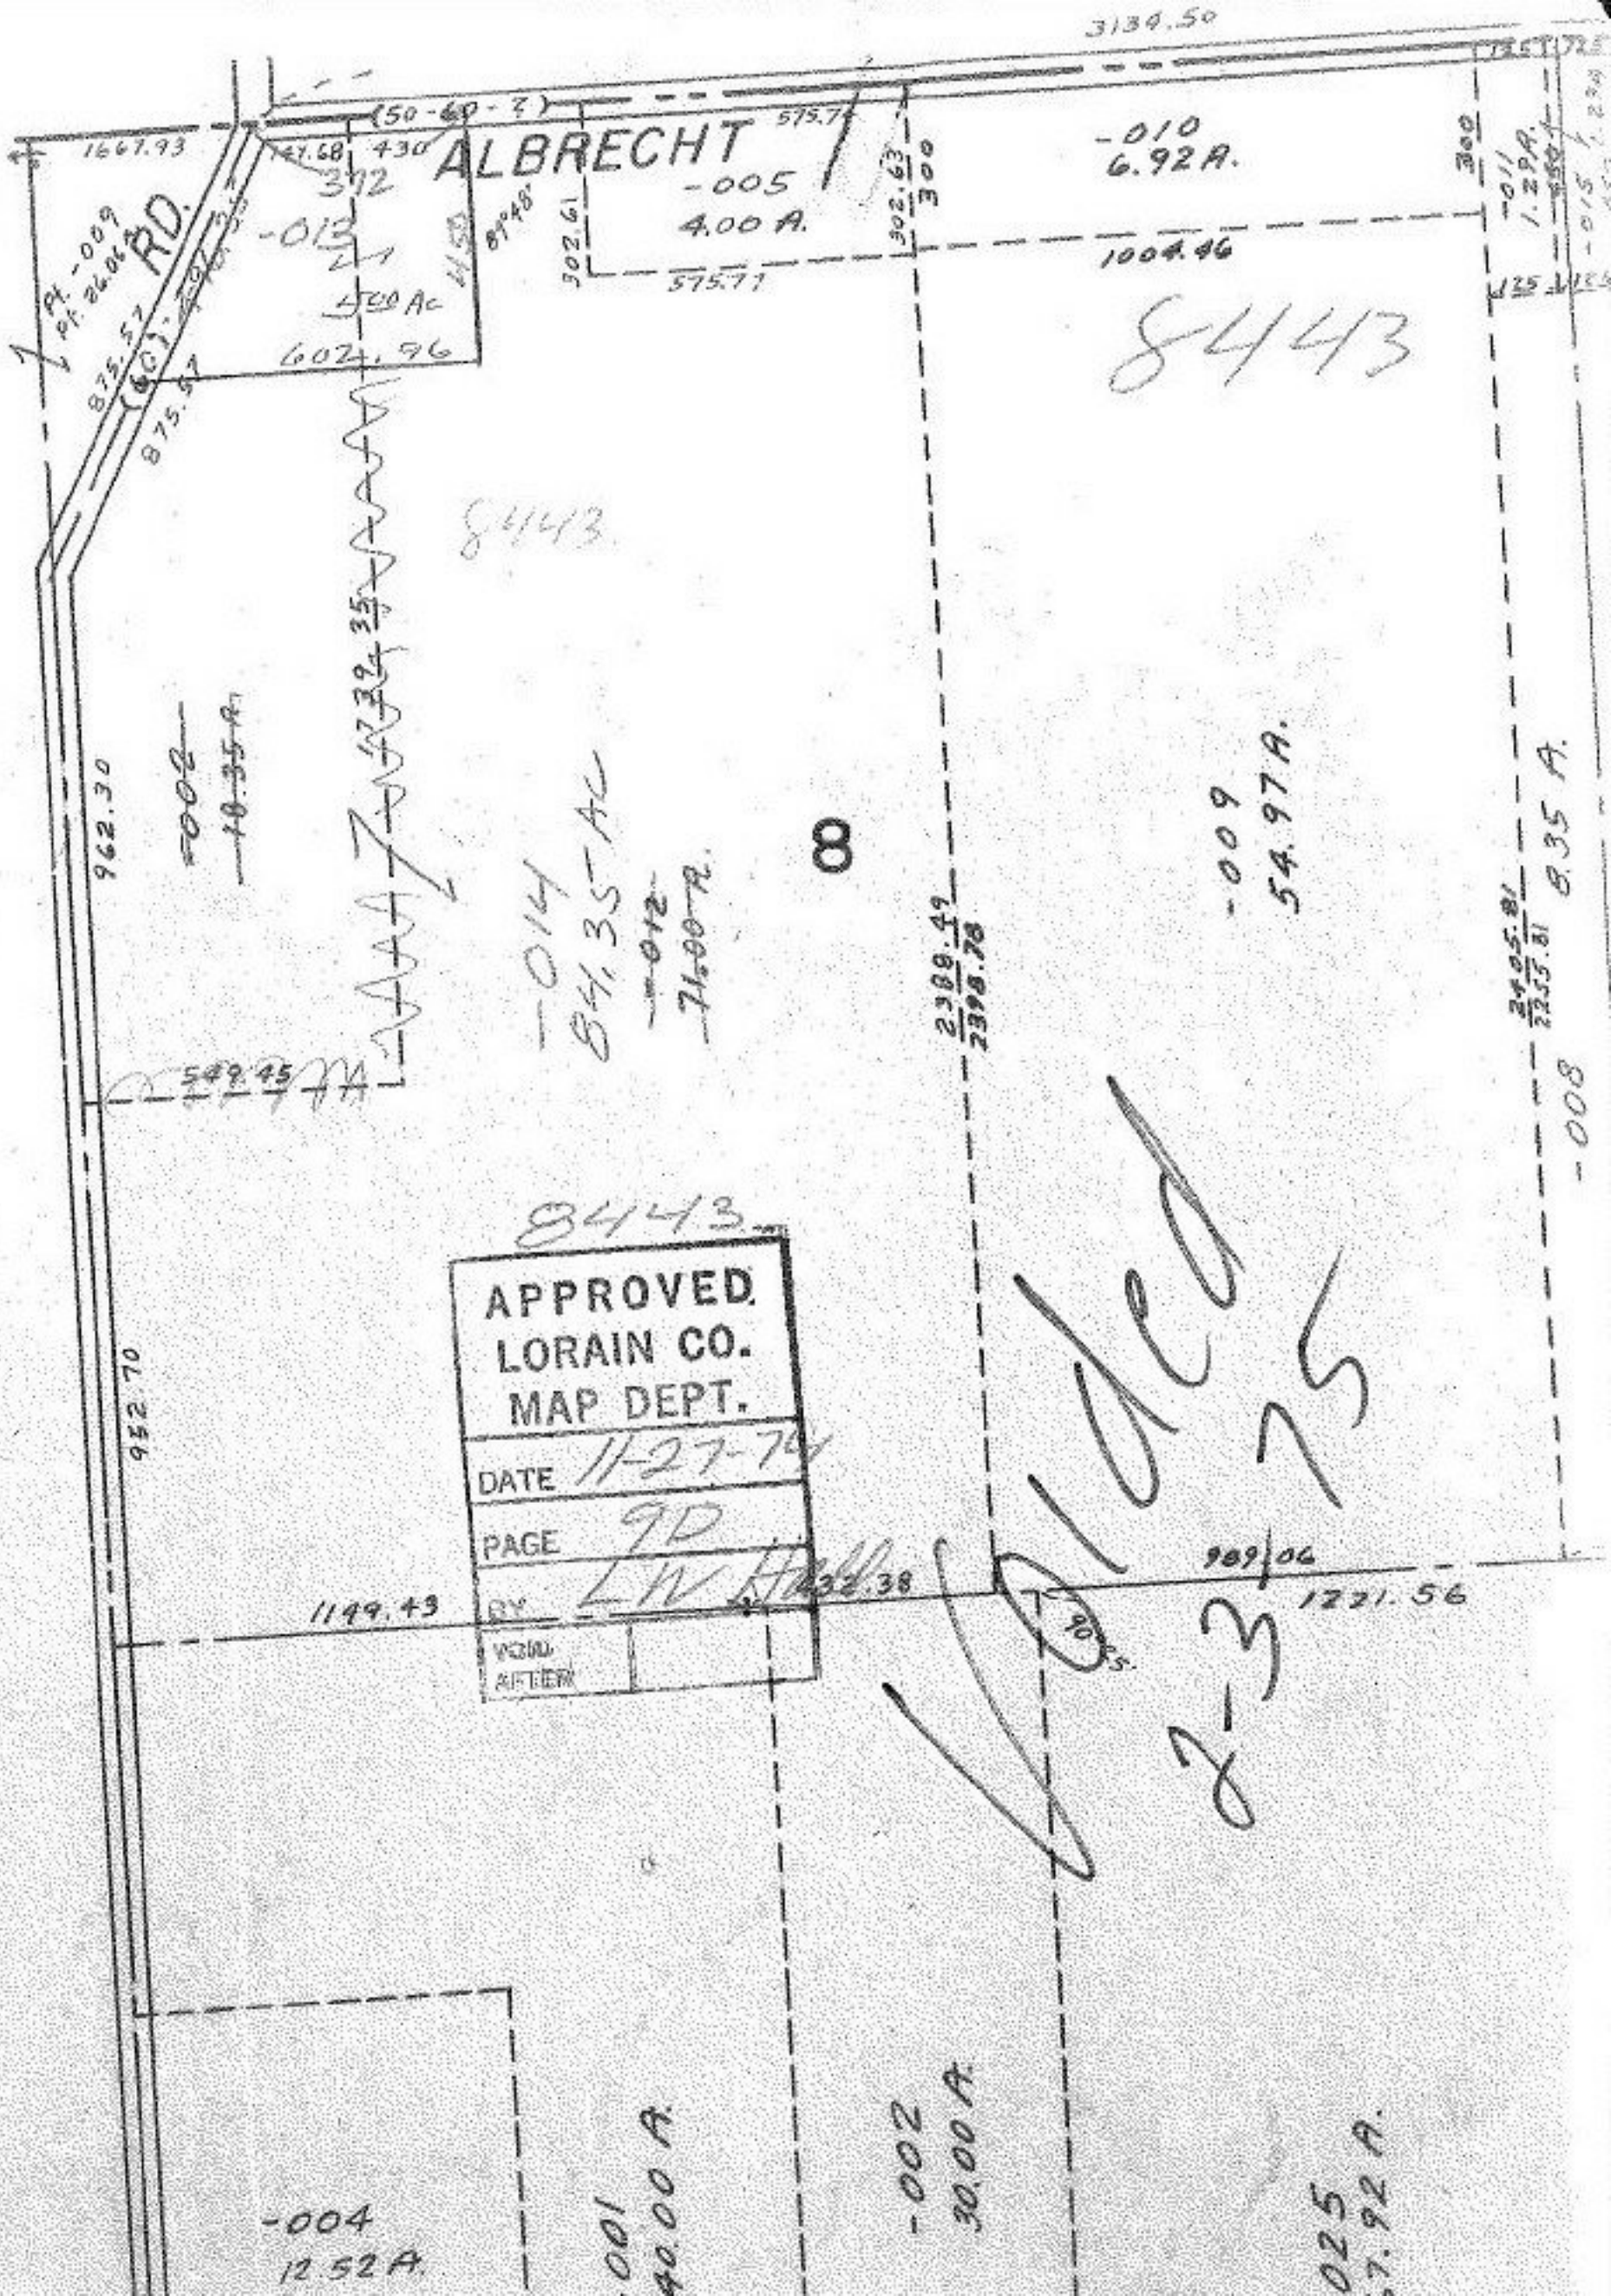

3134.50
(50-60-?)
ALBRECHT
RD.
1667.93
-005
4.00 A.
-010
6.92 A.
1004.46
575.77
302.61
302.63
300
-011
1.29 A.
-013
4.00 Ac
602.96
875.57
8443
8443
962.30
-002
18.35 A.
-014
84.35 Ac
-012
71.00 A.
8
-009
54.97 A.
2388.49
2398.78
2405.81
2255.81
8.35 A.
-008
549.45
8443
APPROVED
LORAIN CO.
MAP DEPT.
DATE 11-27-74
PAGE 9D
BY LW Hall
VOID AFTER
952.70
1149.43
989.06
1221.56
Voided
2-3-75
-004
12.52 A.
-001
40.00 A.
-002
30.00 A.
-025