


DEC 11 1974

8446

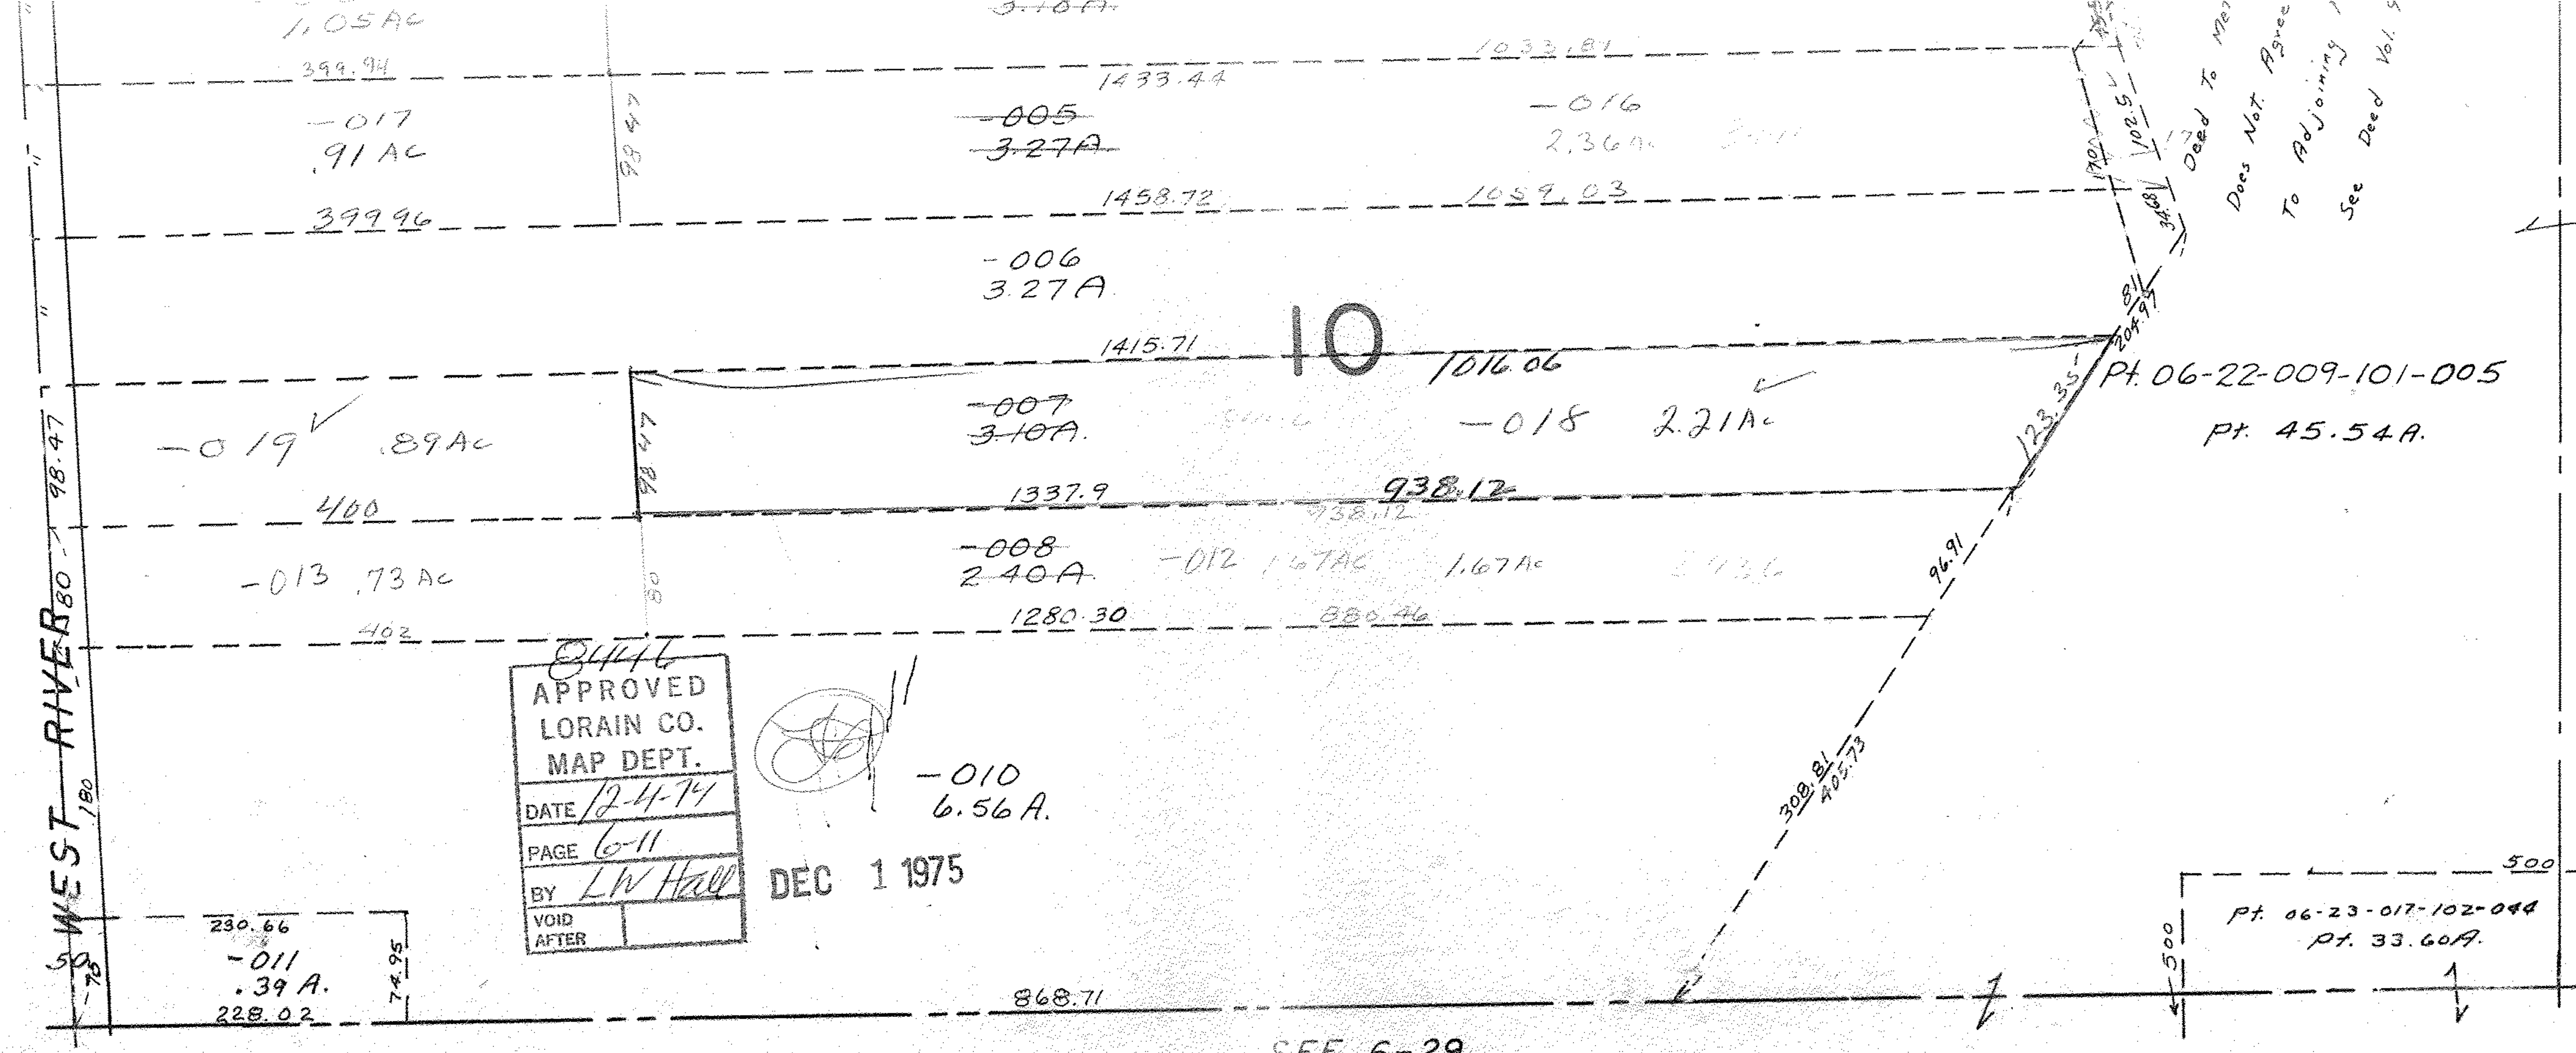

Deed To Me
Does Not Agree
To Adjoining
See Deed Vol. 5

Pt. 06-22-009-101-005
Pt. 45.54A.

Pt. 06-23-017-102-044
Pt. 33.60A.

APPROVED
LORAIN CO.
MAP DEPT.
DATE 12-4-74
PAGE 6-11
BY LW Hall
VOID AFTER

DEC 1 1975

SEE 6-29
BURRELL & DAY TRACT

W 1/2 PT. LOT 12
LOTS 10, 11

ELYRIA
SCALE: 1" = 100'

1963
4-1-74