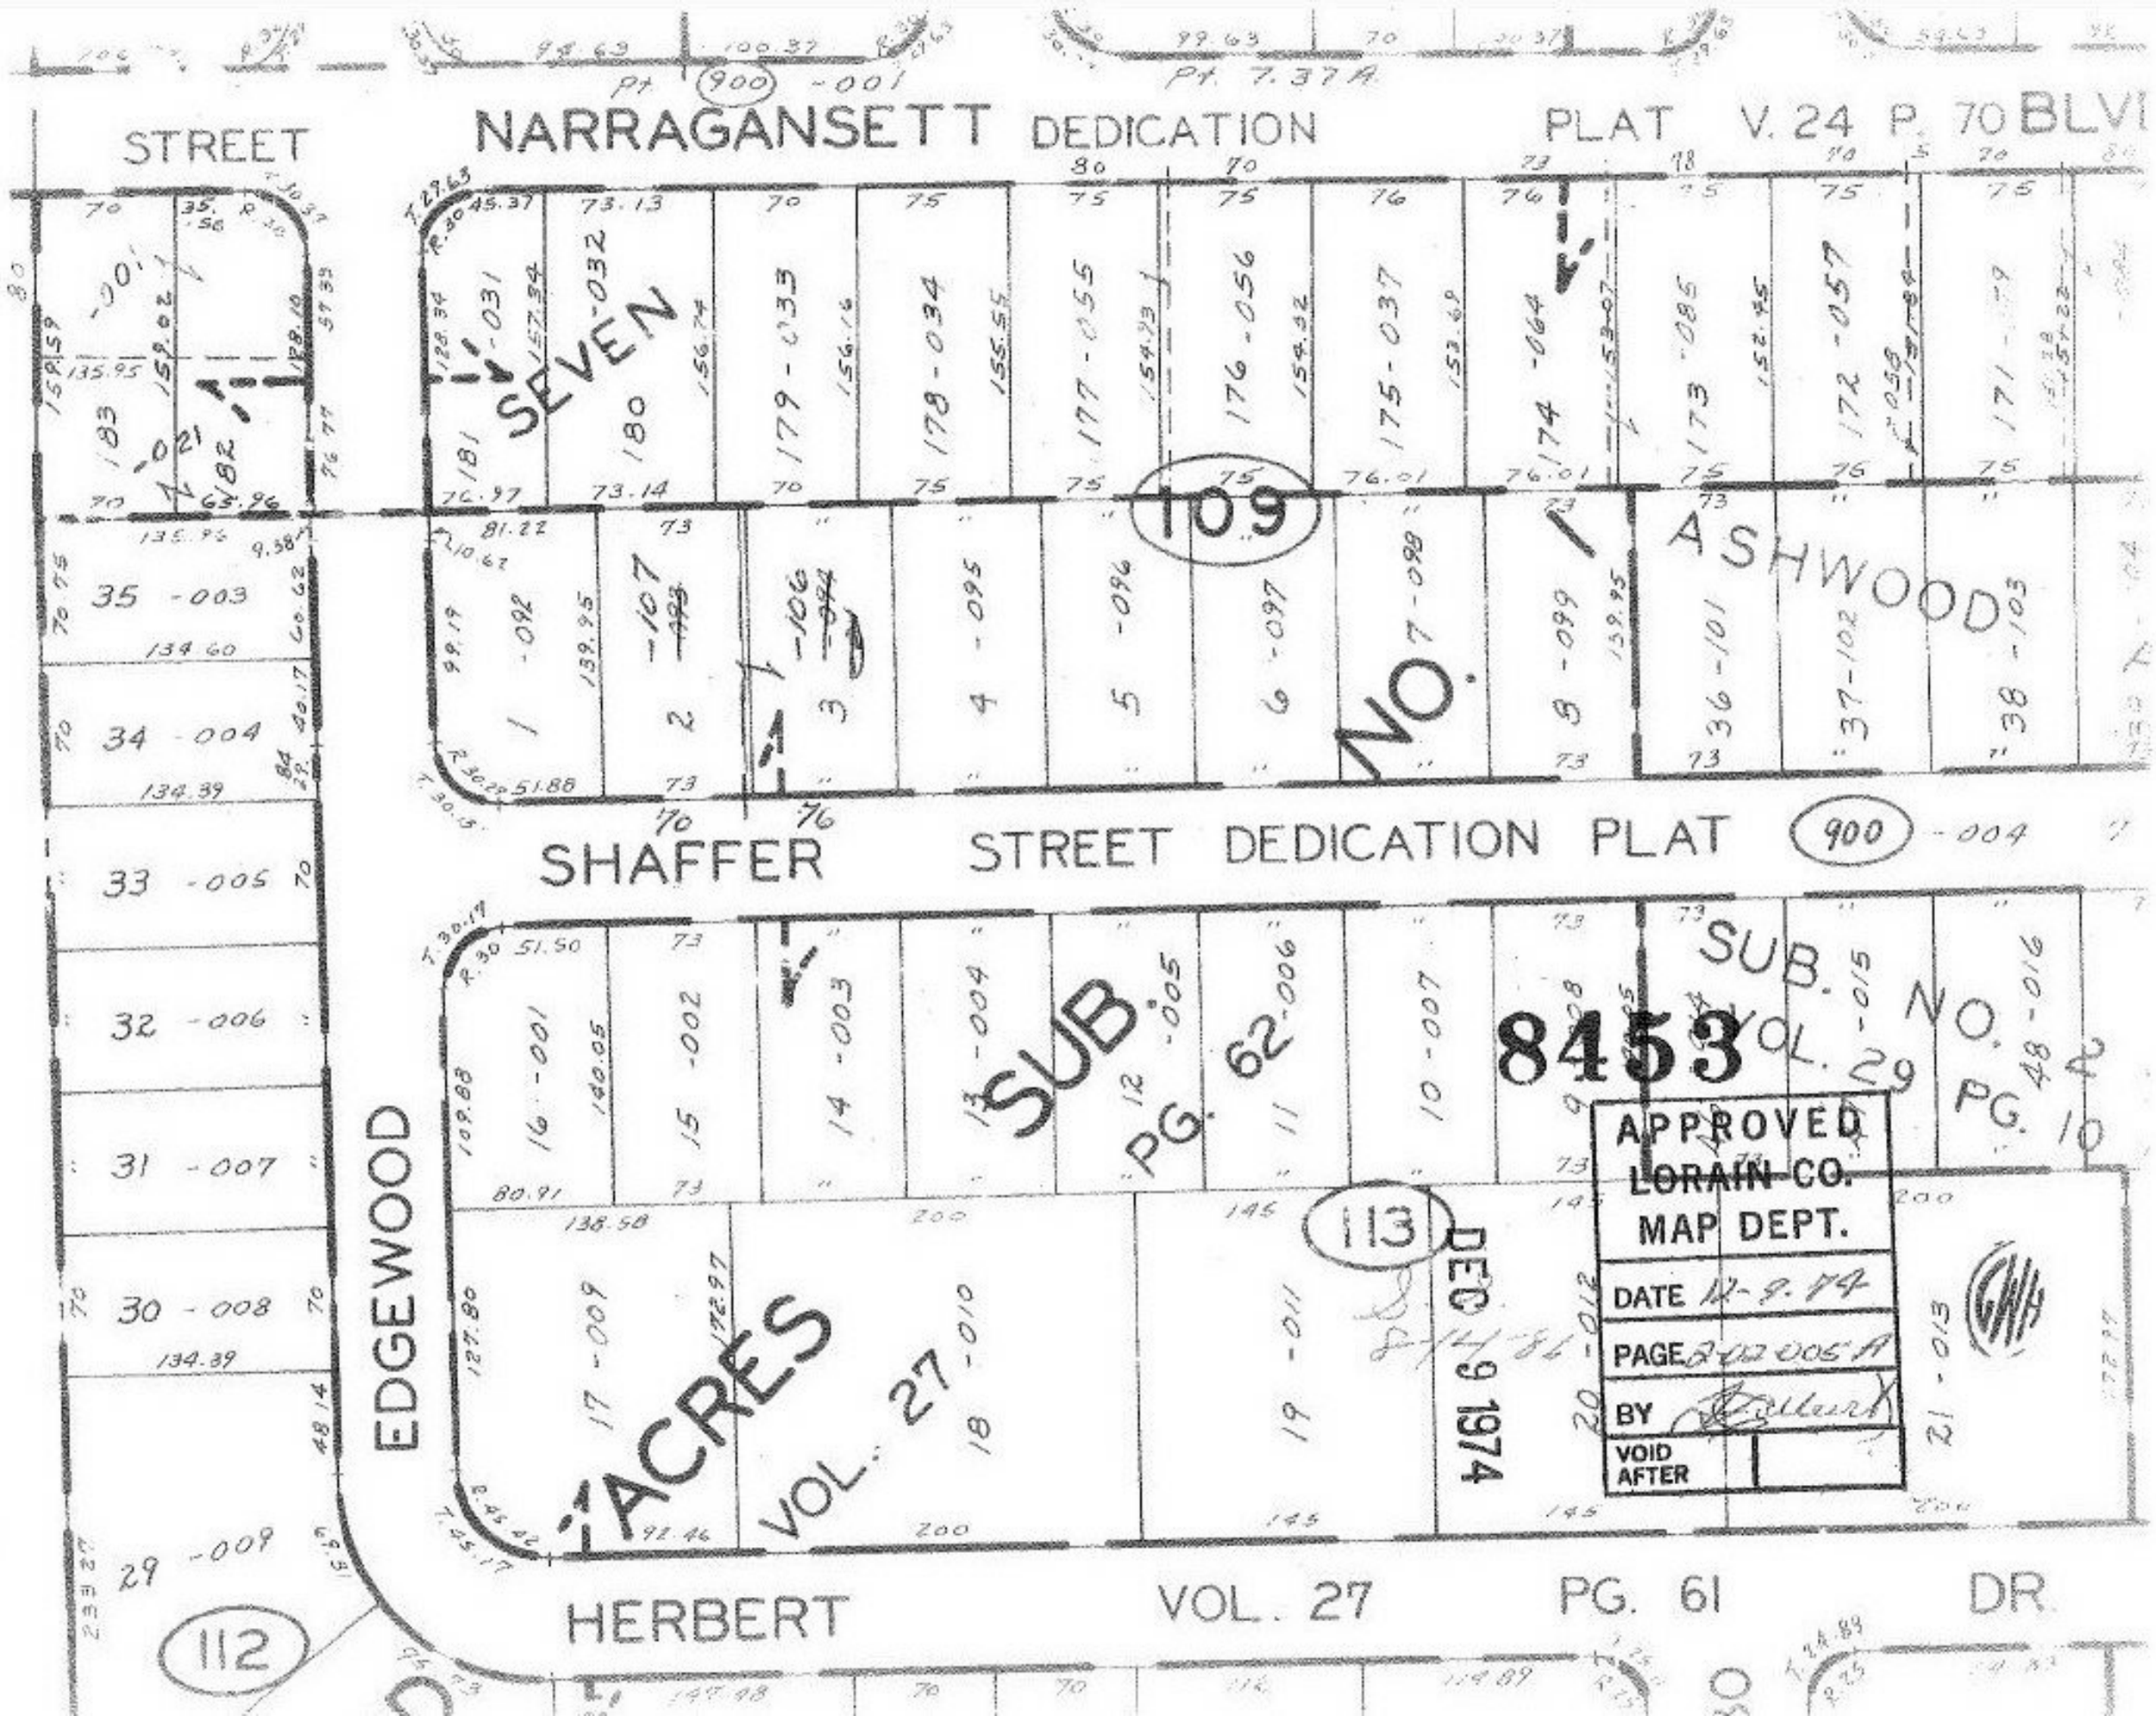

Pt. (900) -001
Pt. 7.37 A
STREET
NARRAGANSETT DEDICATION PLAT V. 24 P. 70 BLVD
SEVEN
ASHWOOD
NO. 7
109
SHAFFER STREET DEDICATION PLAT (900) -004
SUB. NO. 2
VOL. 29 PG. 10
SUB. PG. 62
8453
APPROVED
LORAIN CO.
MAP DEPT.
DATE 12-9-74
PAGE 2-02-005 A
BY
VOID AFTER
DEC 9 1974
113
ACRES
VOL. 27
EDGEWOOD
HERBERT VOL. 27 PG. 61 DR.
112