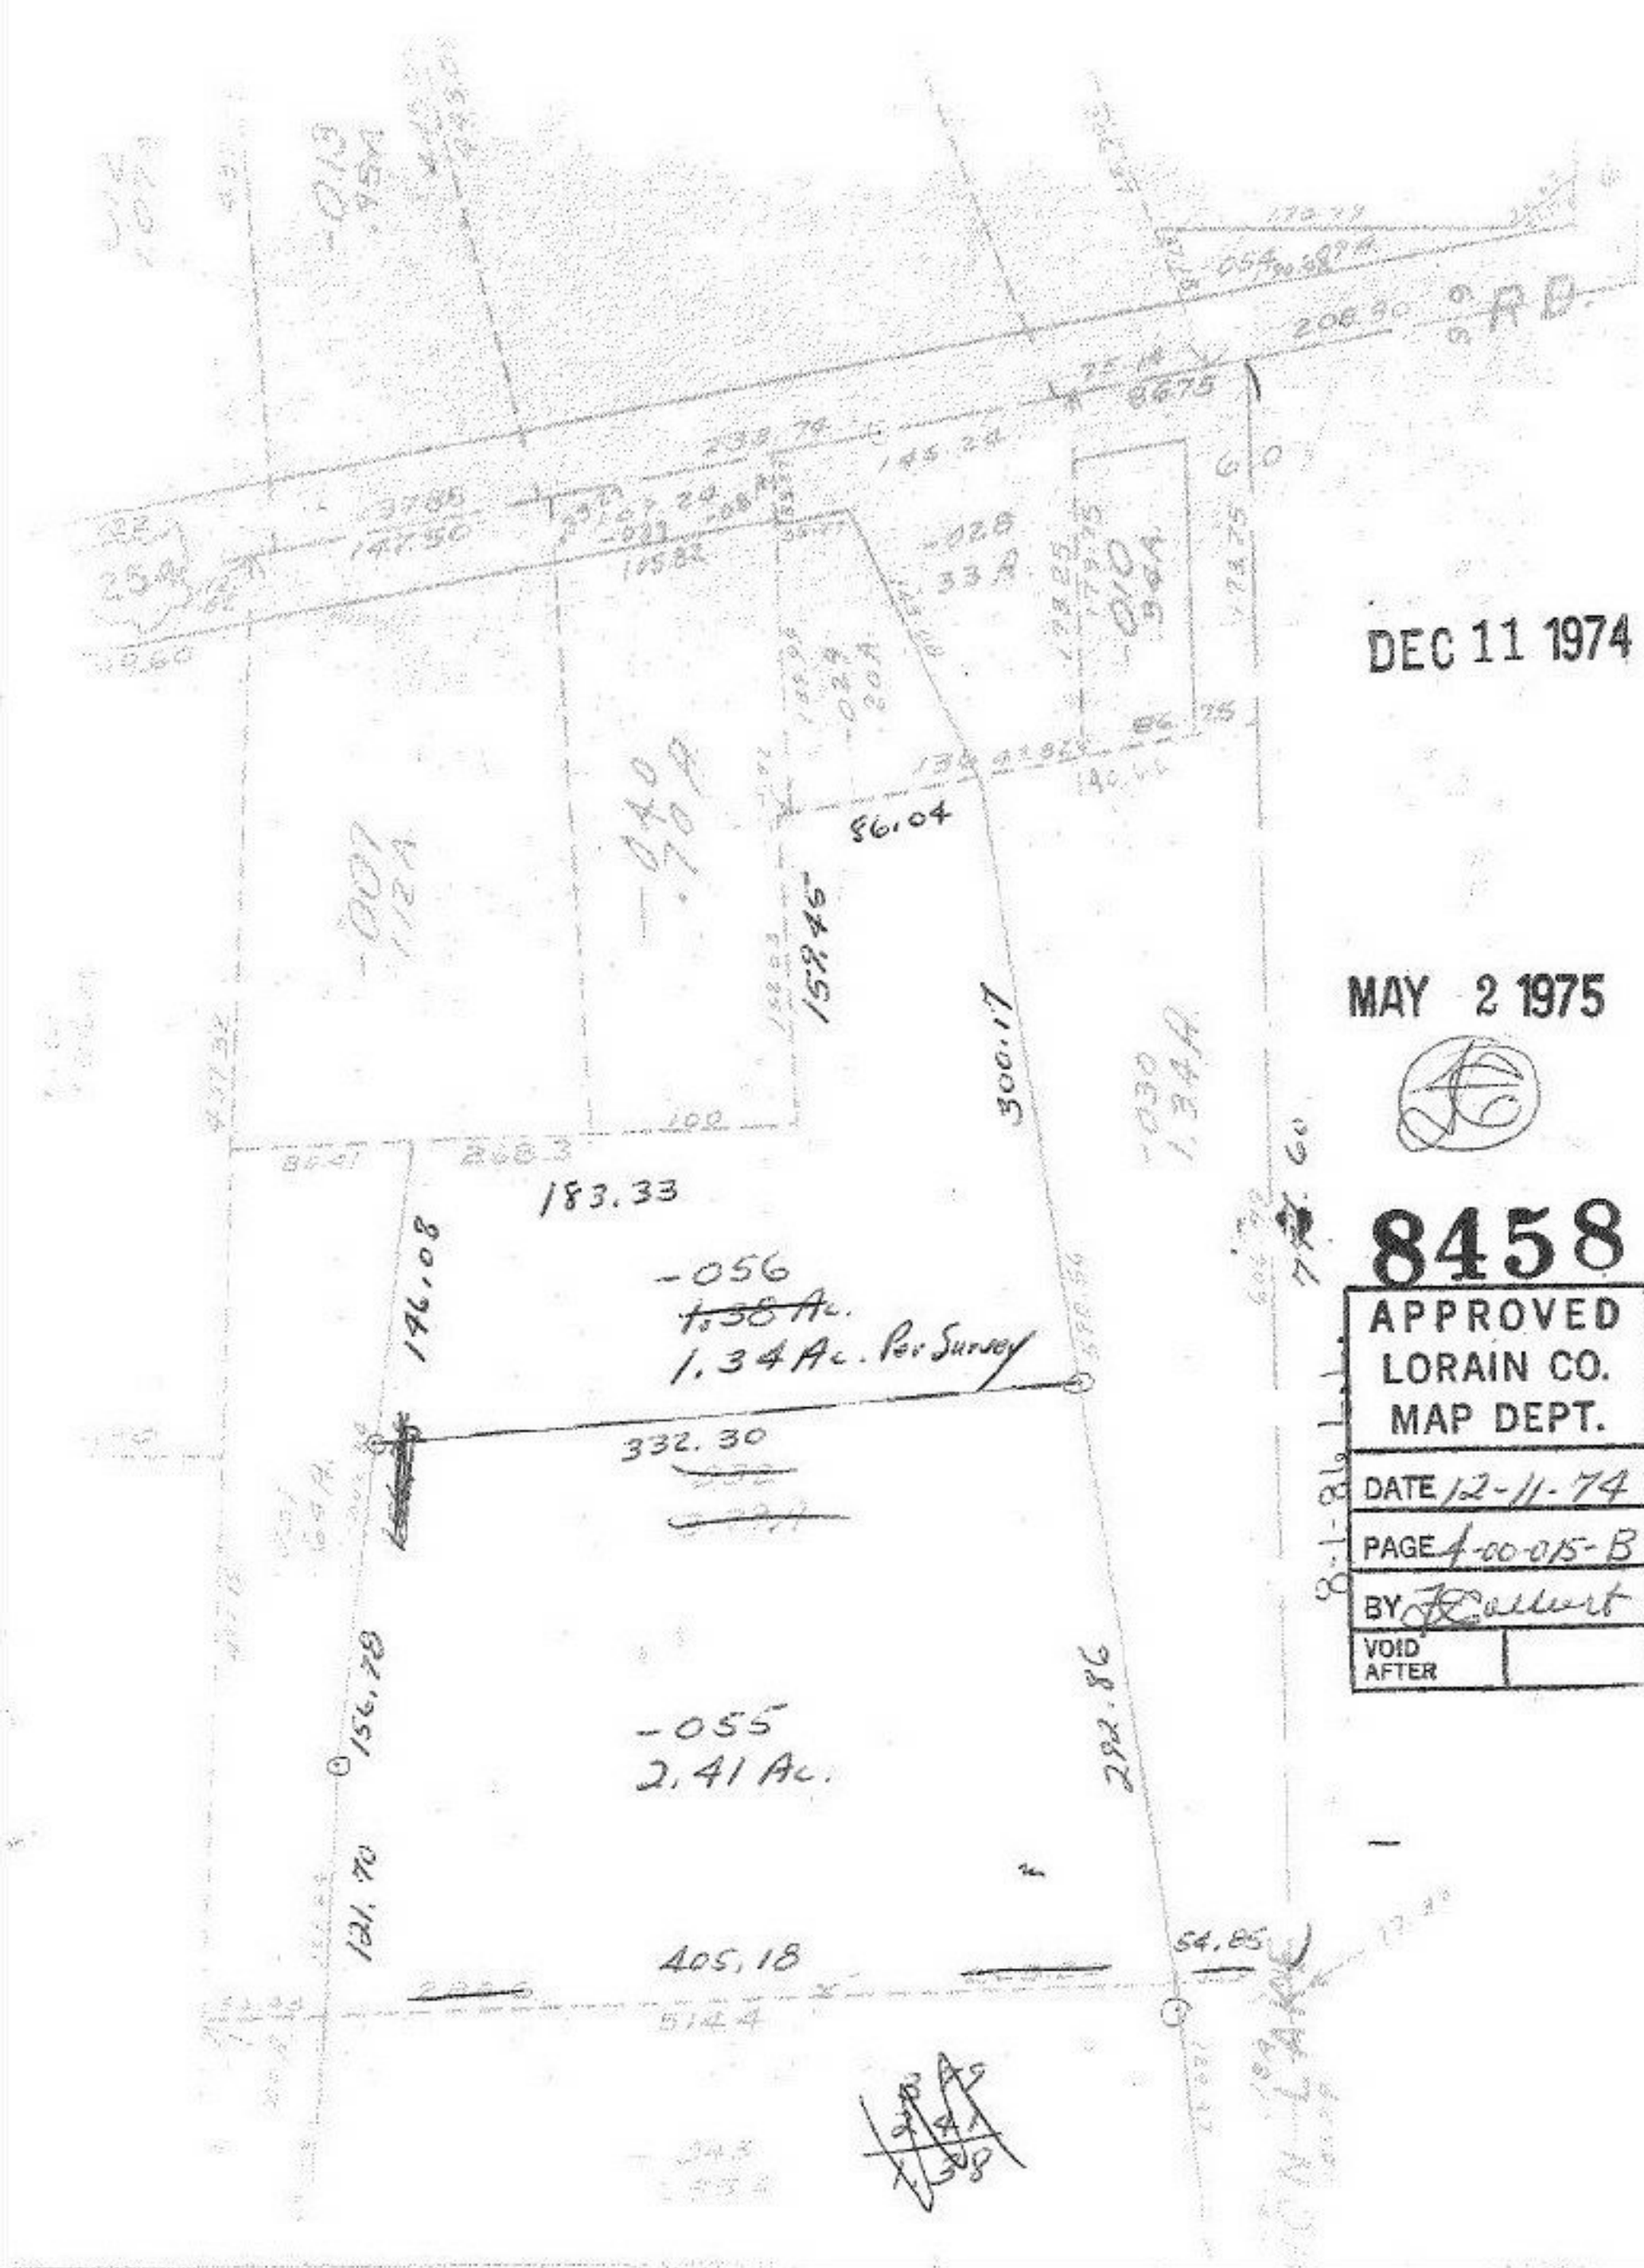

DEC 11 1974

MAY 2 1975

8458

APPROVED
LORAIN CO.
MAP DEPT.

DATE 12-11-74

PAGE 4-00-015-B

BY [signature]

VOID AFTER