DEC 20 1974
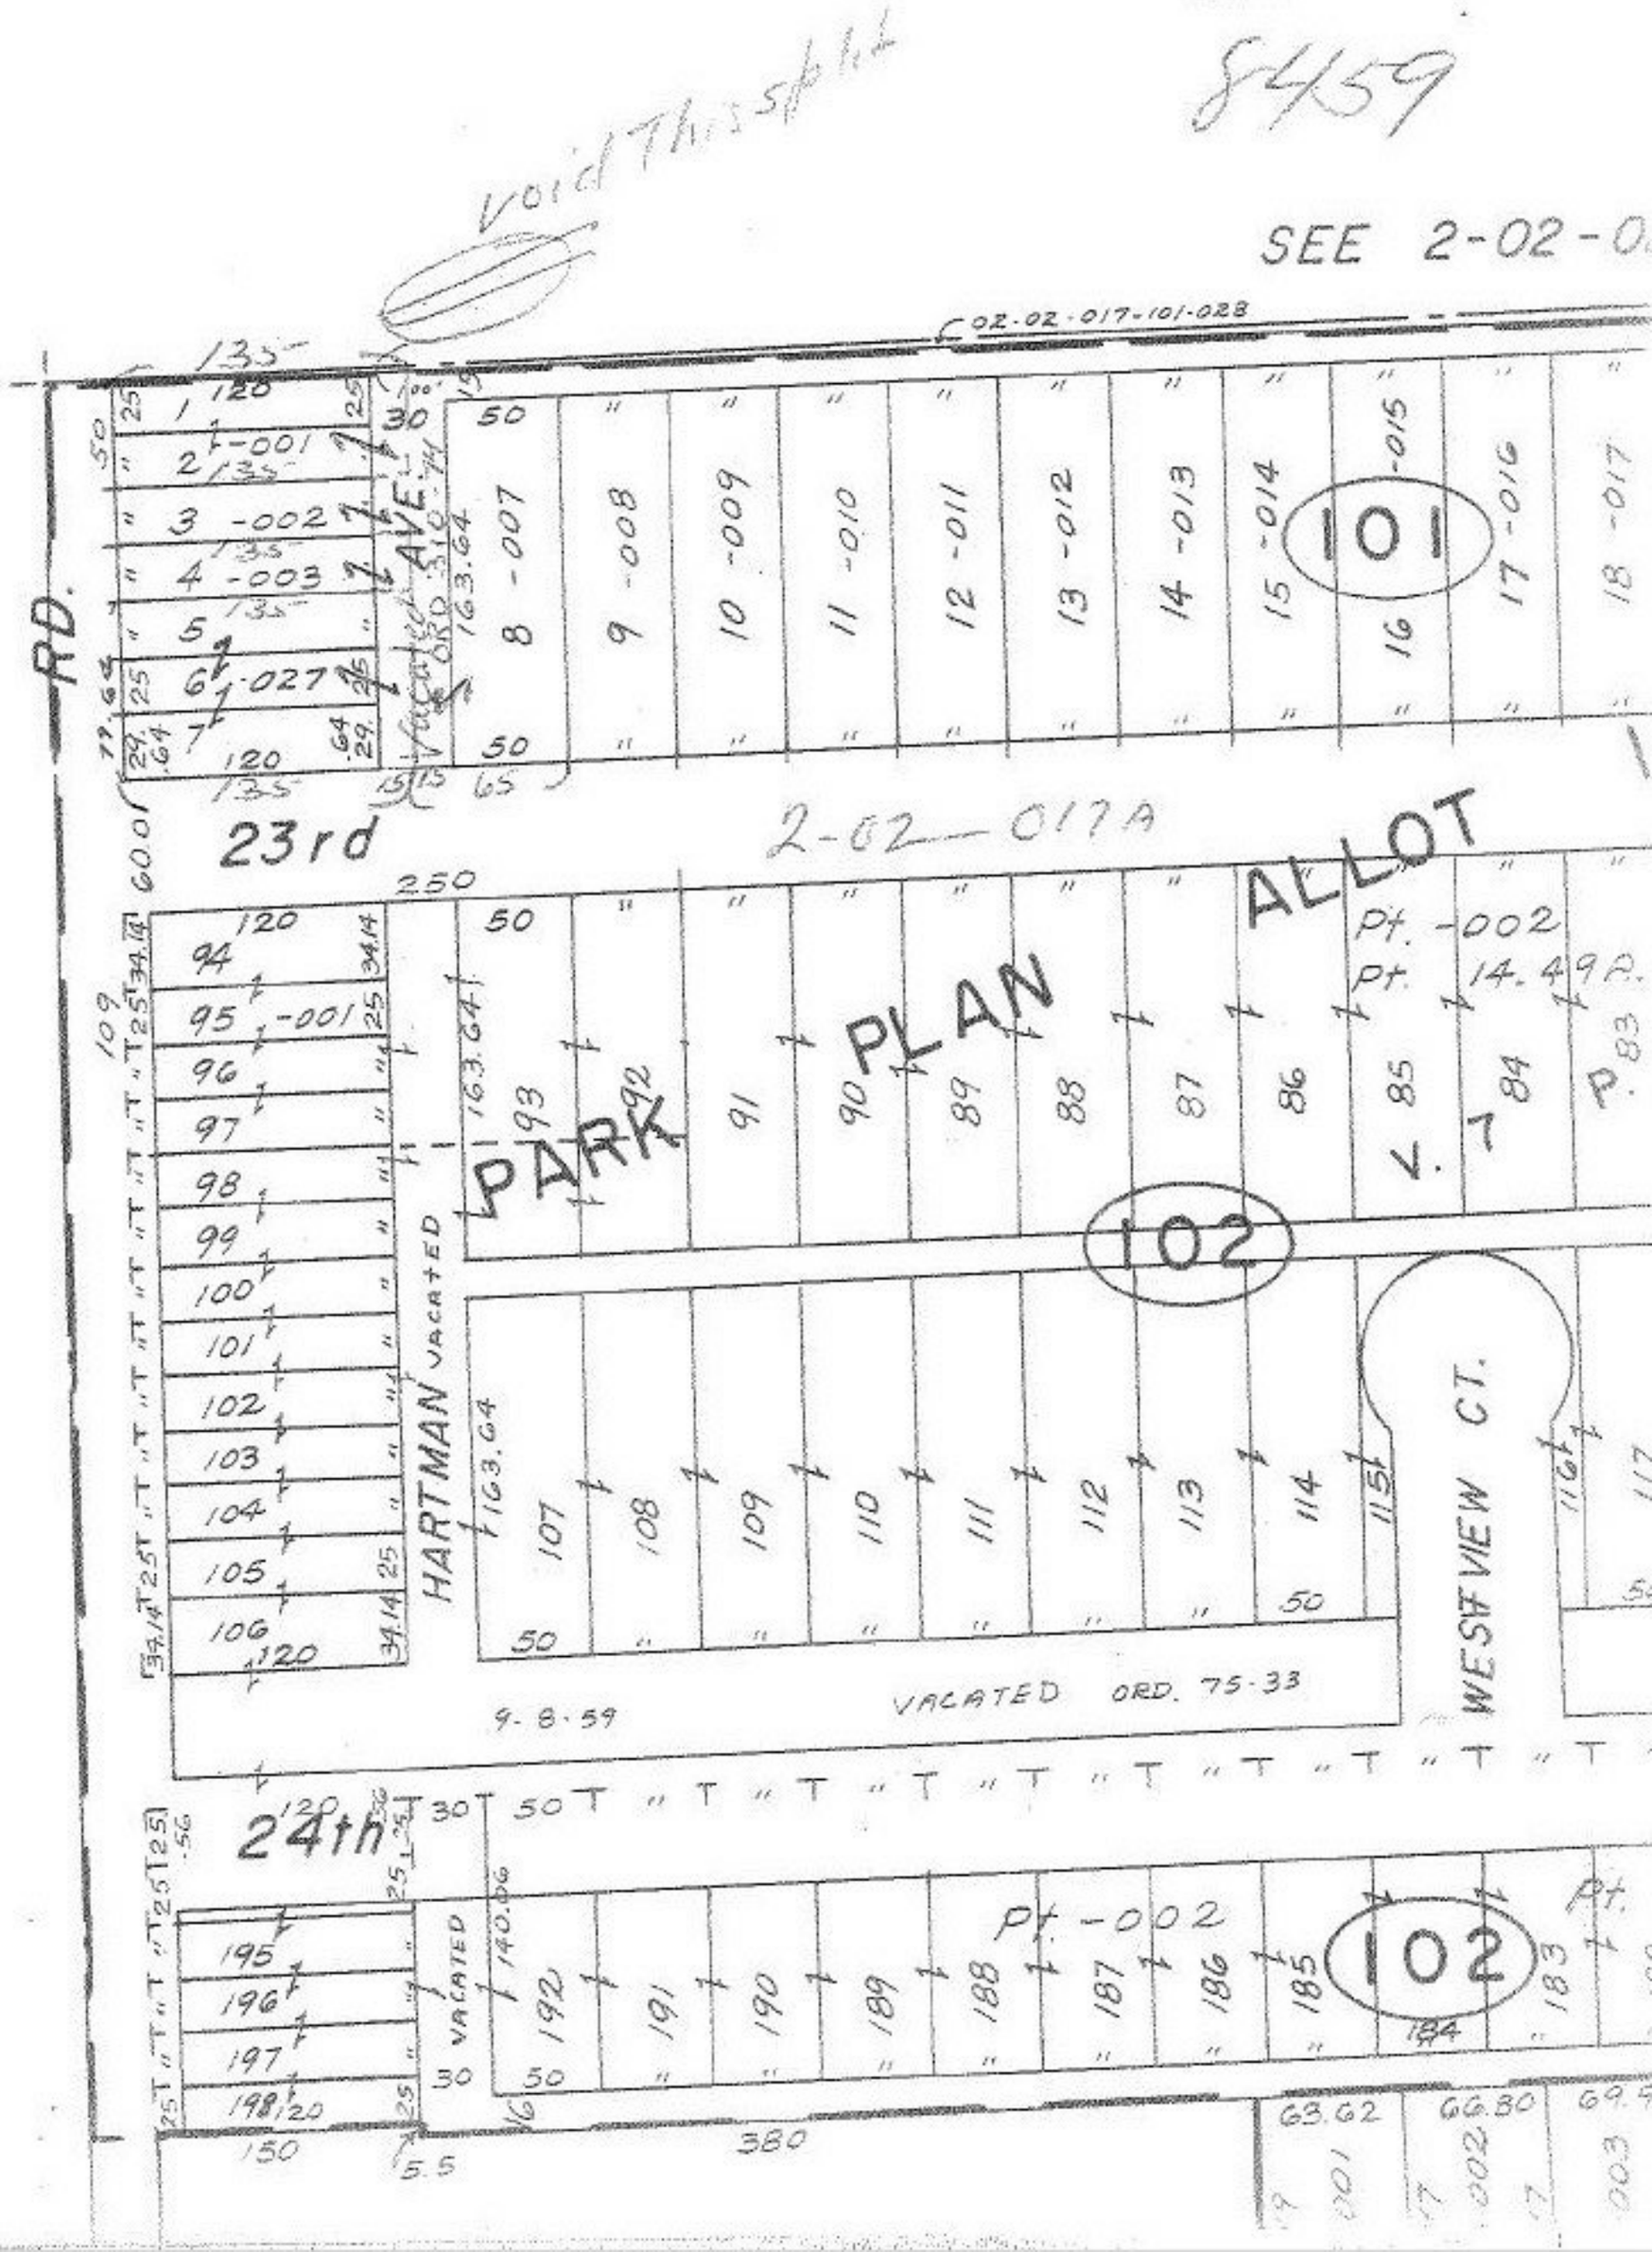
8459