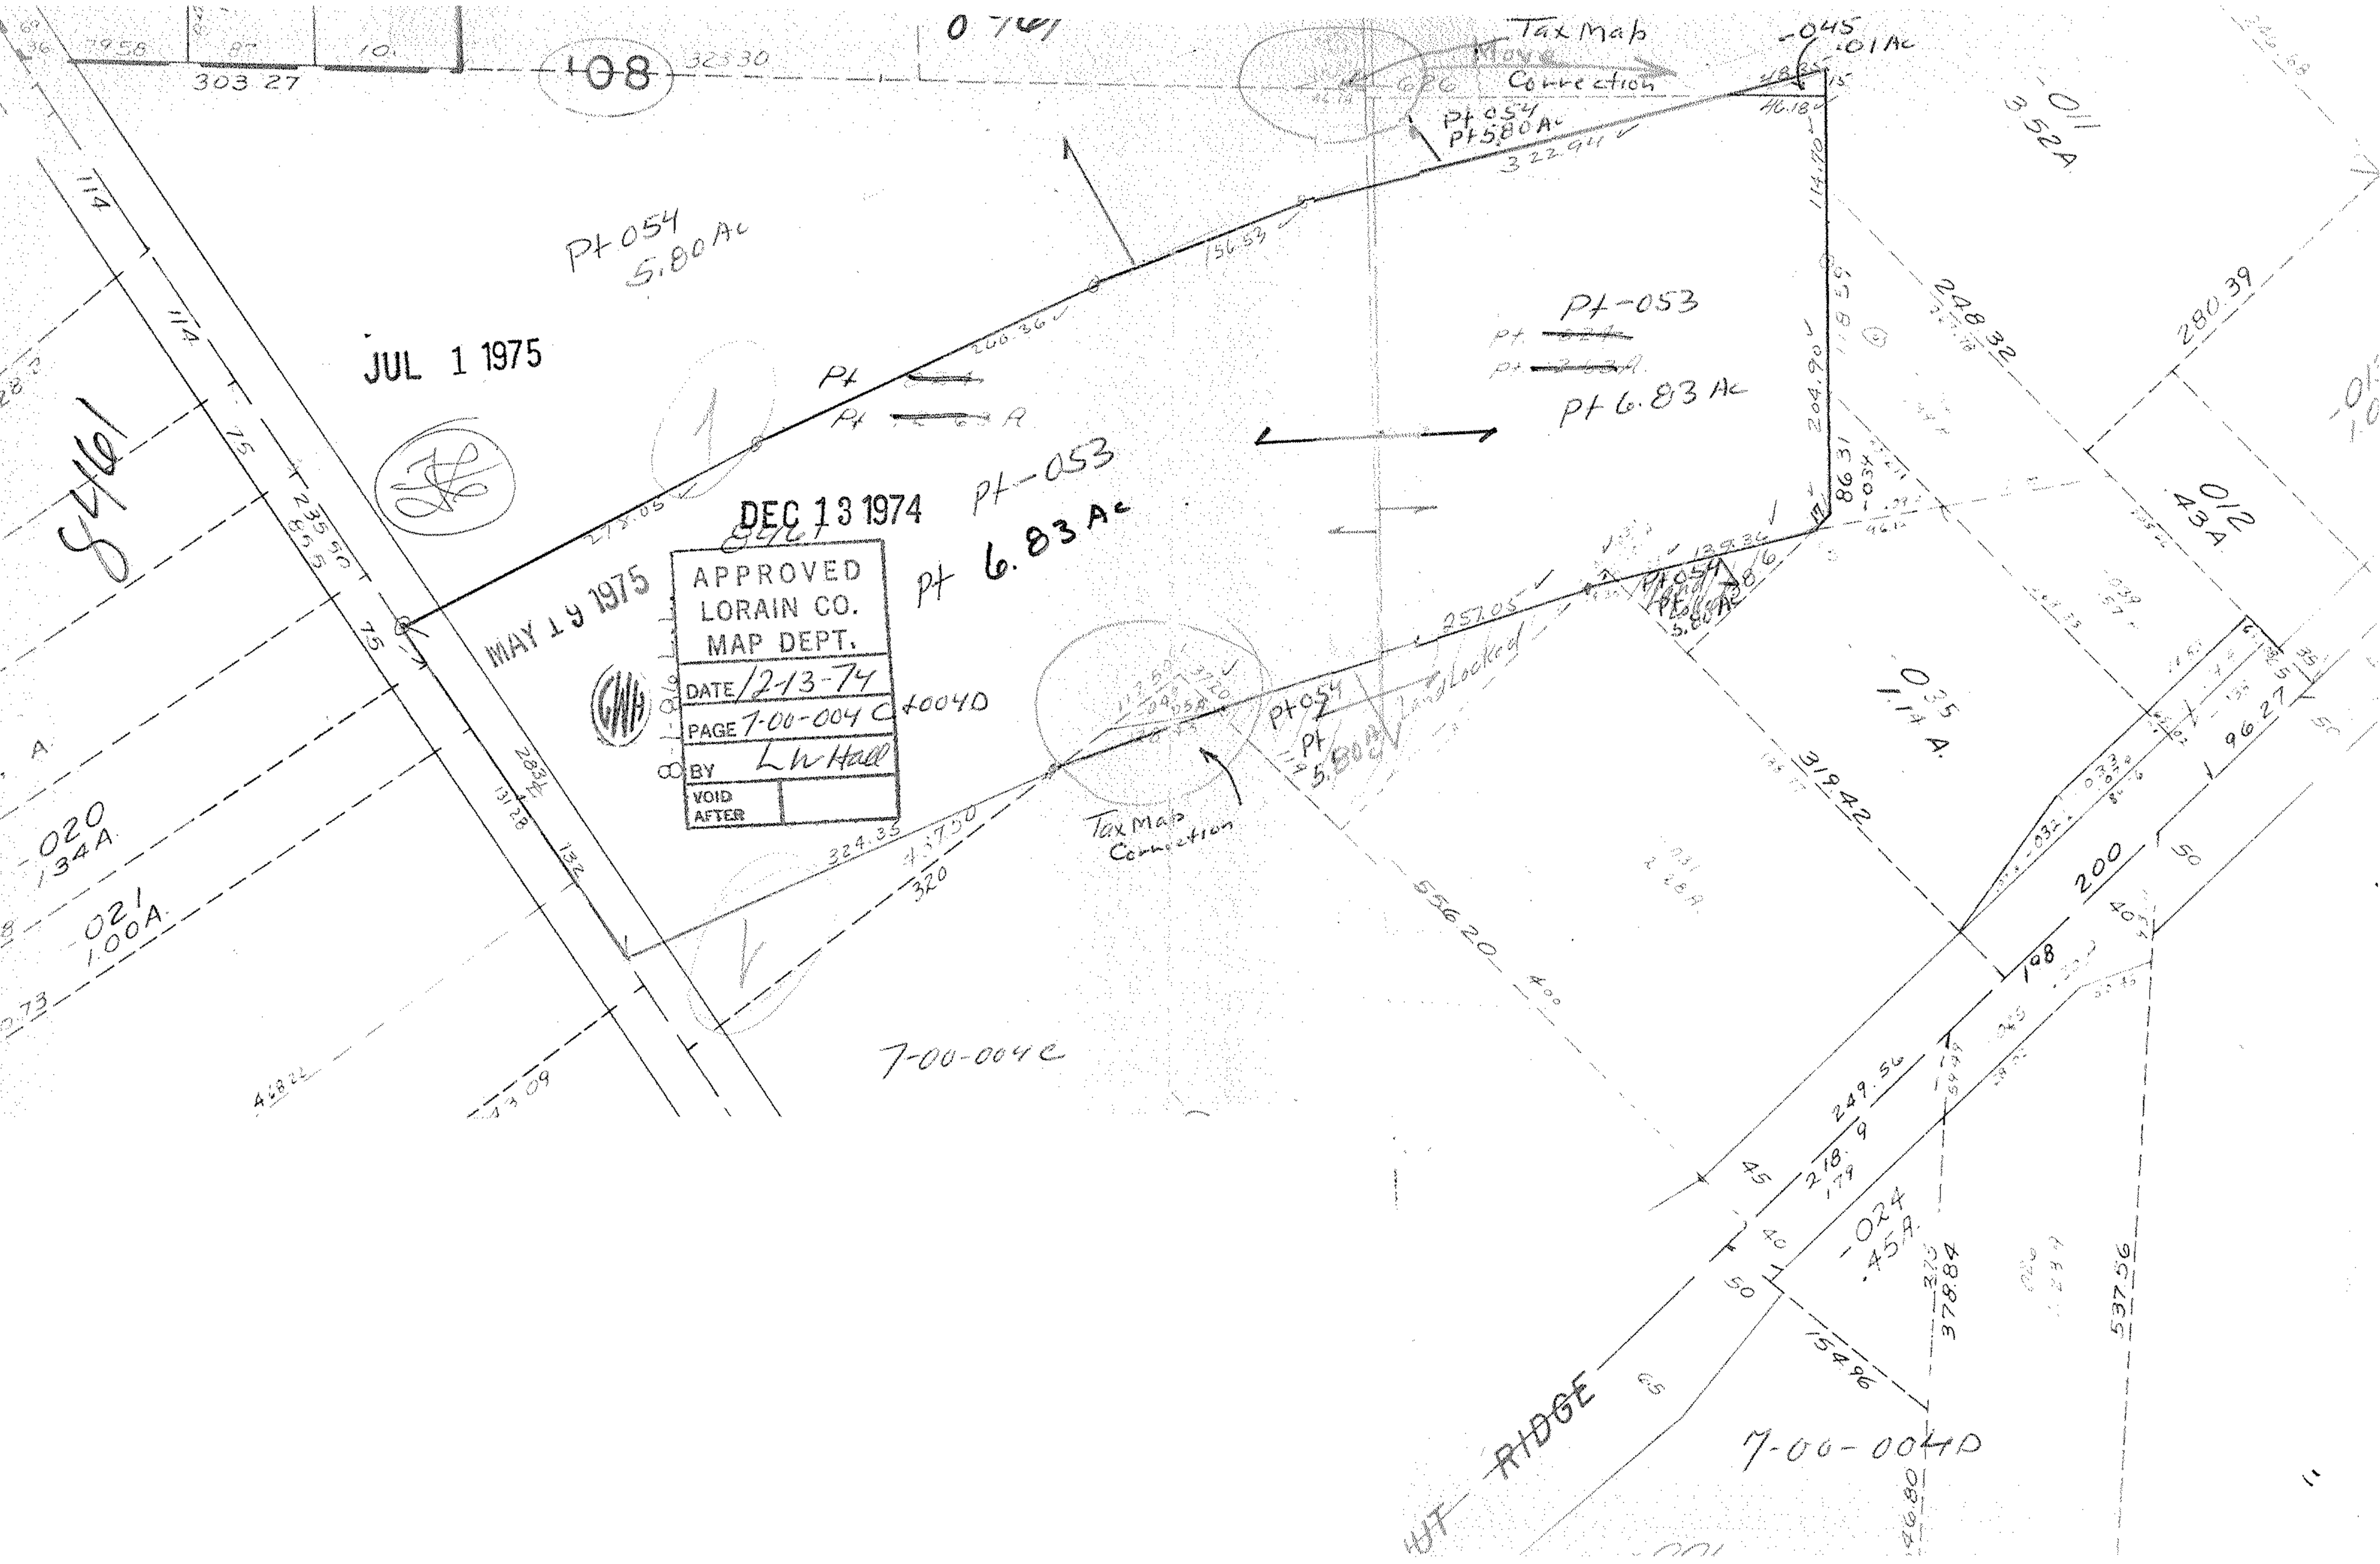

Tax Map Correction
Pt 054
Pt 5.80 Ac
Pt 054
5.80 Ac
JUL 1 1975
DEC 13 1974
MAY 19 1975
Pt-053
Pt 6.83 Ac
Pt-053
Pt 6.83 Ac
APPROVED
LORAIN CO.
MAP DEPT.
DATE 12-13-74
PAGE 7-00-004 C
BY L W Hall
VOID AFTER
Tax Map Correction
7-00-004C
7-00-004D
RIDGE