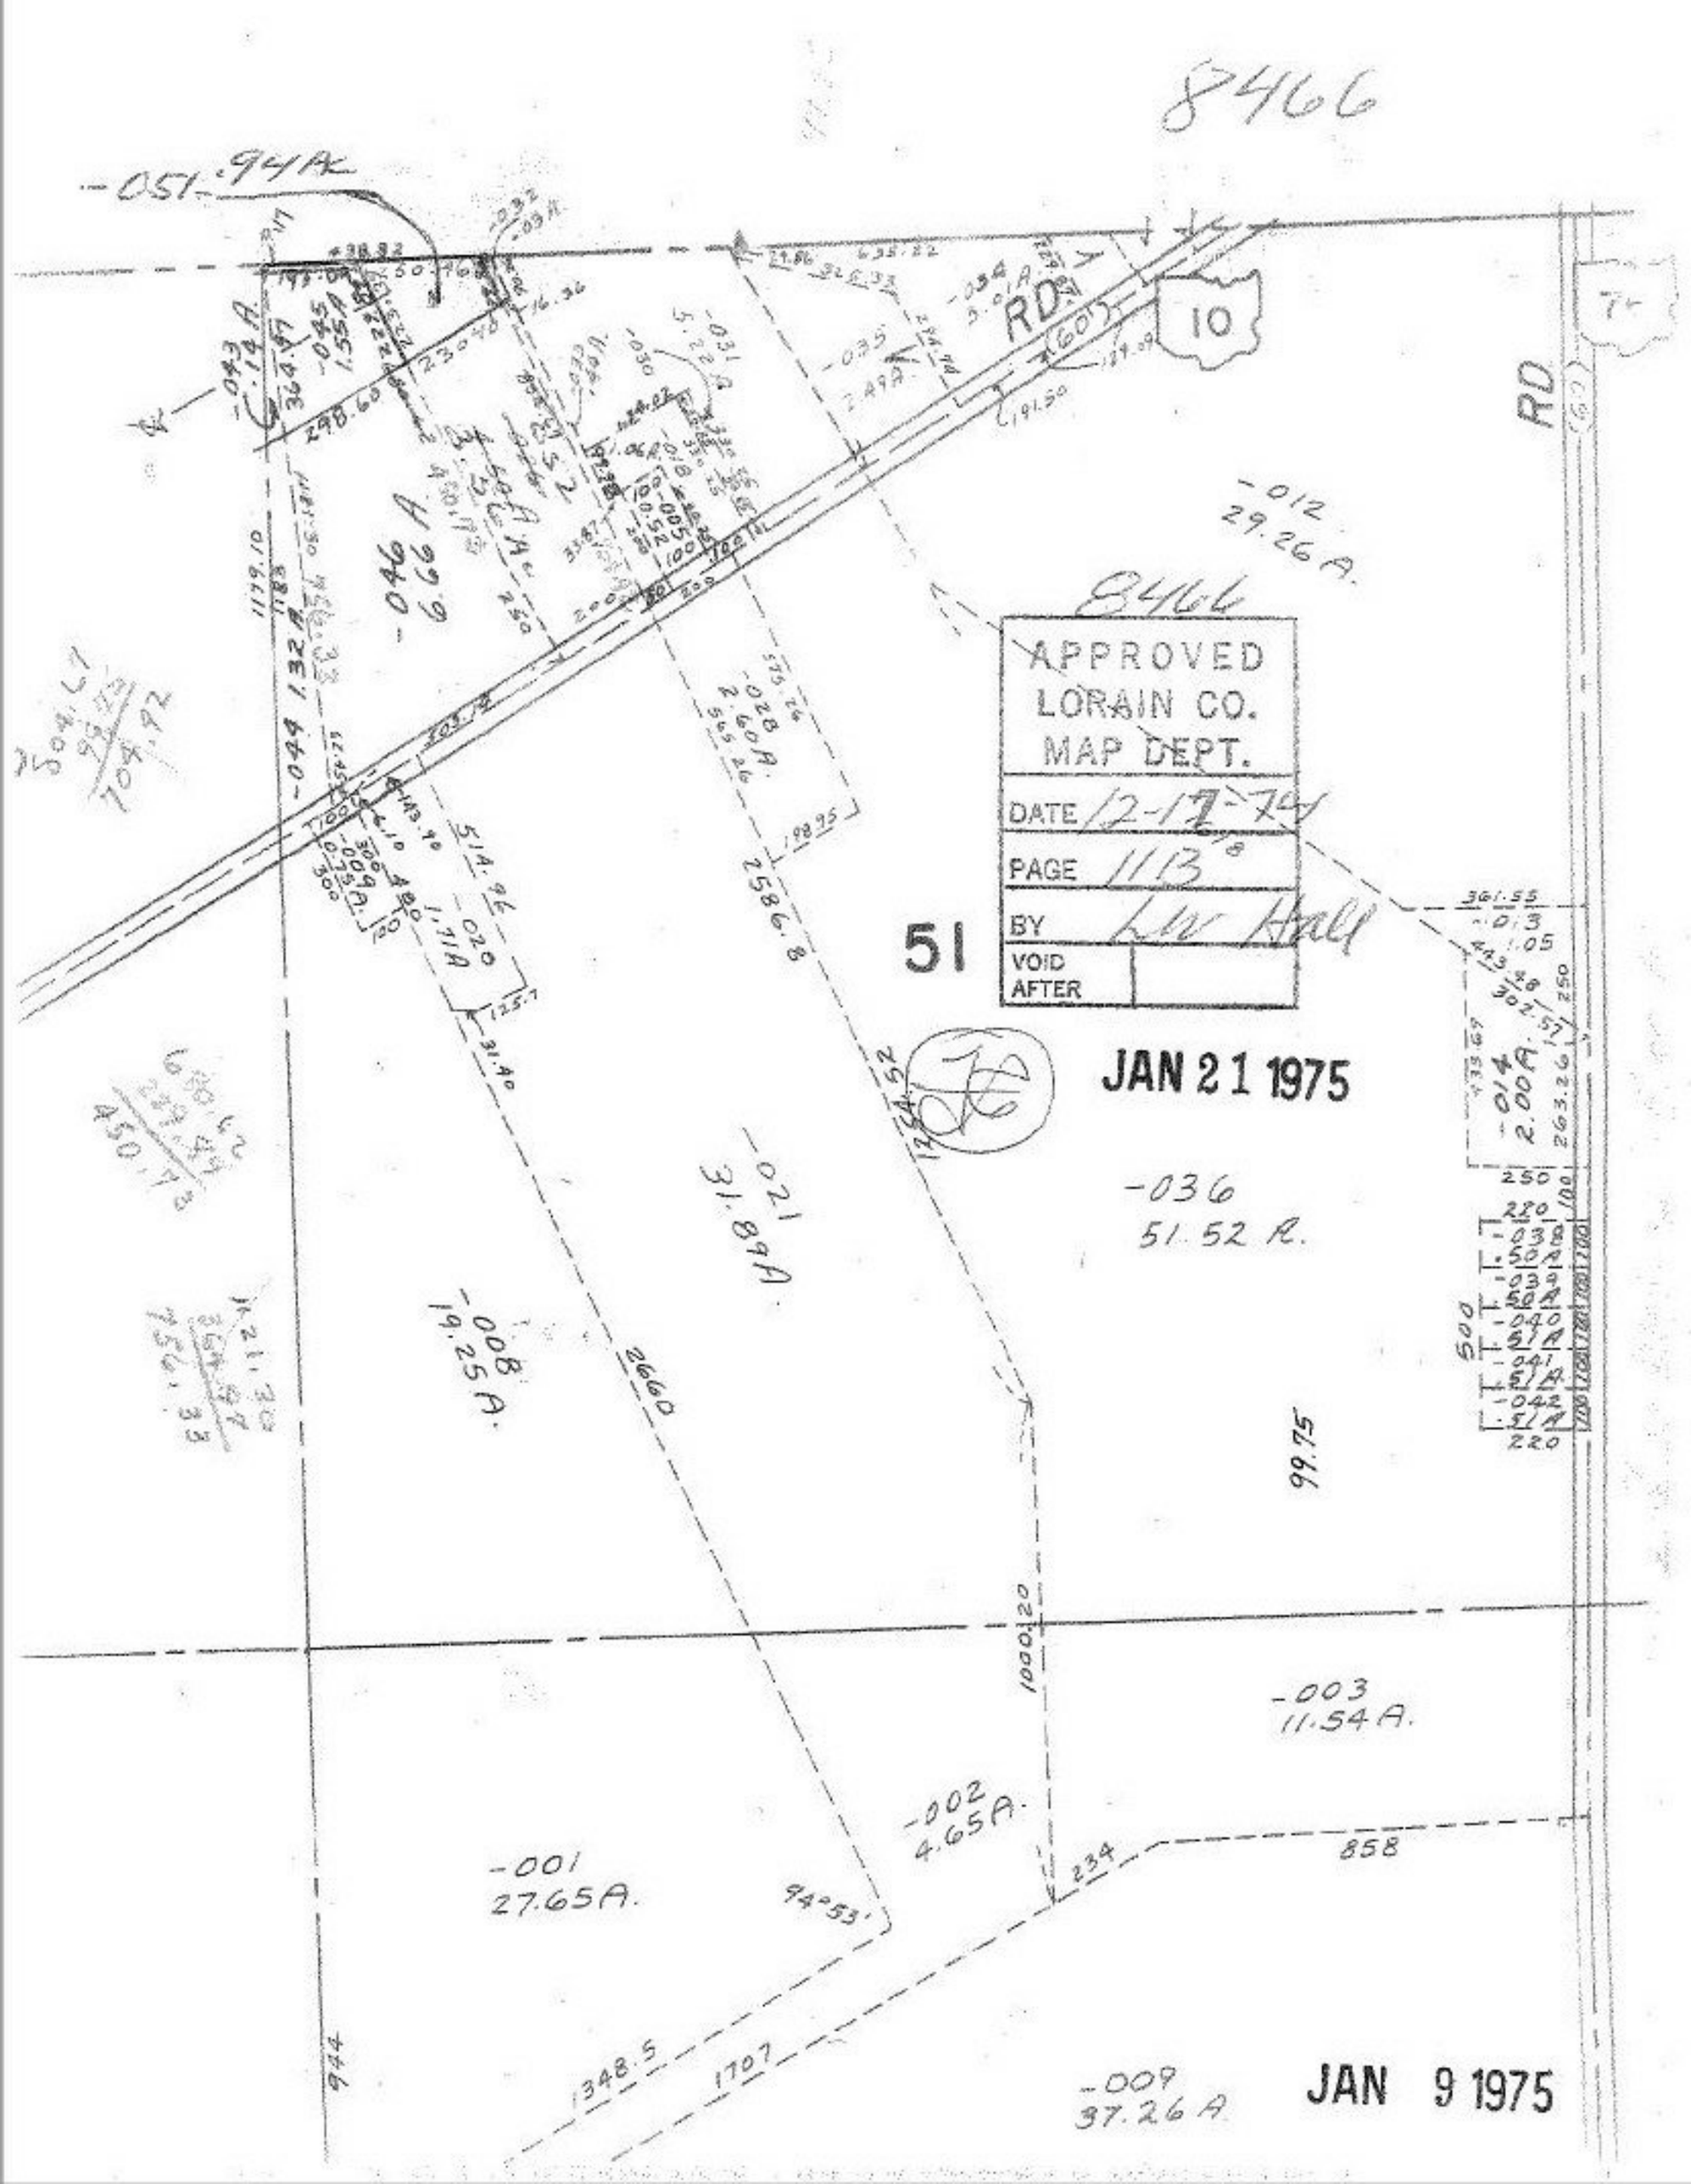
8466
-051 .94 Ac
RD
10
-012
29.26 A.
8466
APPROVED
LORAIN CO.
MAP DEPT.
DATE 12-17-74
PAGE 1113
BY Lw Hall
VOID AFTER
51
JAN 21 1975
-036
51.52 A.
-021
31.89 A.
-008
19.25 A.
2660
99.75
-003
11.54 A.
-002
4.65 A.
-001
27.65 A.
858
234
944
1348.5
1707
-009
37.26 A.
JAN 9 1975