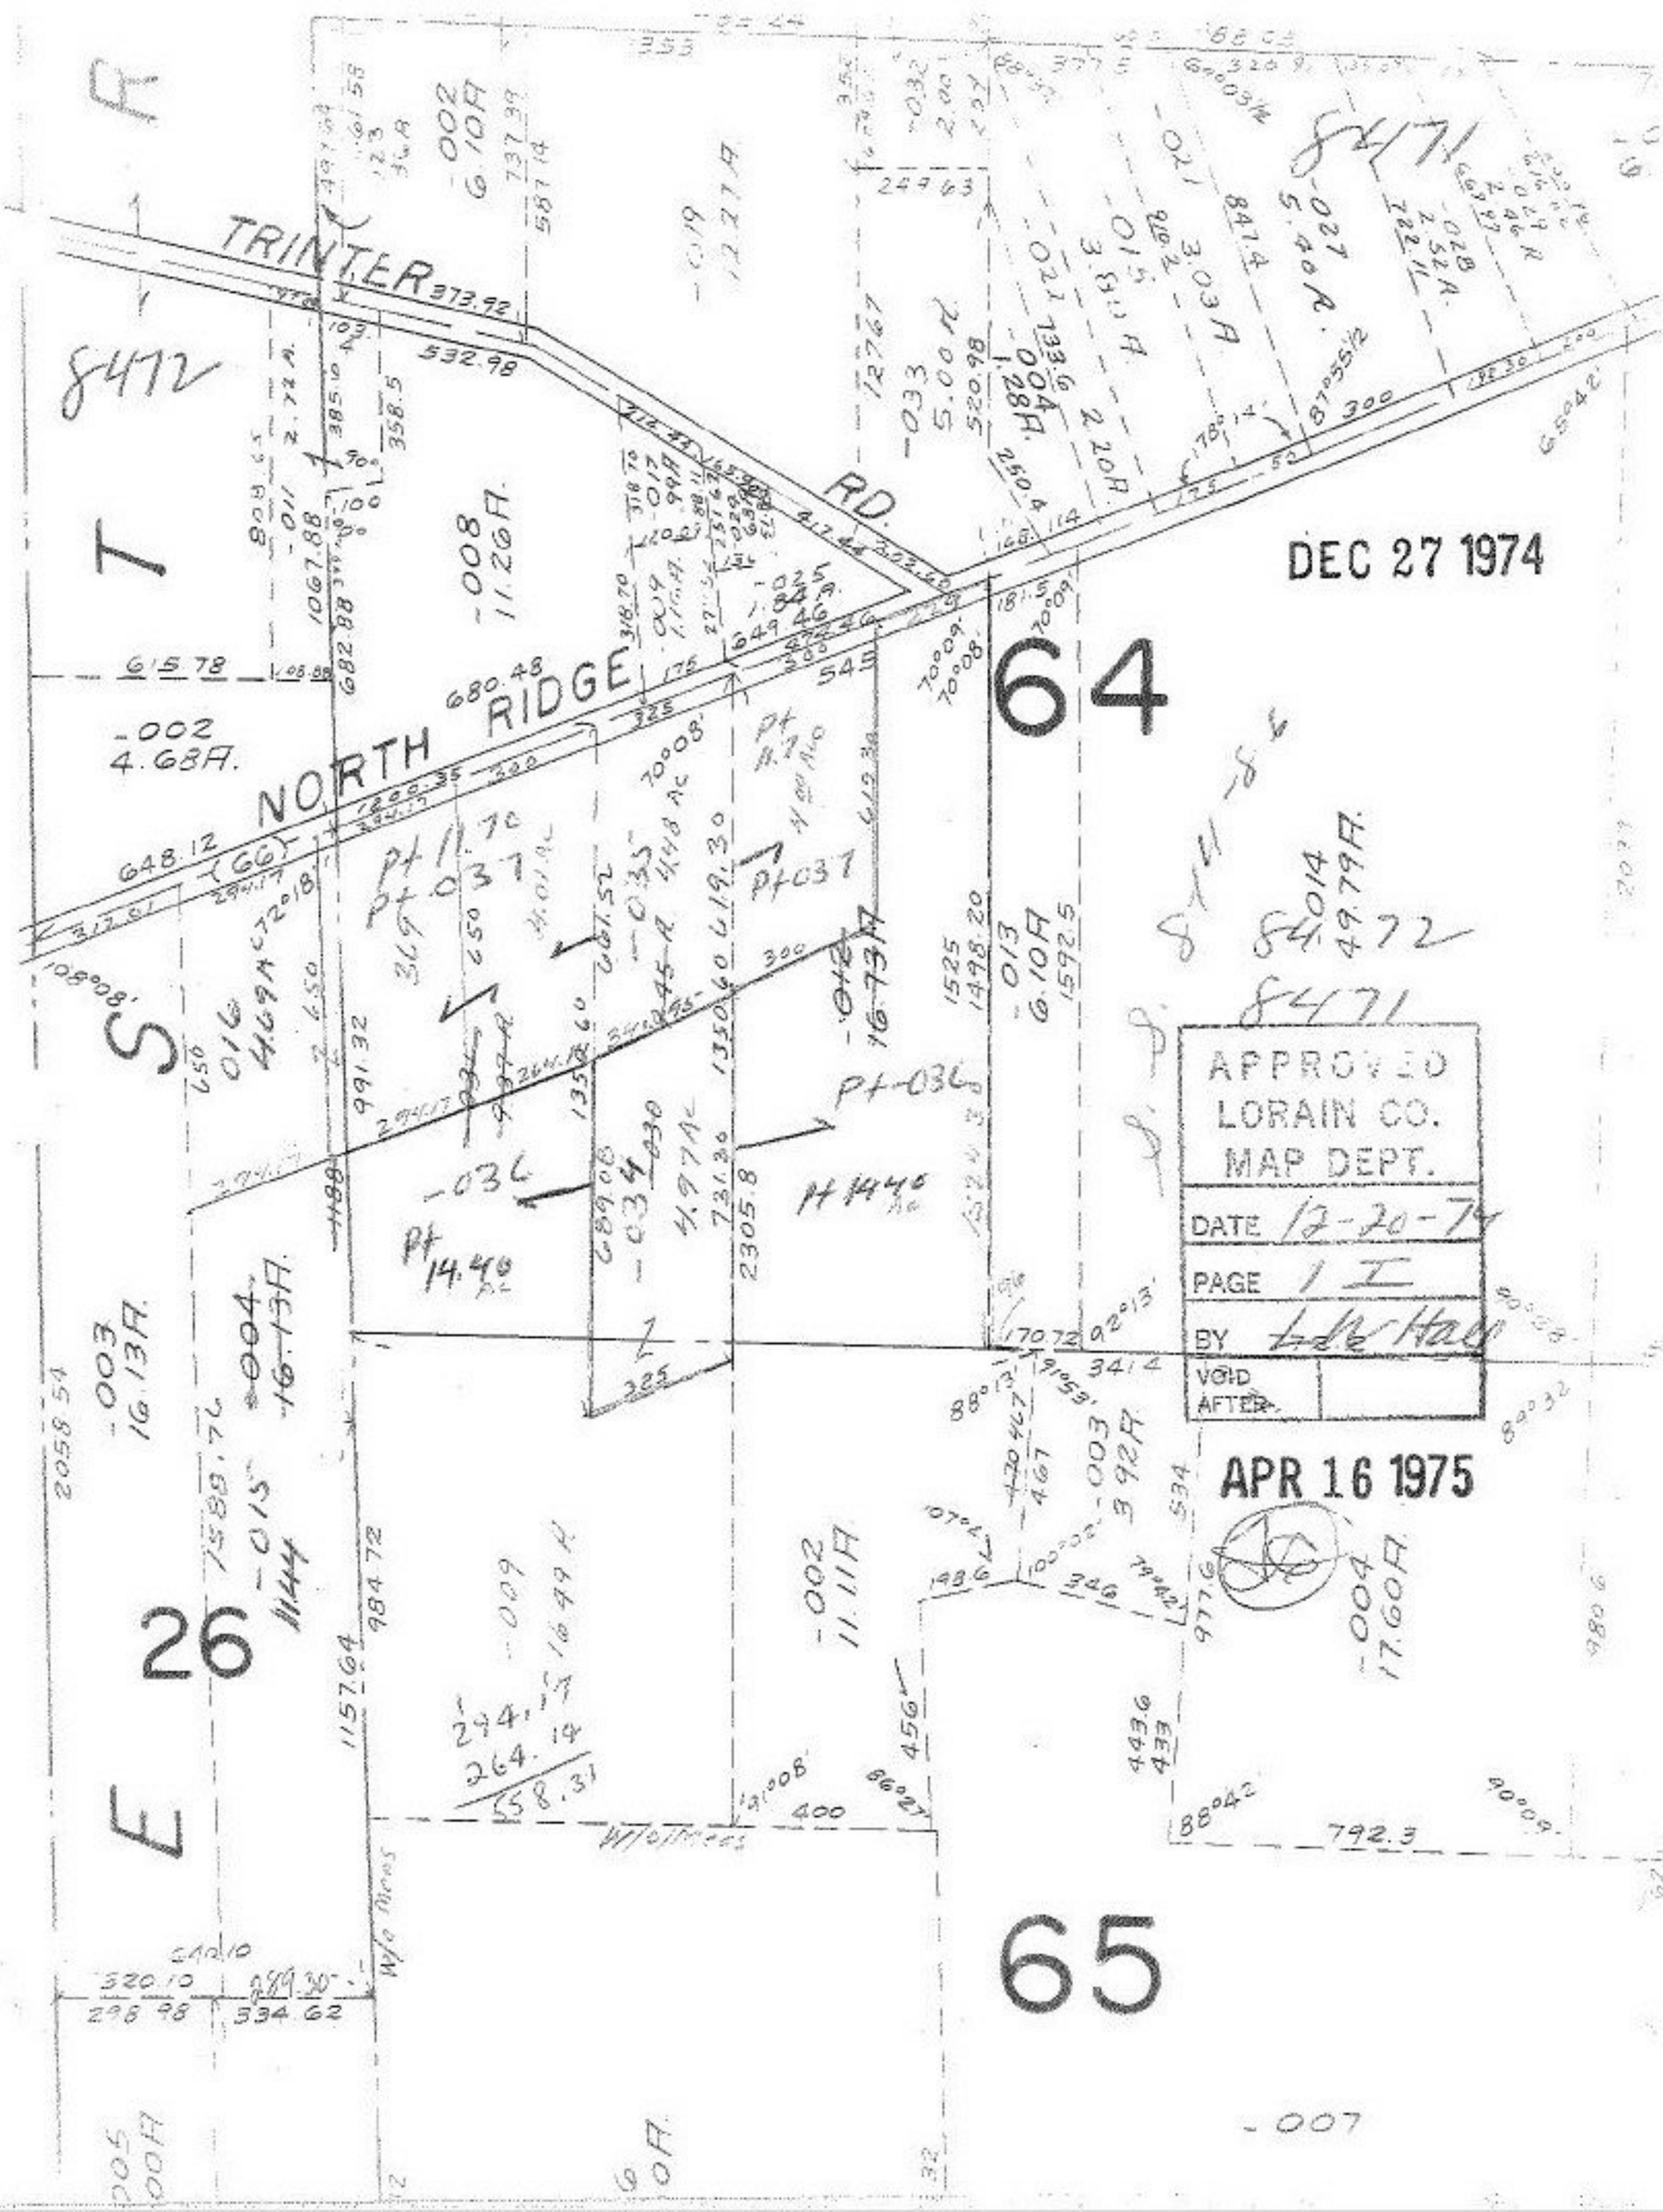

TRINTER RD.
NORTH RIDGE
64
65
26
8472
8471
DEC 27 1974
APR 16 1975
APPROVED
LORAIN CO.
MAP DEPT.
DATE 12-20-74
PAGE 1 I
BY
VOID AFTER