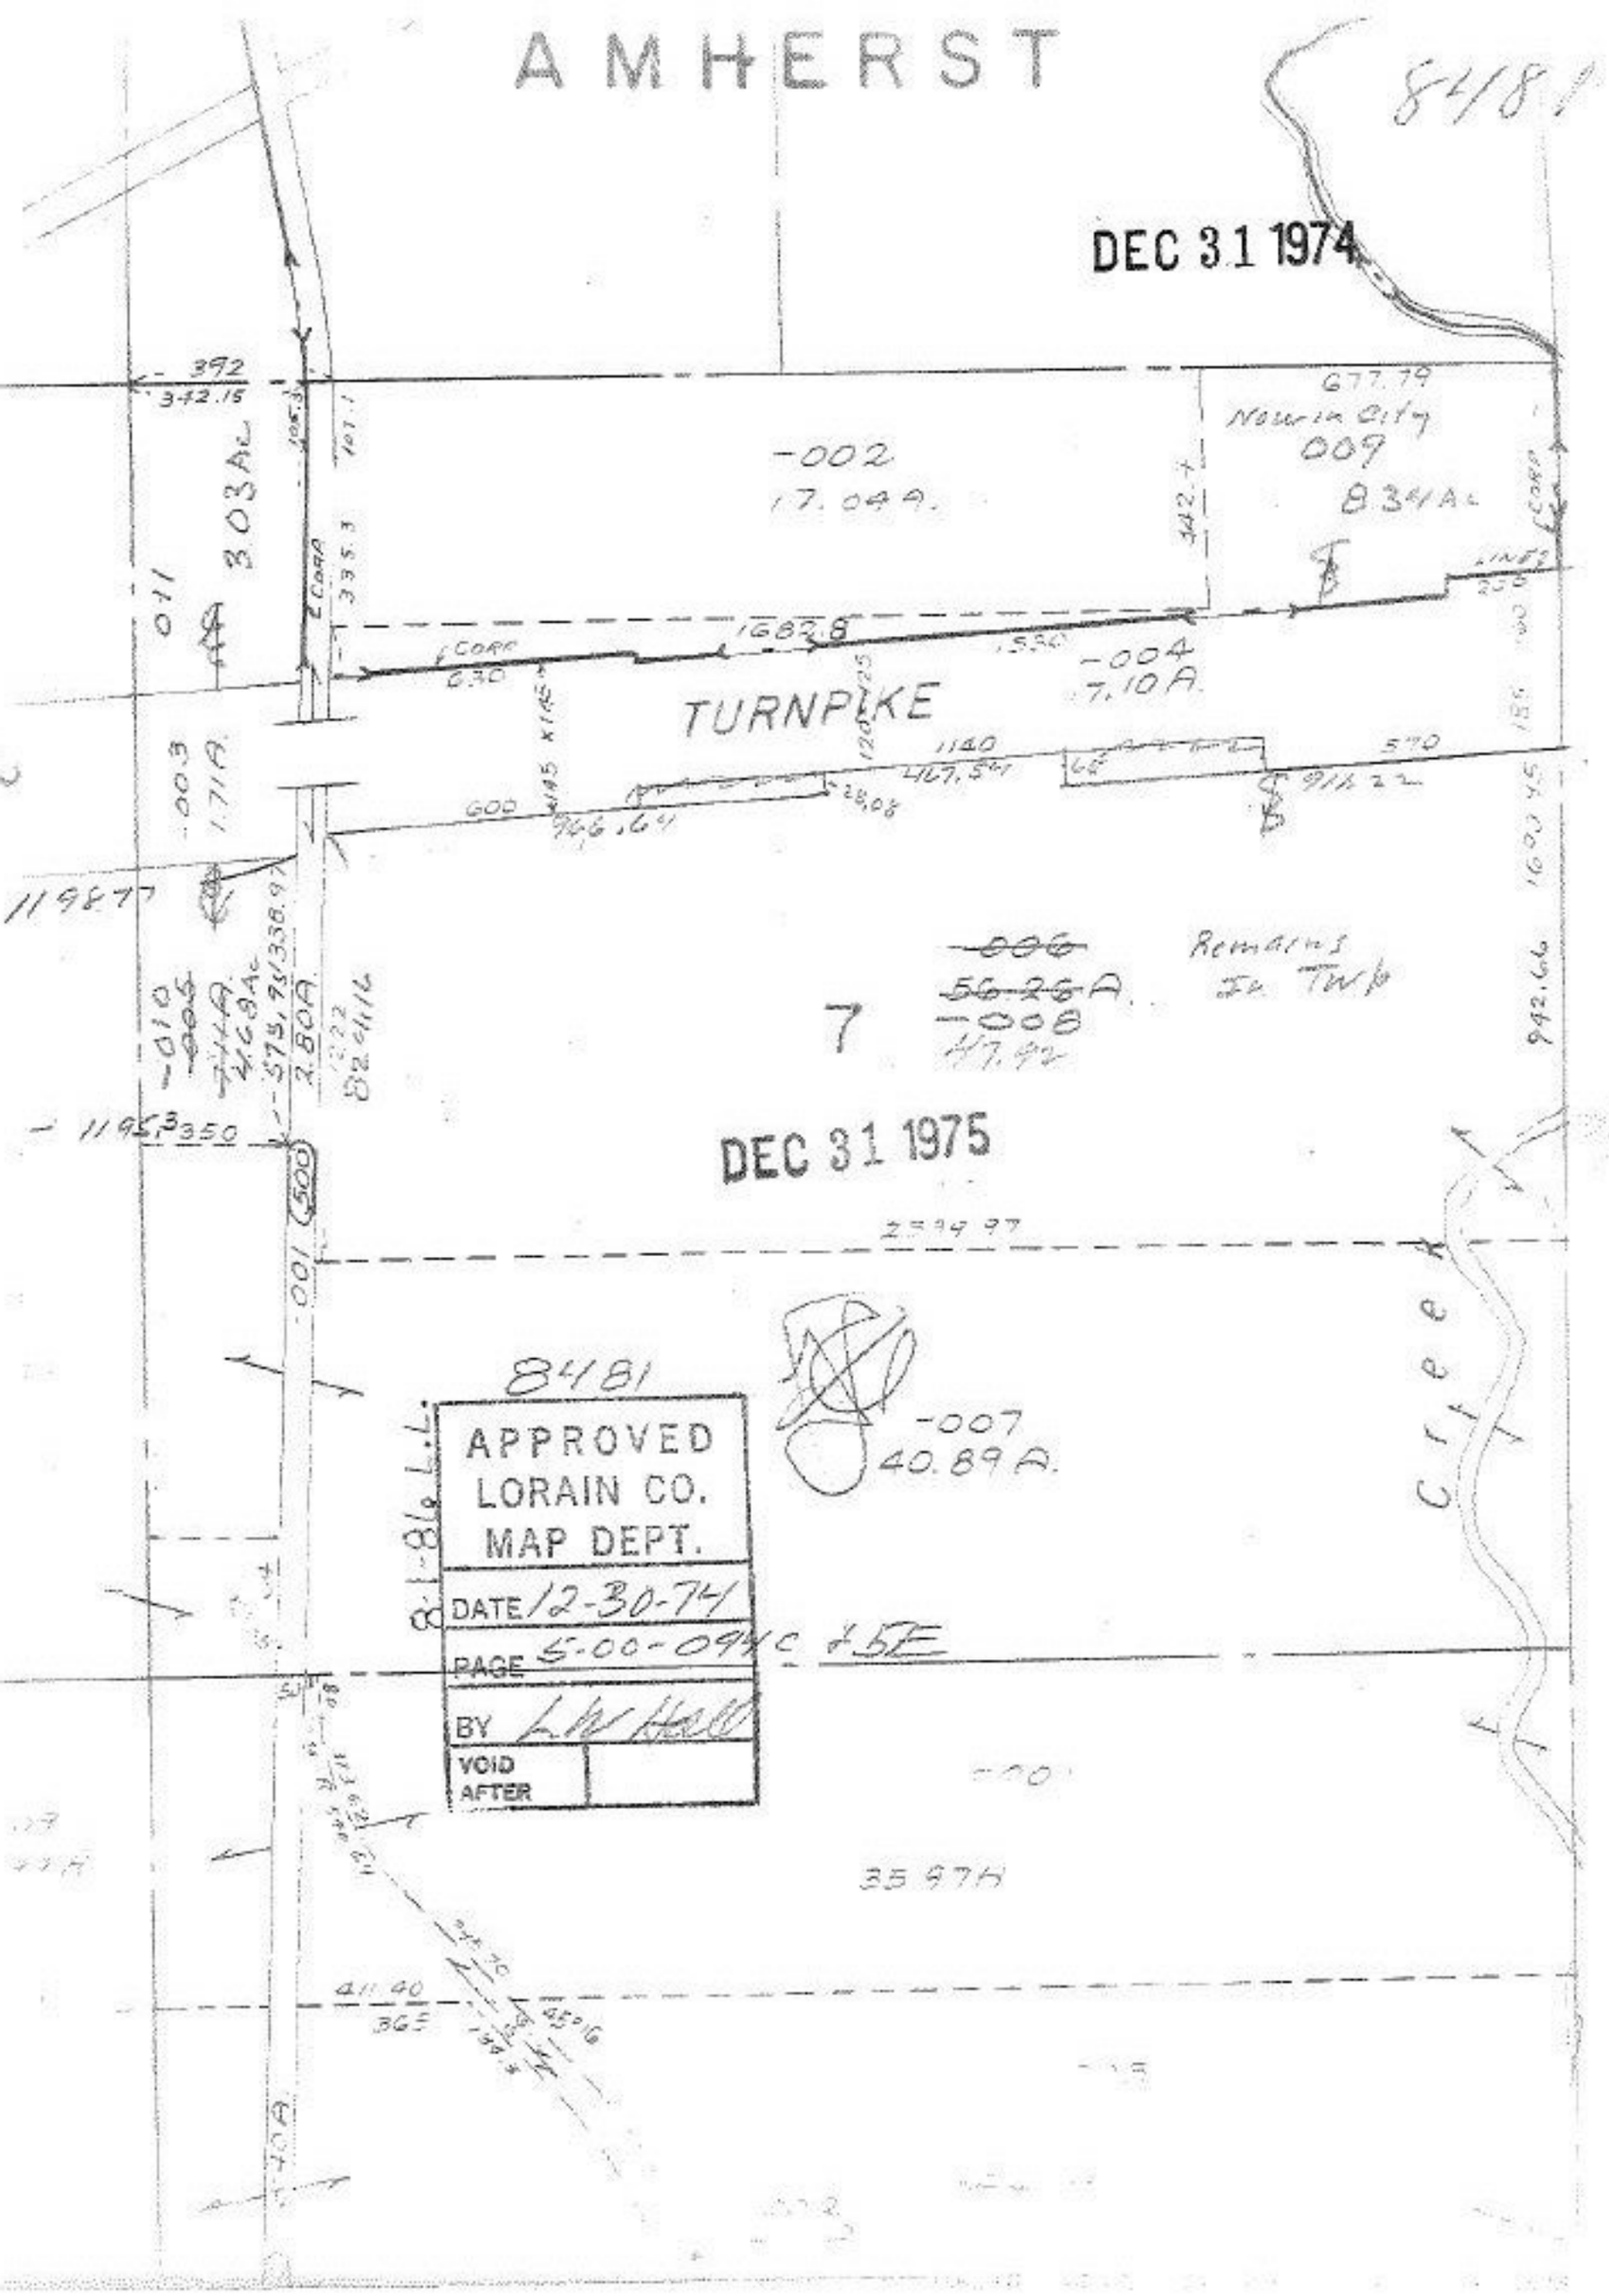
AMHERST
8481
DEC 31 1974
392
342.15
677.79
Now in City
009
8.34 Ac
-002
17.04 A.
3.03 Ac
011
1682.8
-004
7.10 A.
TURNPIKE
1140
467.54
570
600
966.64
28.08
-003
1.71 A.
1198.77
-006
56.26 A.
-008
47.92
Remains In Twp
7
942.66
-010
2.80 A.
1195.3
350
DEC 31 1975
500
2539.97
-001
8481
APPROVED
LORAIN CO.
MAP DEPT.
DATE 12-30-74
PAGE 5-00-094C & 5E
BY L.W. Hall
VOID AFTER
-007
40.89 A.
Creek
35.97 A
411.40
365
45°16