

SEE 5-00-020-A

1619.90

COOPER-FOSTER

PARK

SEE 5-00-019-B


~~005~~
~~51.00~~
022
56.45 AC

022
56.45 AC

8489

8489	
APPROVED	
LORAN CO.	
MAP DEPT.	
DATE	1-3-75
PAGE	5-00-020-B
BY	W Hall
VOID	
AFTER	

DEC 31 1975

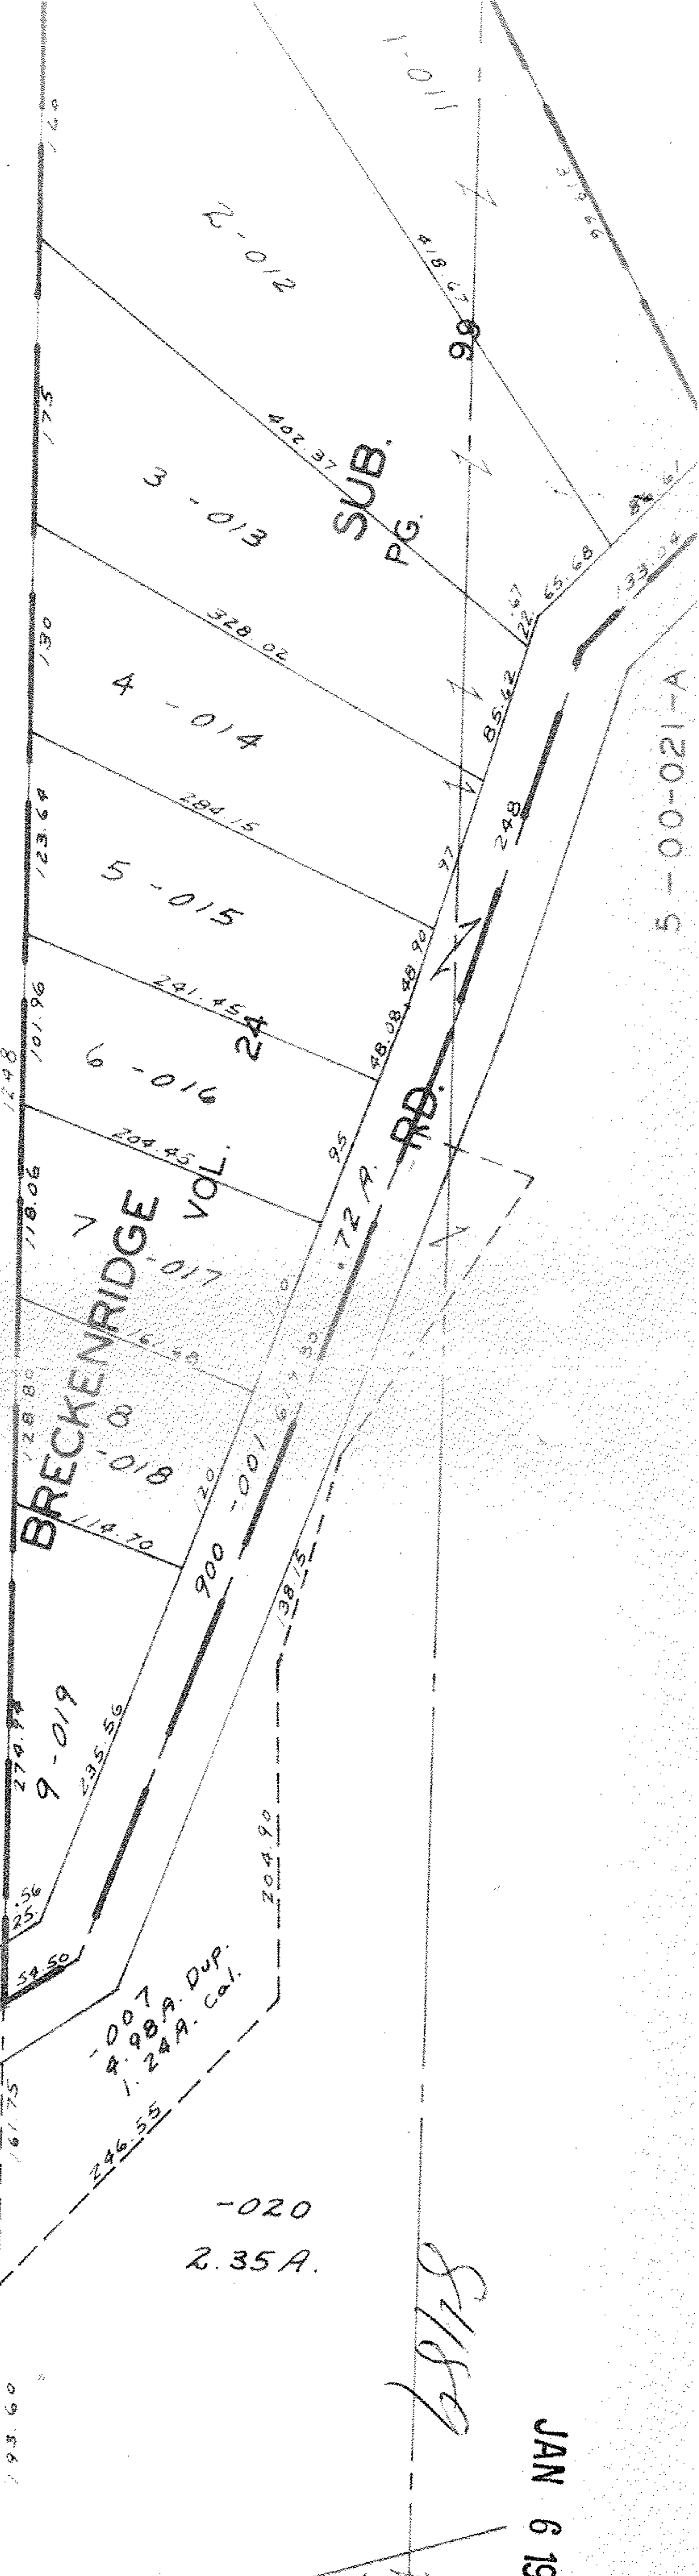

-020
2.35 A.

8489

JAN 6 1975

2