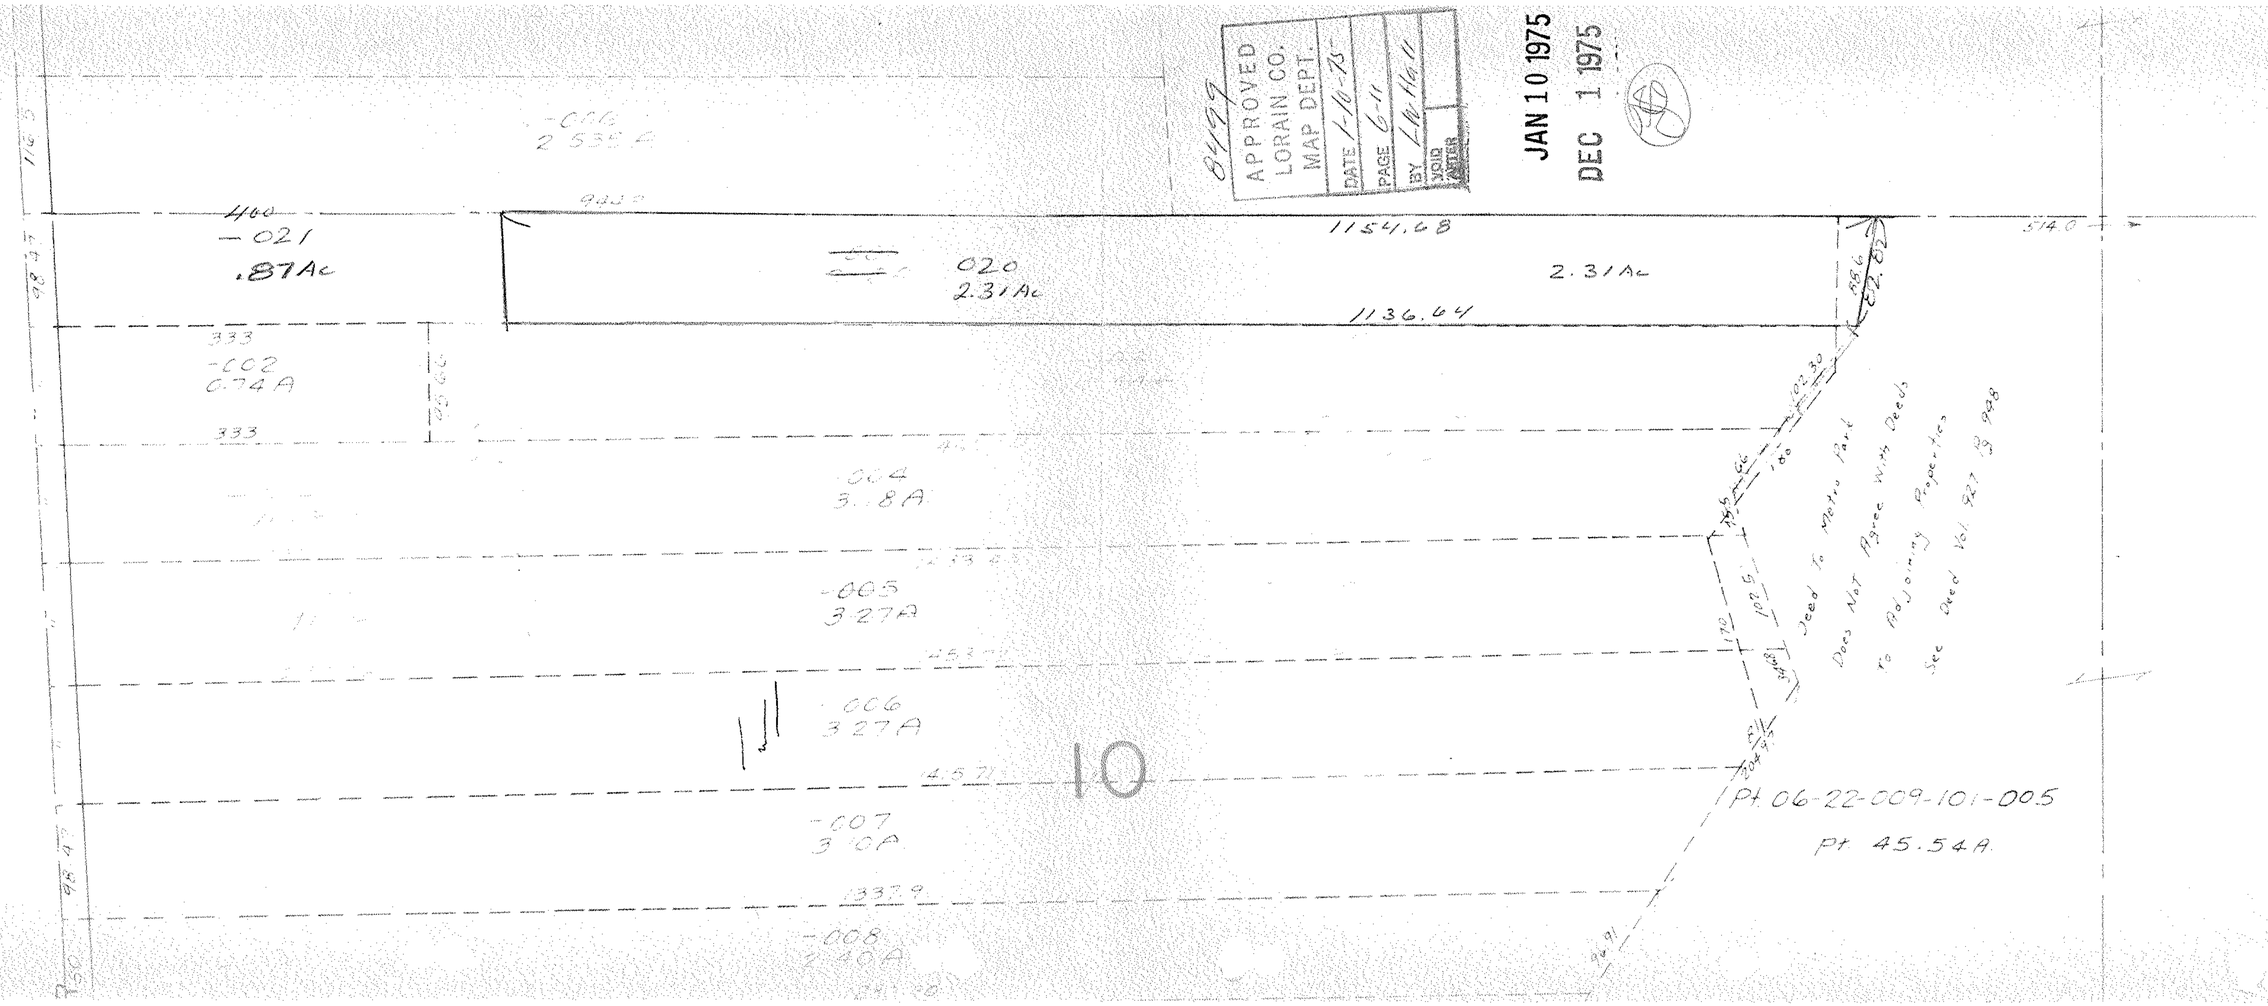
APPROVED
LORAIN CO.
MAP DEPT.
DATE 1-16-75
PAGE 6-11
BY LH Hall
VOID AFTER
JAN 10 1975
DEC 1 1975
-006
2.53A
1160
-021
.87Ac
020
2.31Ac
1154.68
2.31Ac
1136.64
333
-002
C.74A
333
-004
5.8A
-005
3.27A
-006
3.27A
-007
3.09A
-008
2.40A
Deed to Metro Park
Does Not Agree With Deeds
to Adjoining Properties
See Deed Vol 927 Pg 938
Pt 06-22-009-101-005
Pt 45.54A
10