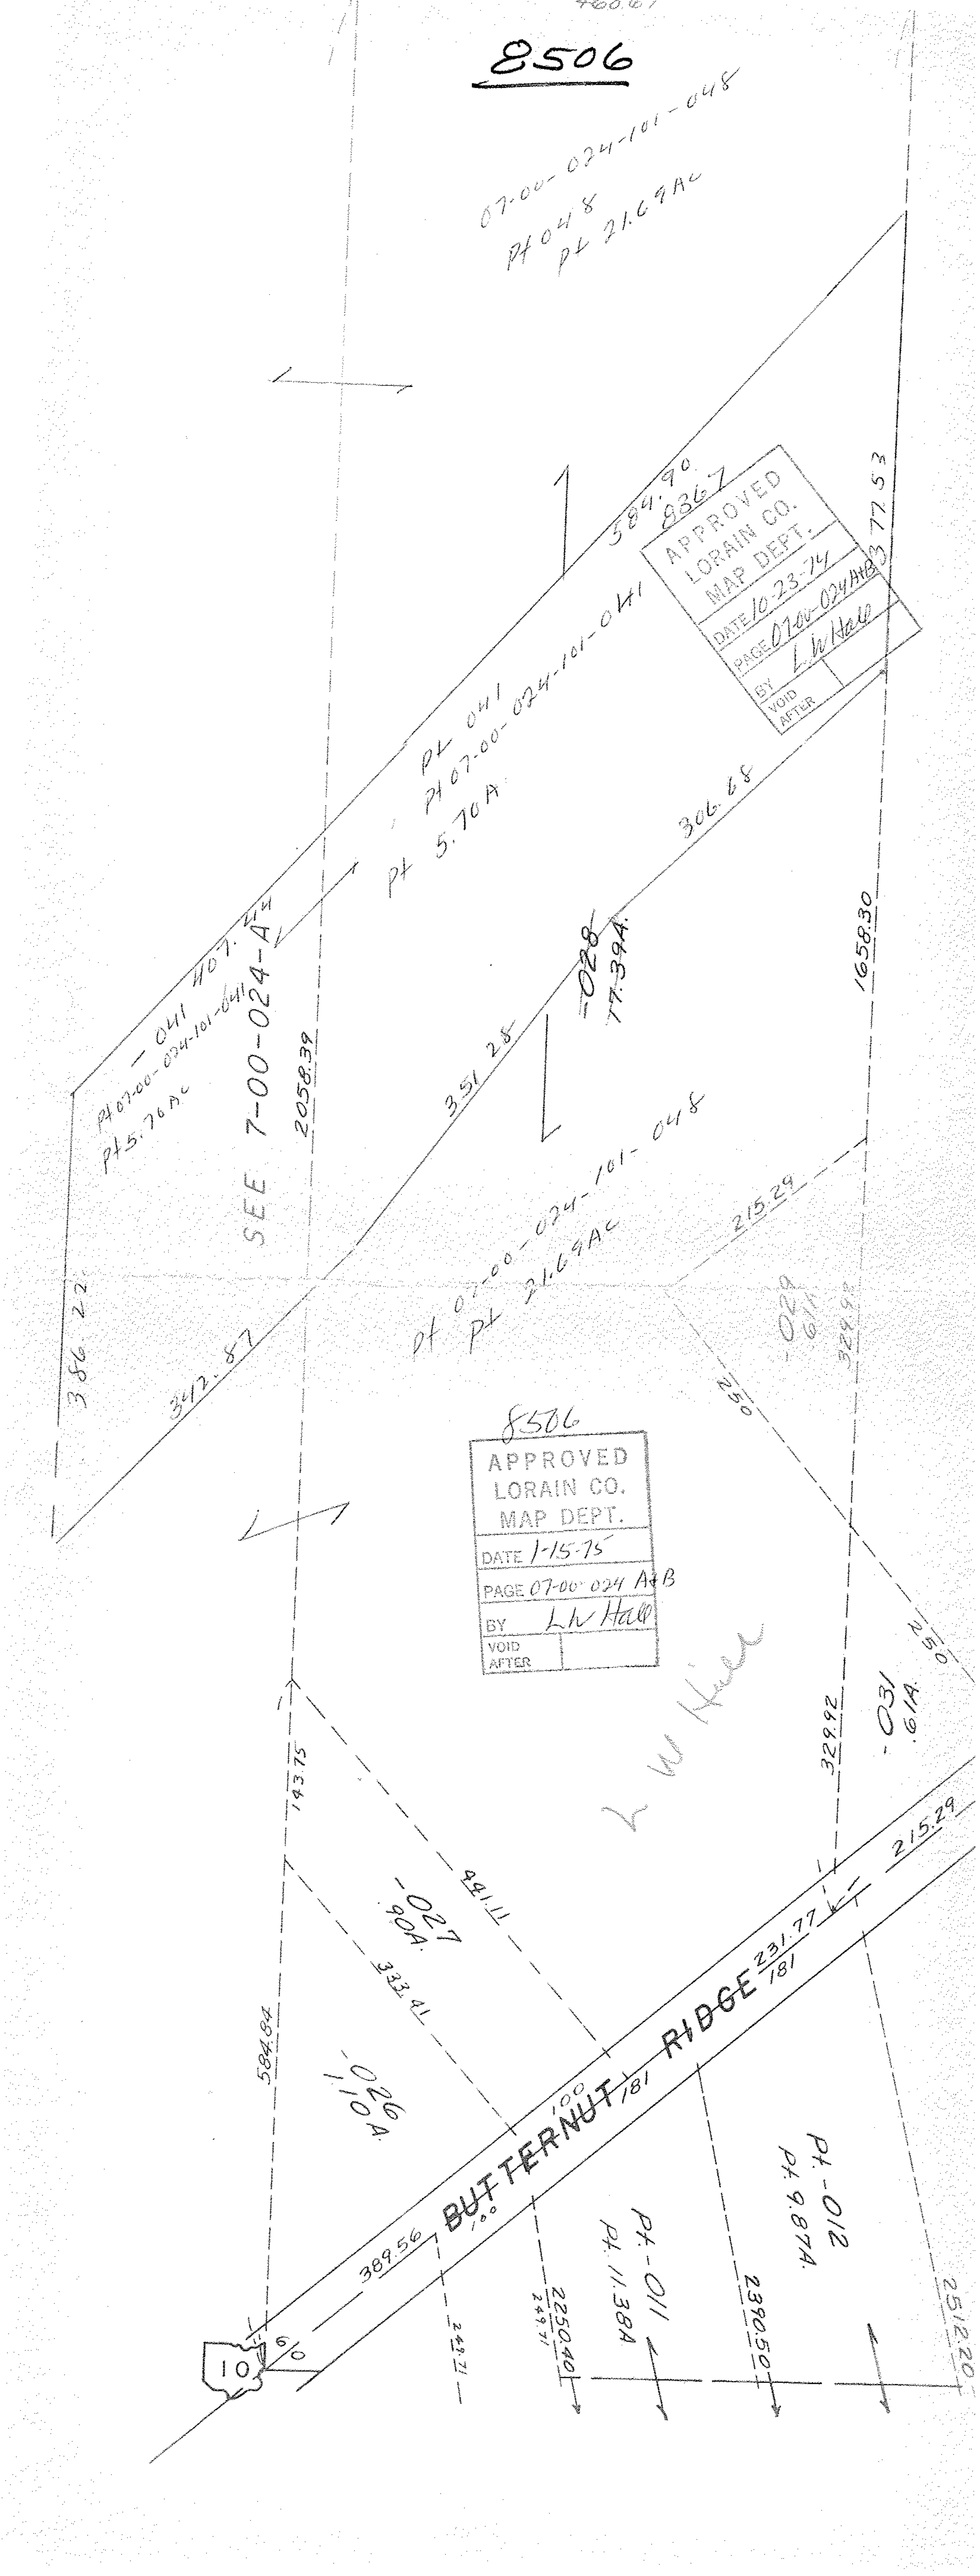
8506
07-00-024-101-048
Pt 048
Pt 21.69Ac
584.90
8367
APPROVED
LORAIN CO.
MAP DEPT.
DATE 10-23-74
PAGE 07-00-024 A+B
BY L.W. Hall
VOID AFTER
377.53
Pt 041
Pt 07-00-024-101-041
Pt 5.70A
306.68
-041 407.44
Pt 07-00-024-101-041
Pt 5.70Ac
SEE 7-00-024-A
2058.39
351.28
-028
17.39A
1658.30
Pt 07-00-024-101-048
Pt 21.69Ac
215.29
386.22
342.87
-029
.61A
329.92
250
8506
APPROVED
LORAIN CO.
MAP DEPT.
DATE 1-15-75
PAGE 07-00-024 A+B
BY L.W. Hall
VOID AFTER
L W Hall
250
-031
.61A
329.92
143.75
441.11
-027
.90A
333.41
215.29
231.77
181
584.84
-026
1.10A
100
181
BUTTERNUT RIDGE
Pt -012
Pt 9.87A
Pt -011
Pt 11.38A
389.56
100
249.71
2250.40
2390.50
2512.20
10
60