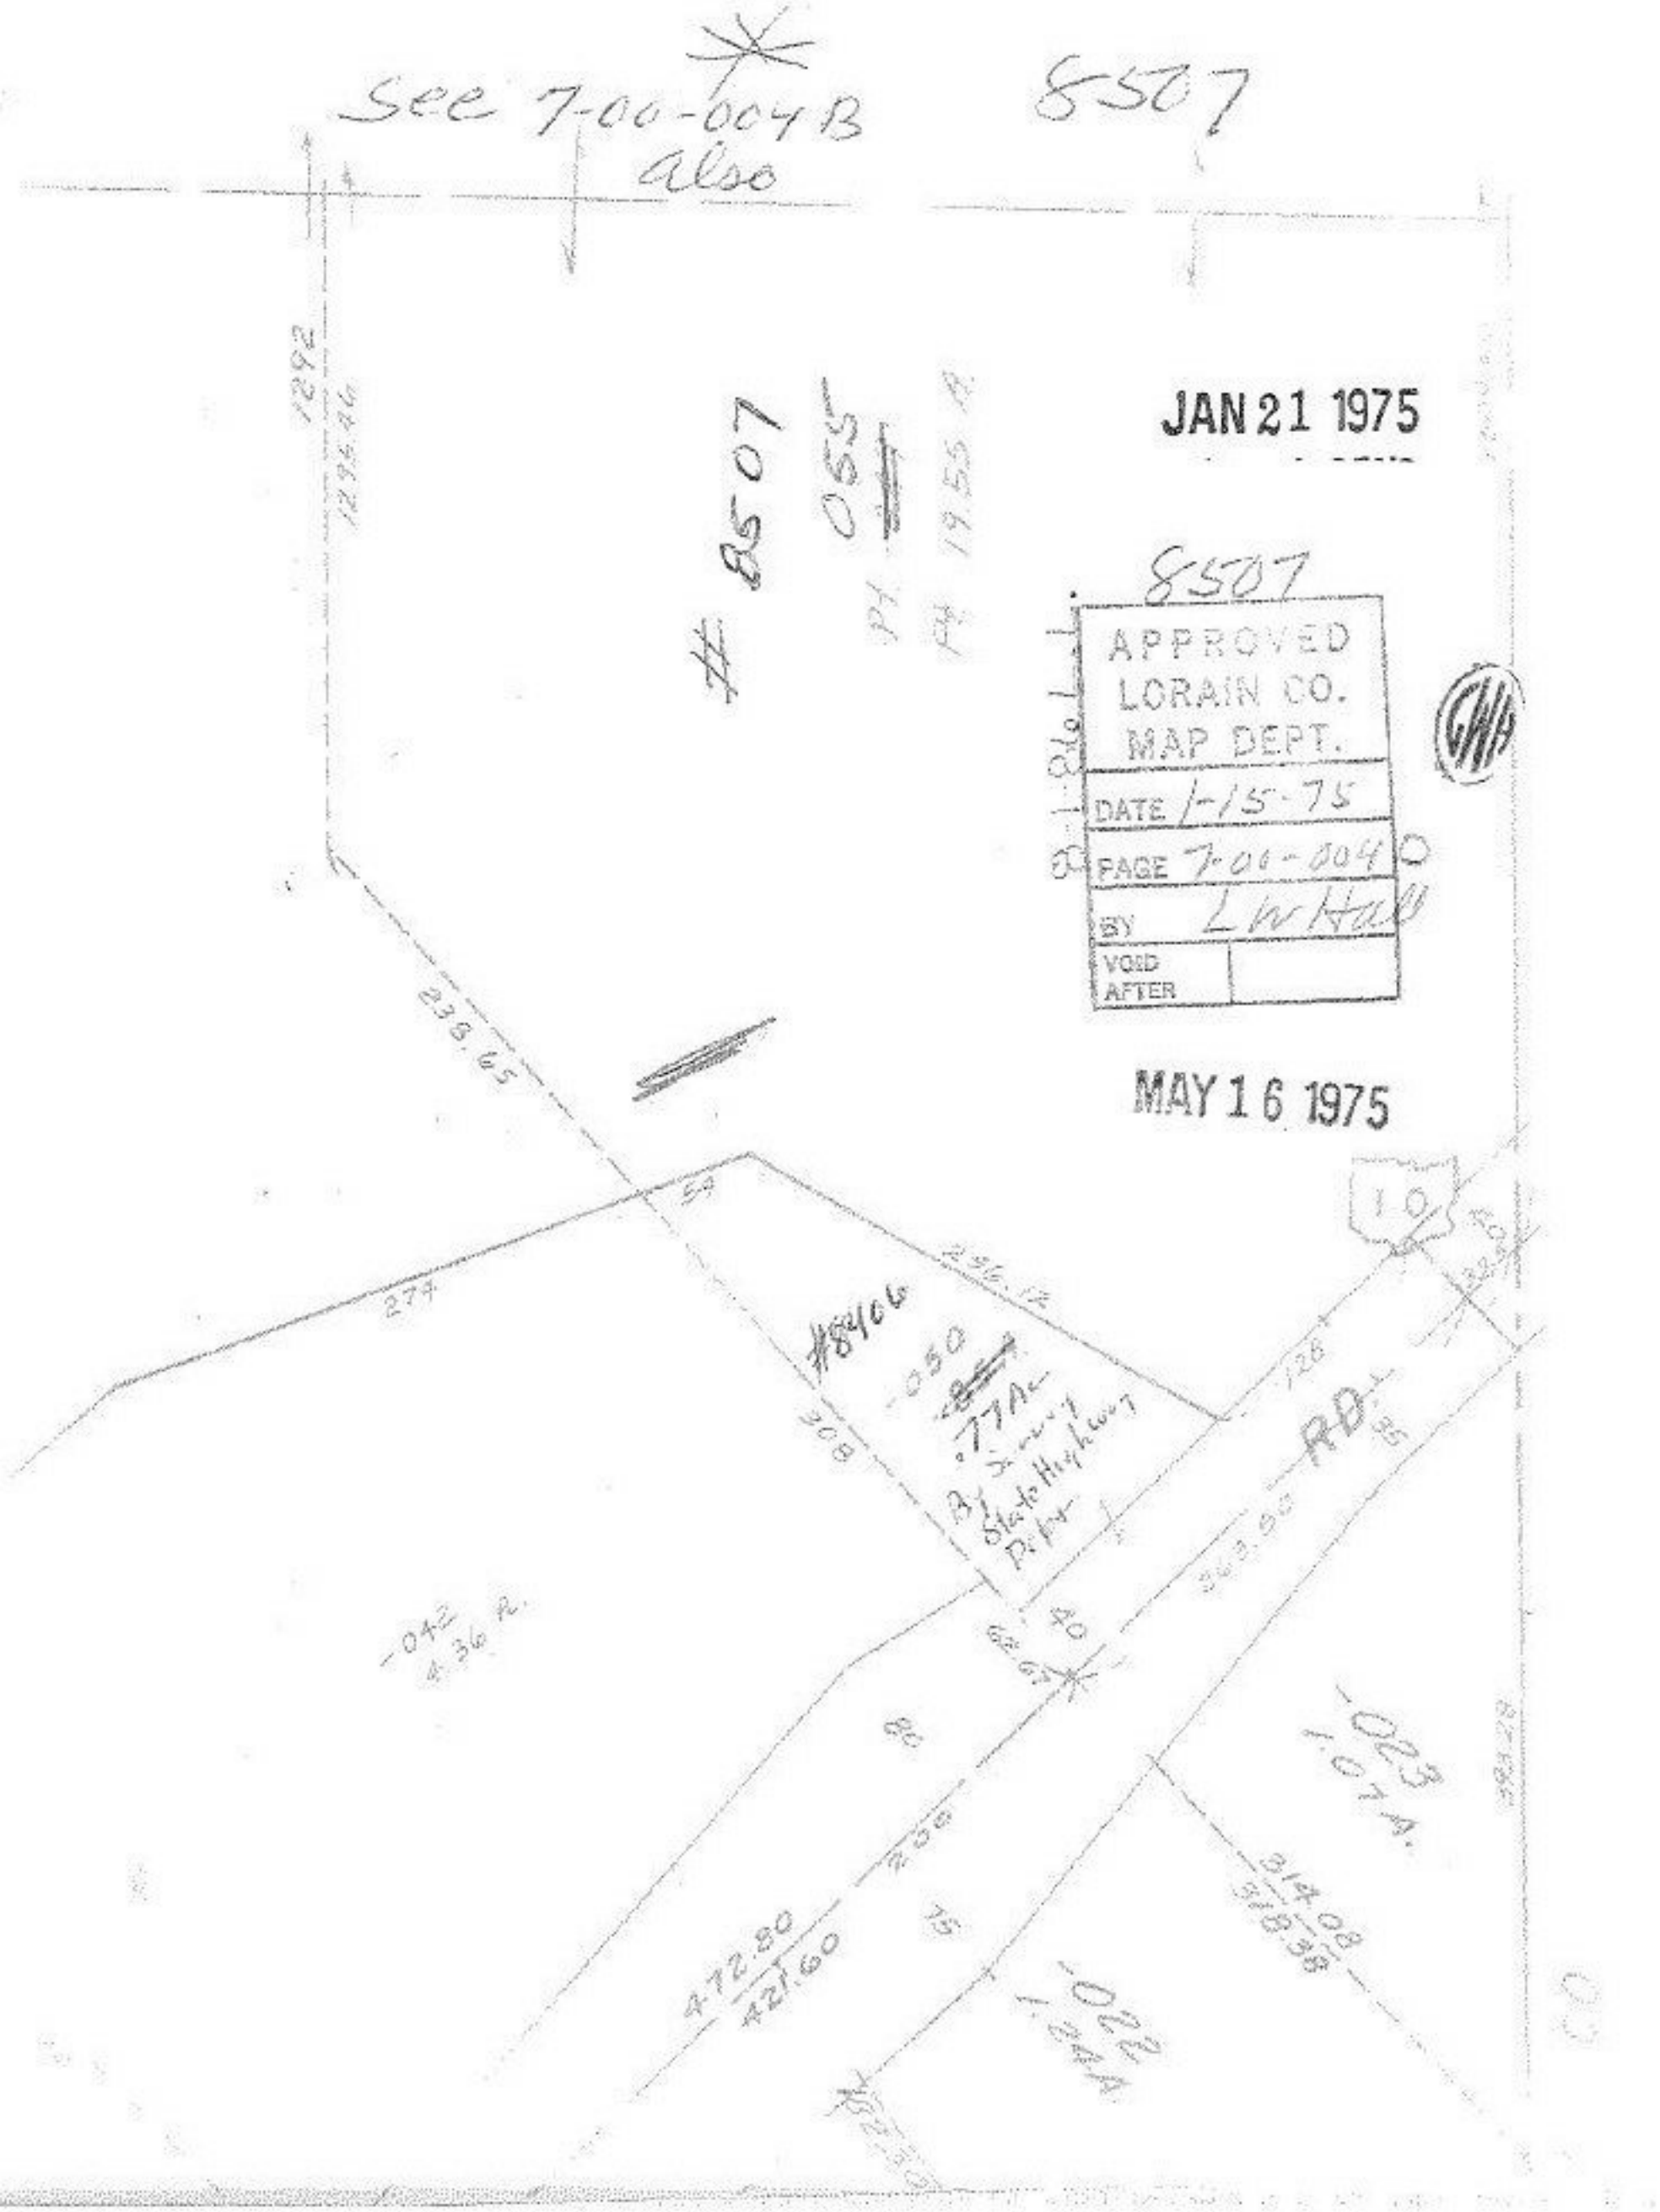

See 7-00-004B also
8507
JAN 21 1975
8507
APPROVED
LORAIN CO.
MAP DEPT.
DATE 1-15-75
PAGE 7-00-004
BY LW Hall
VOID AFTER
MAY 16 1975
#8507
.055
#8406
.050
.77Ac
By Survey State Highway Dept
RD
-042
4.36 A.
-023
1.07A.
-022
1.24A
472.80
421.60
314.08
318.38
238.65
274
308