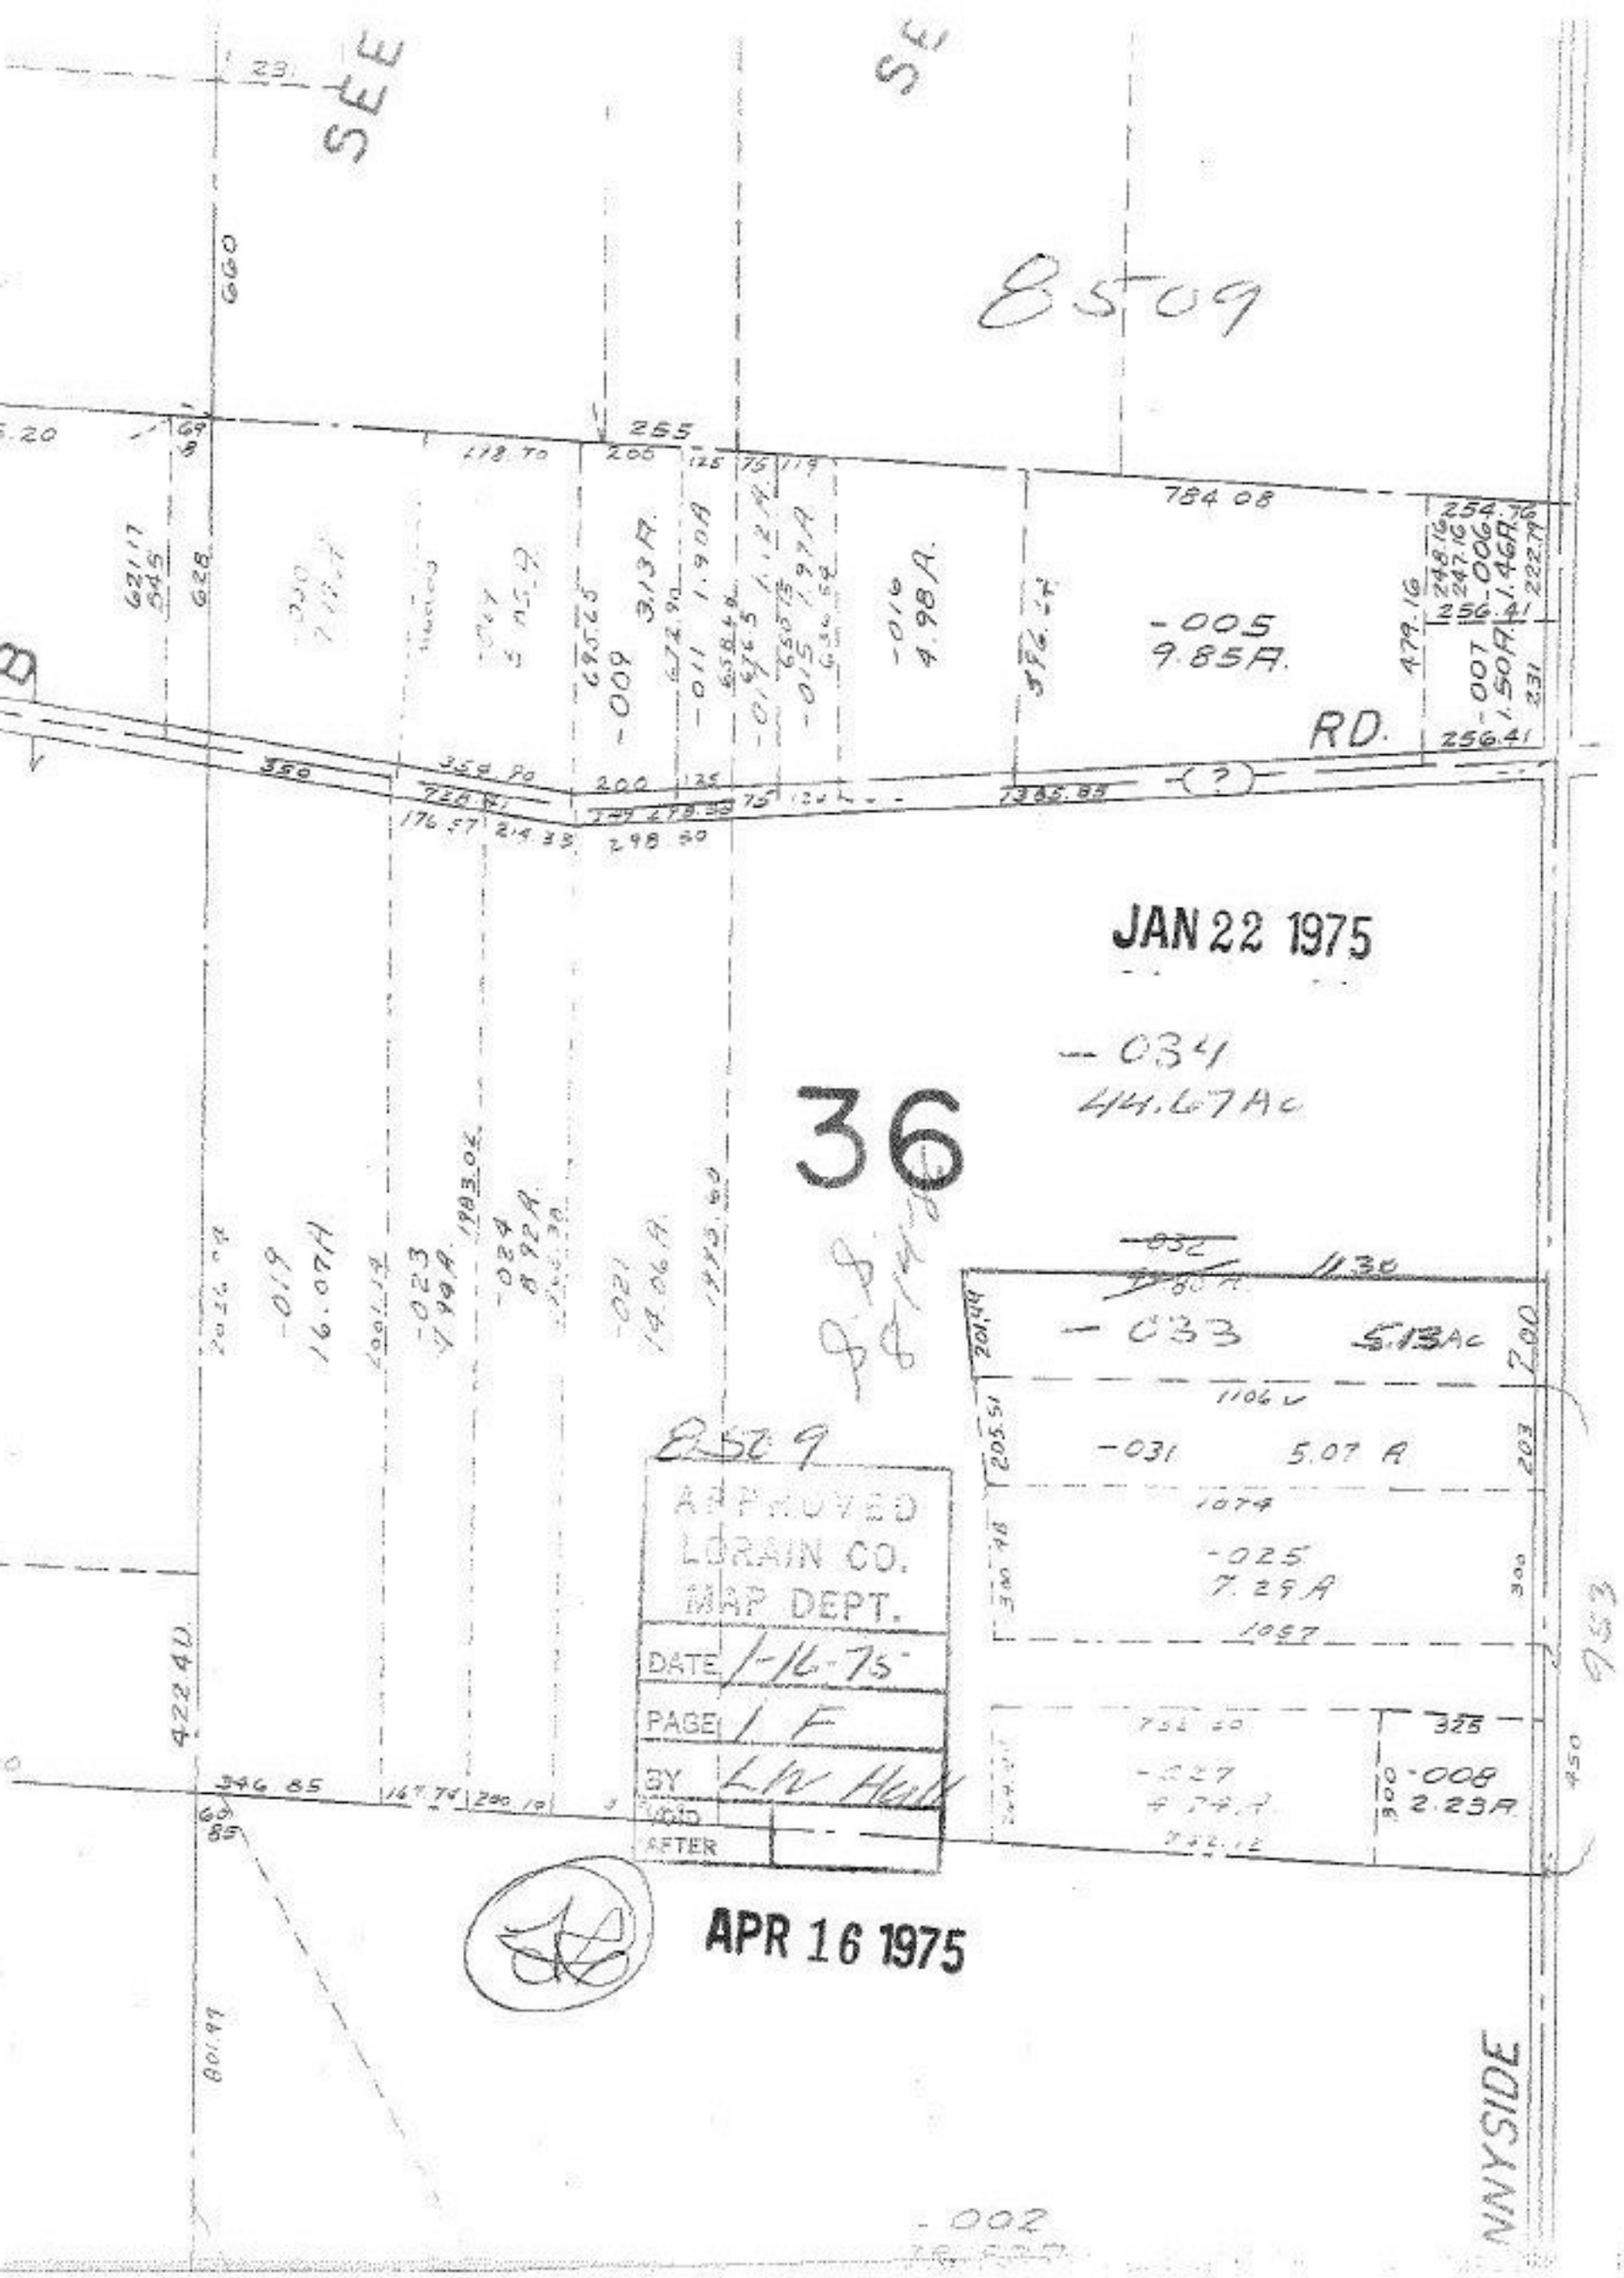
SEE
SE
8509
RD.
JAN 22 1975
-034
44.67Ac
36
-033
5.13Ac
-031
5.07 A
-025
7.29 A
-008
2.23A
APPROVED
LORAIN CO.
MAP DEPT.
DATE 1-16-75
PAGE 1 F
BY L.W. Hall
VOID
AFTER
APR 16 1975
NNYSIDE
-002