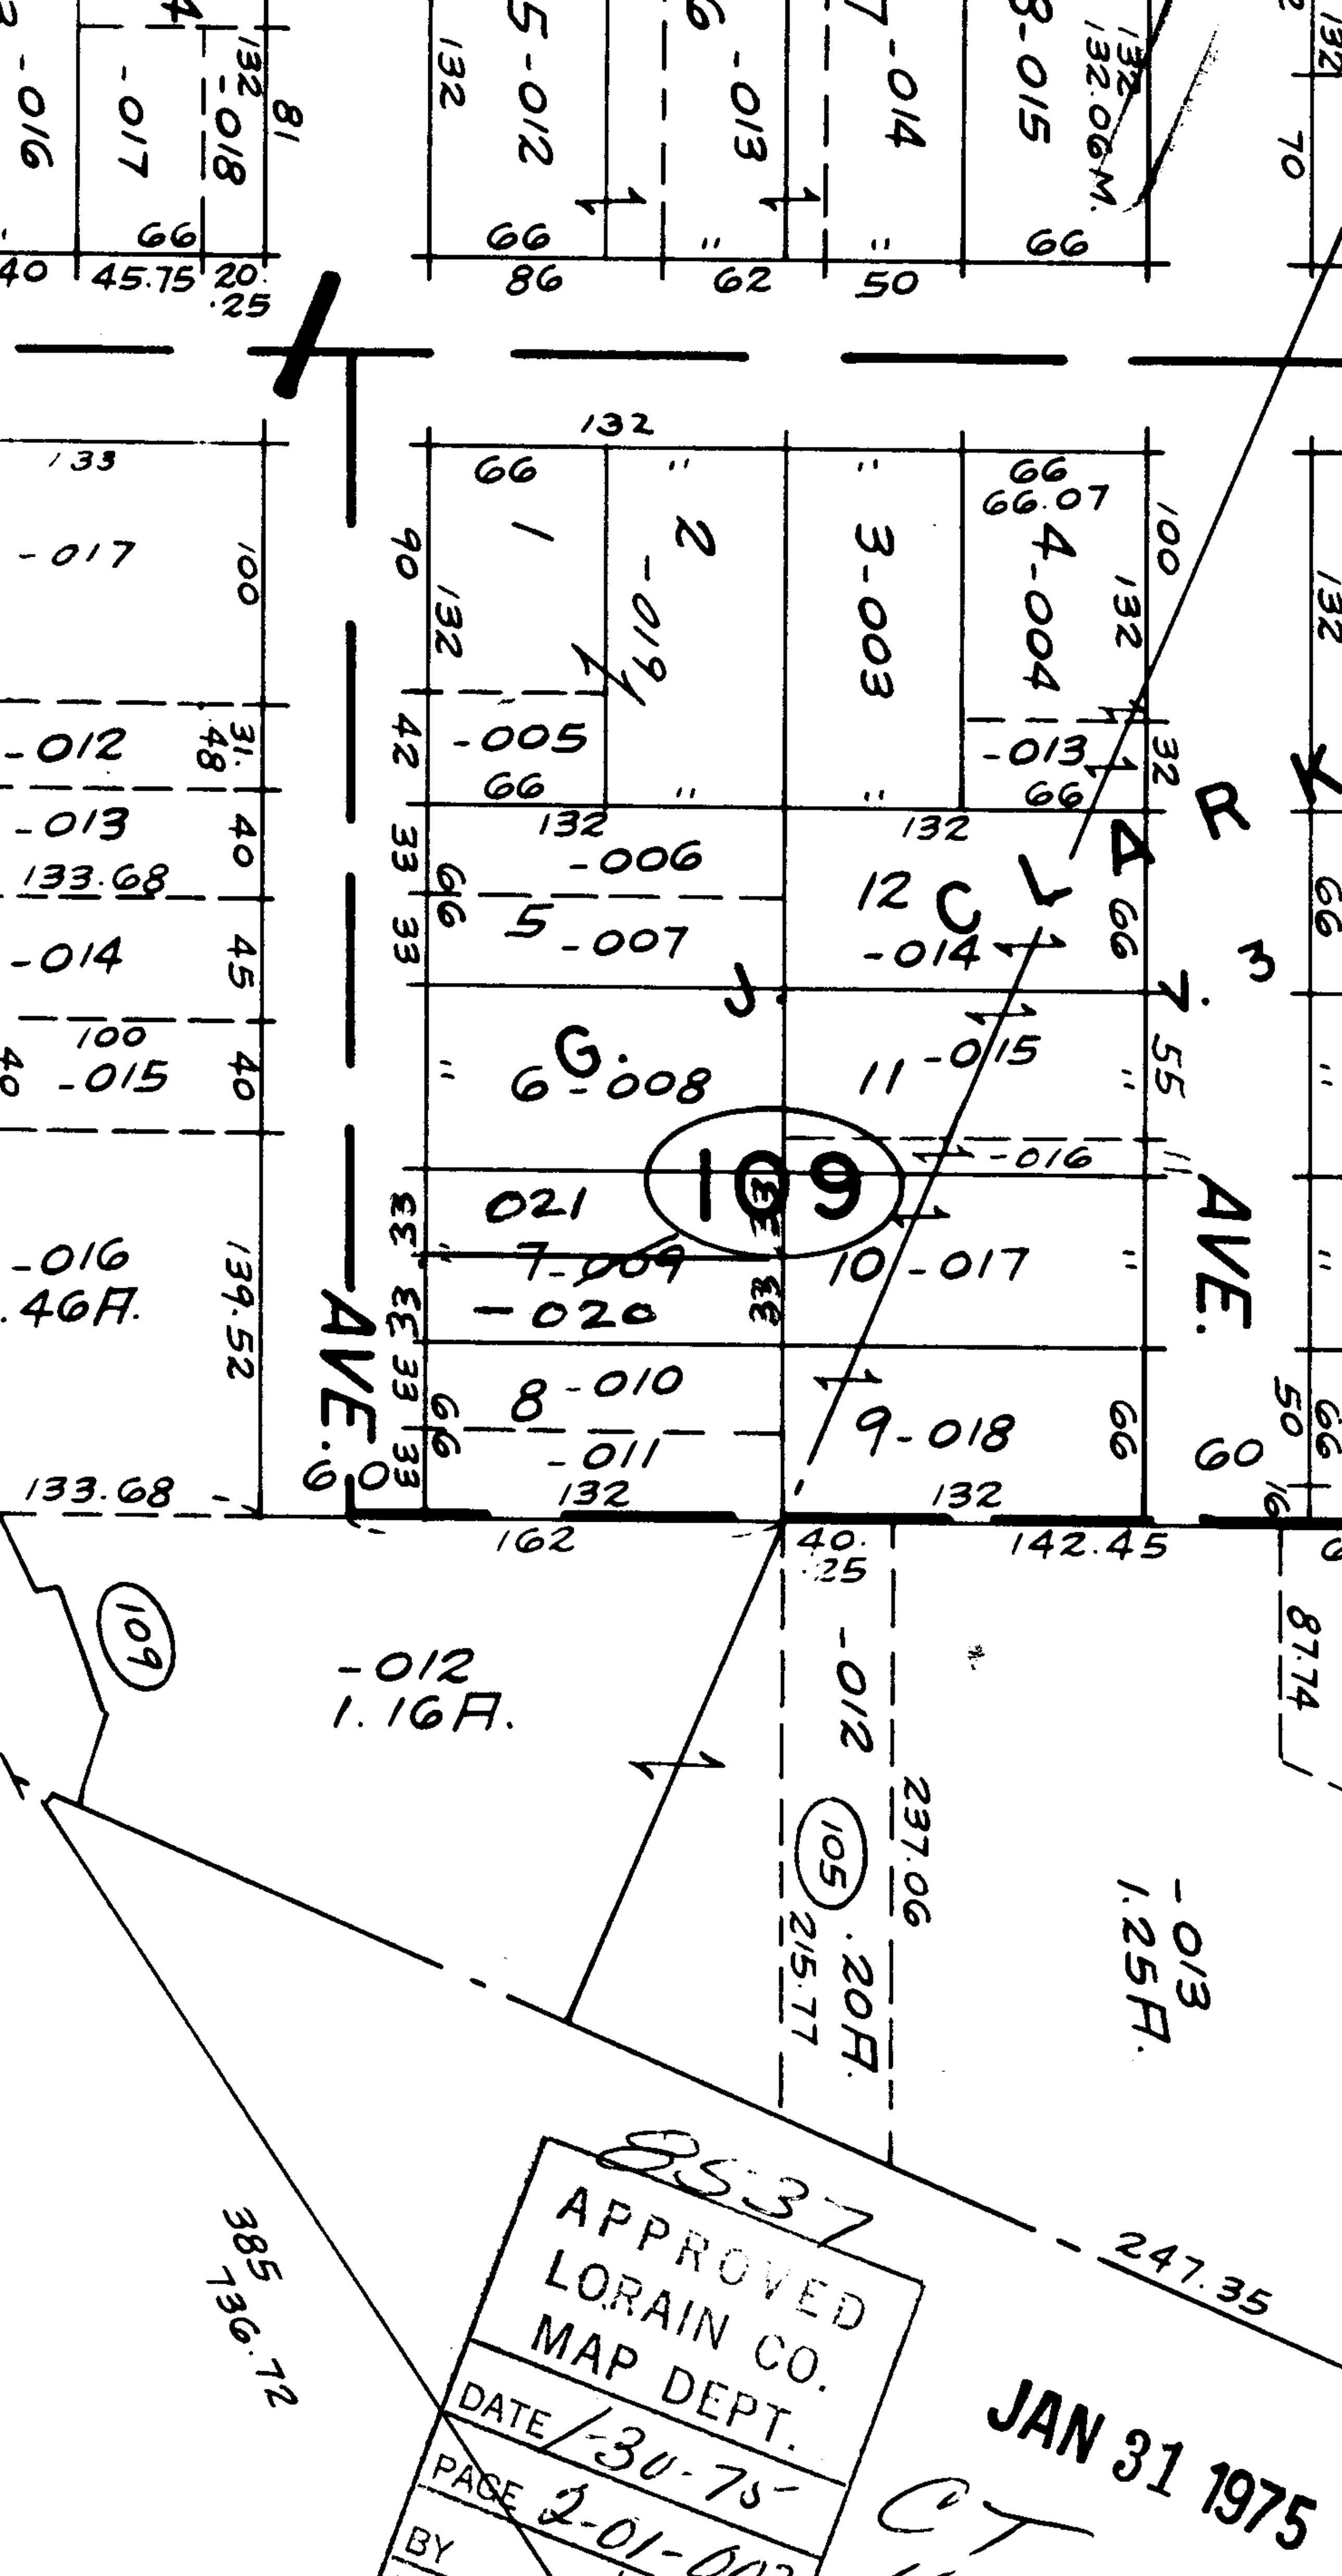
APPROVED
LORAIN CO.
MAP DEPT.
DATE 1-30-75
PAGE 2-01-003
BY
JAN 31 1975
8537
109
105
AVE.
AVE.
-012
1.16A.
-013
1.25A.
-012
1.20A.
-016
.46A.
247.35
385
736.72
237.06
215.17
87.74
142.45
162
132.06M.