


8544

FEB 6 1975

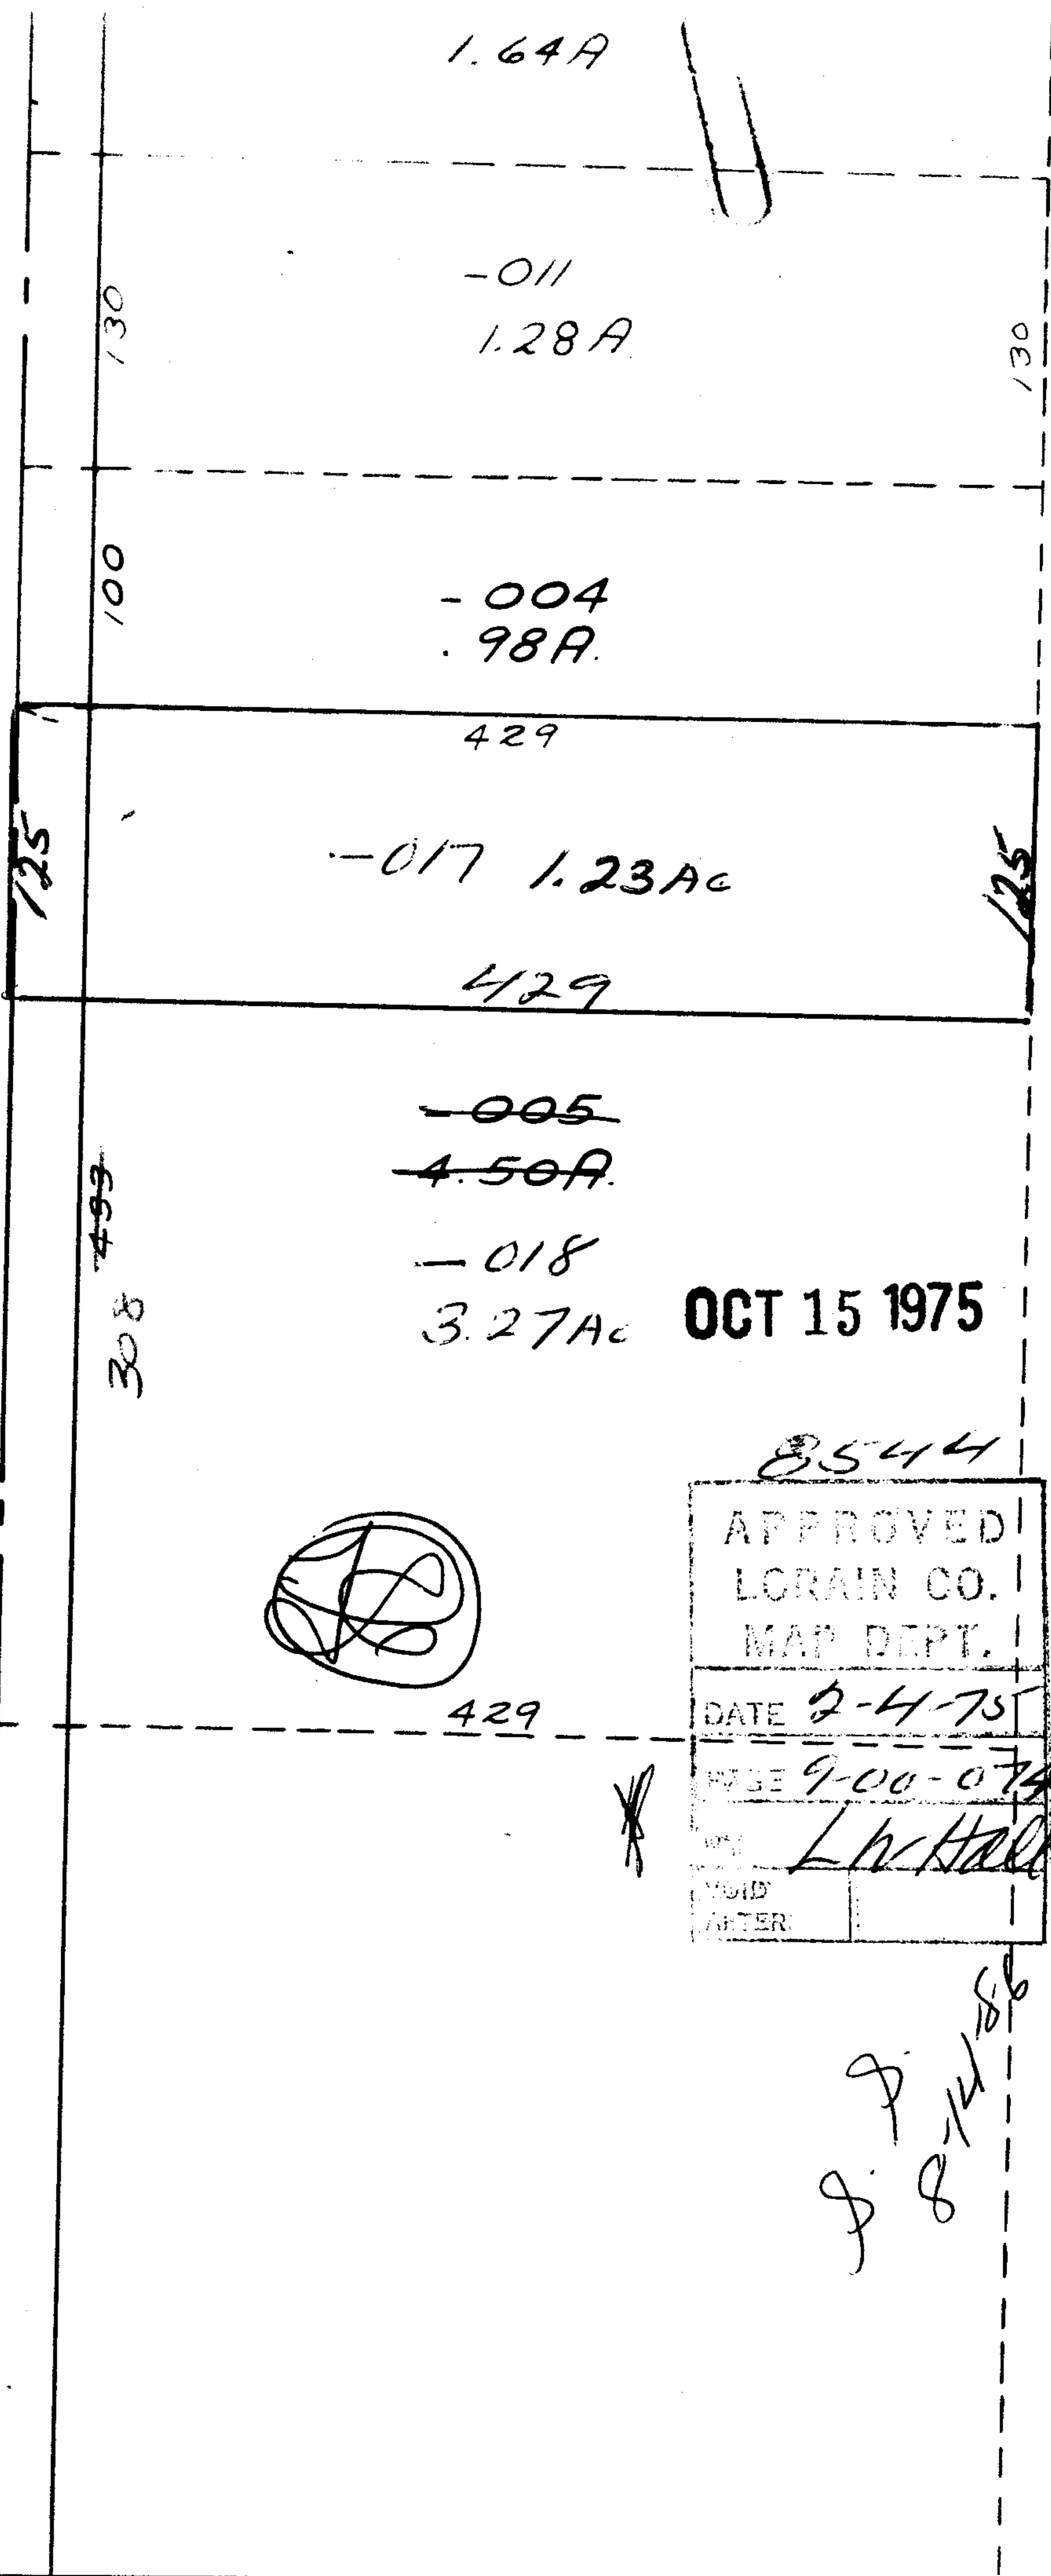

8544

APPROVED	
LORAIN CO.	
MAP DEPT.	
DATE	2-4-75
PAGE	9-00-074A
BY	L. W. Hall
VOID	
AFTER	

J. P. 8-14-86

SEE 9-00-073-B

2640

433  
125  
308