


FEB 11 1975

8-00-093-A


93

8555

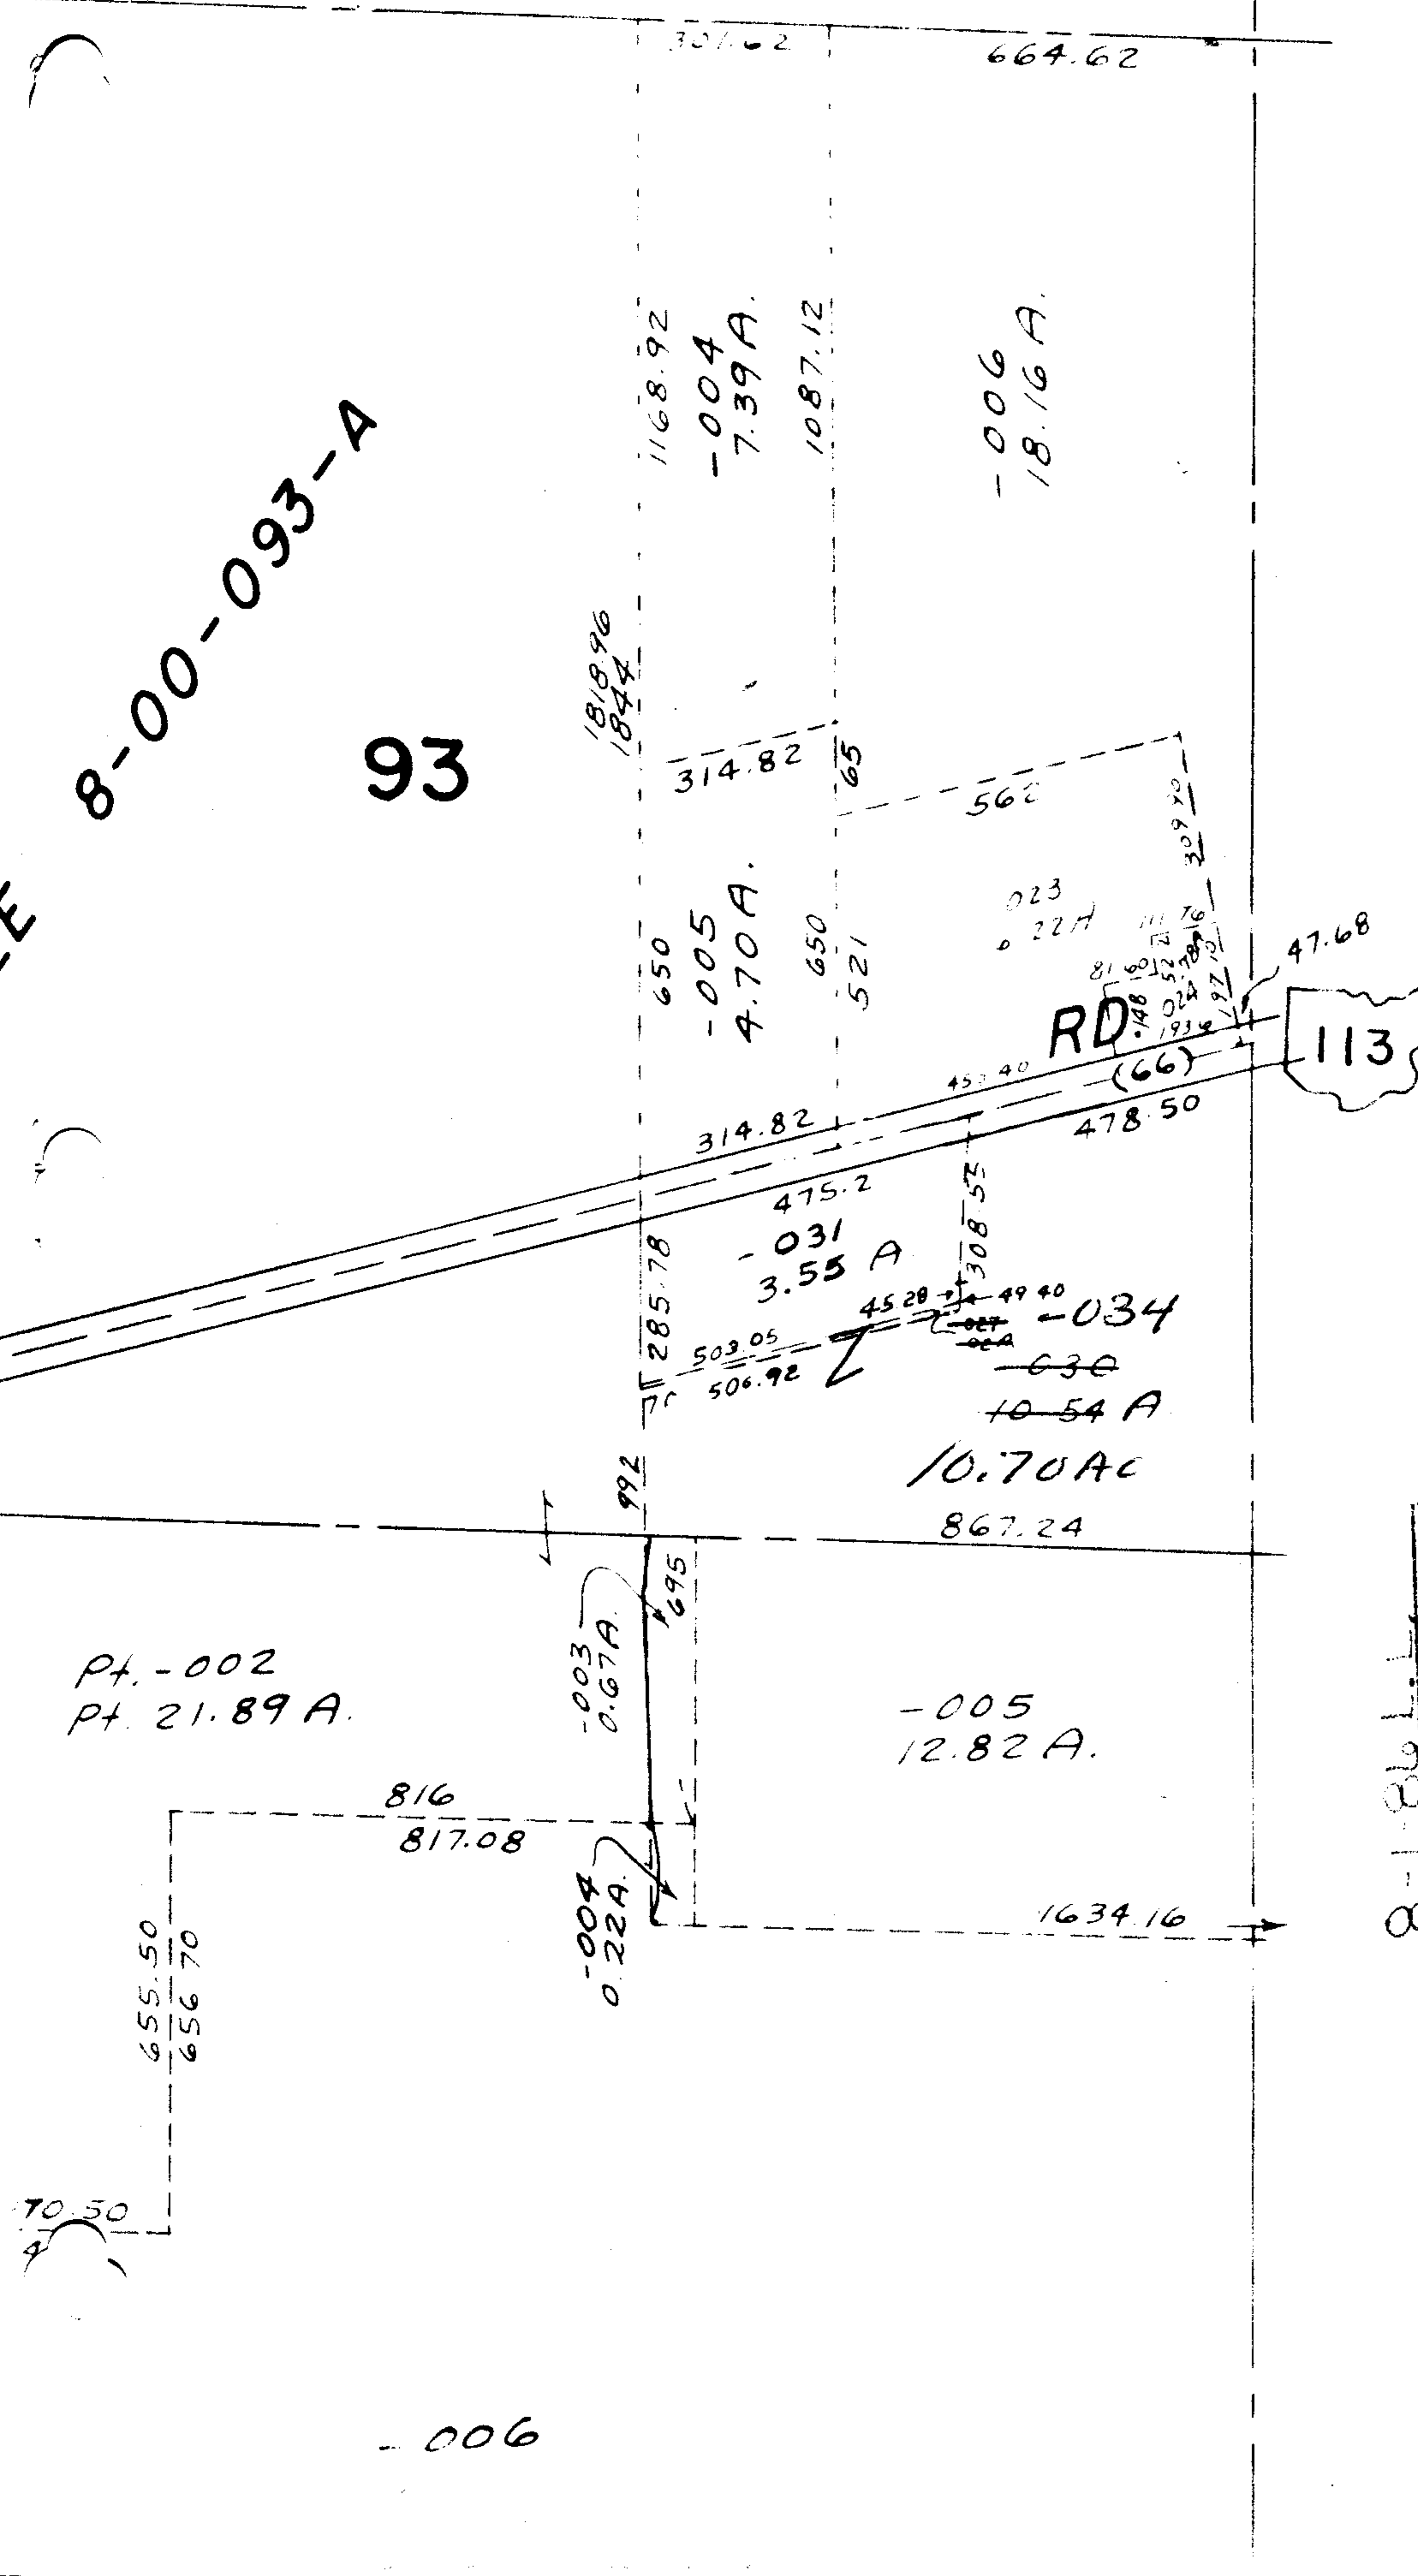

OCT 10 1975

113

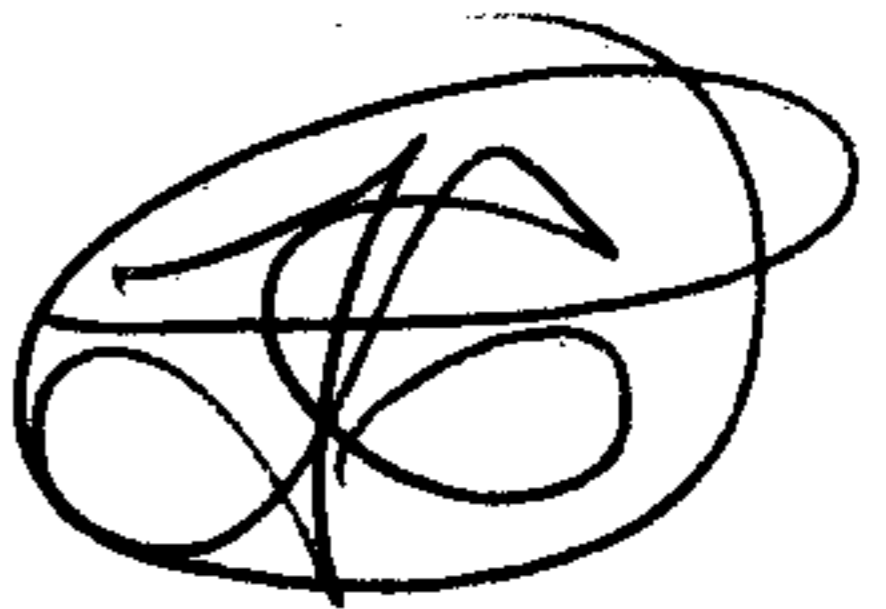

8555

APPROVED	
LORAIN CO.	
MAP DEPT.	
DATE	2-10-75
PAGE	8B
BY	LW Hall
VOID	
AFTER	

Pt. -002
Pt. 21.89 A.

816
817.08

-005
12.82 A.

1634.16

655.50
656.70

-006