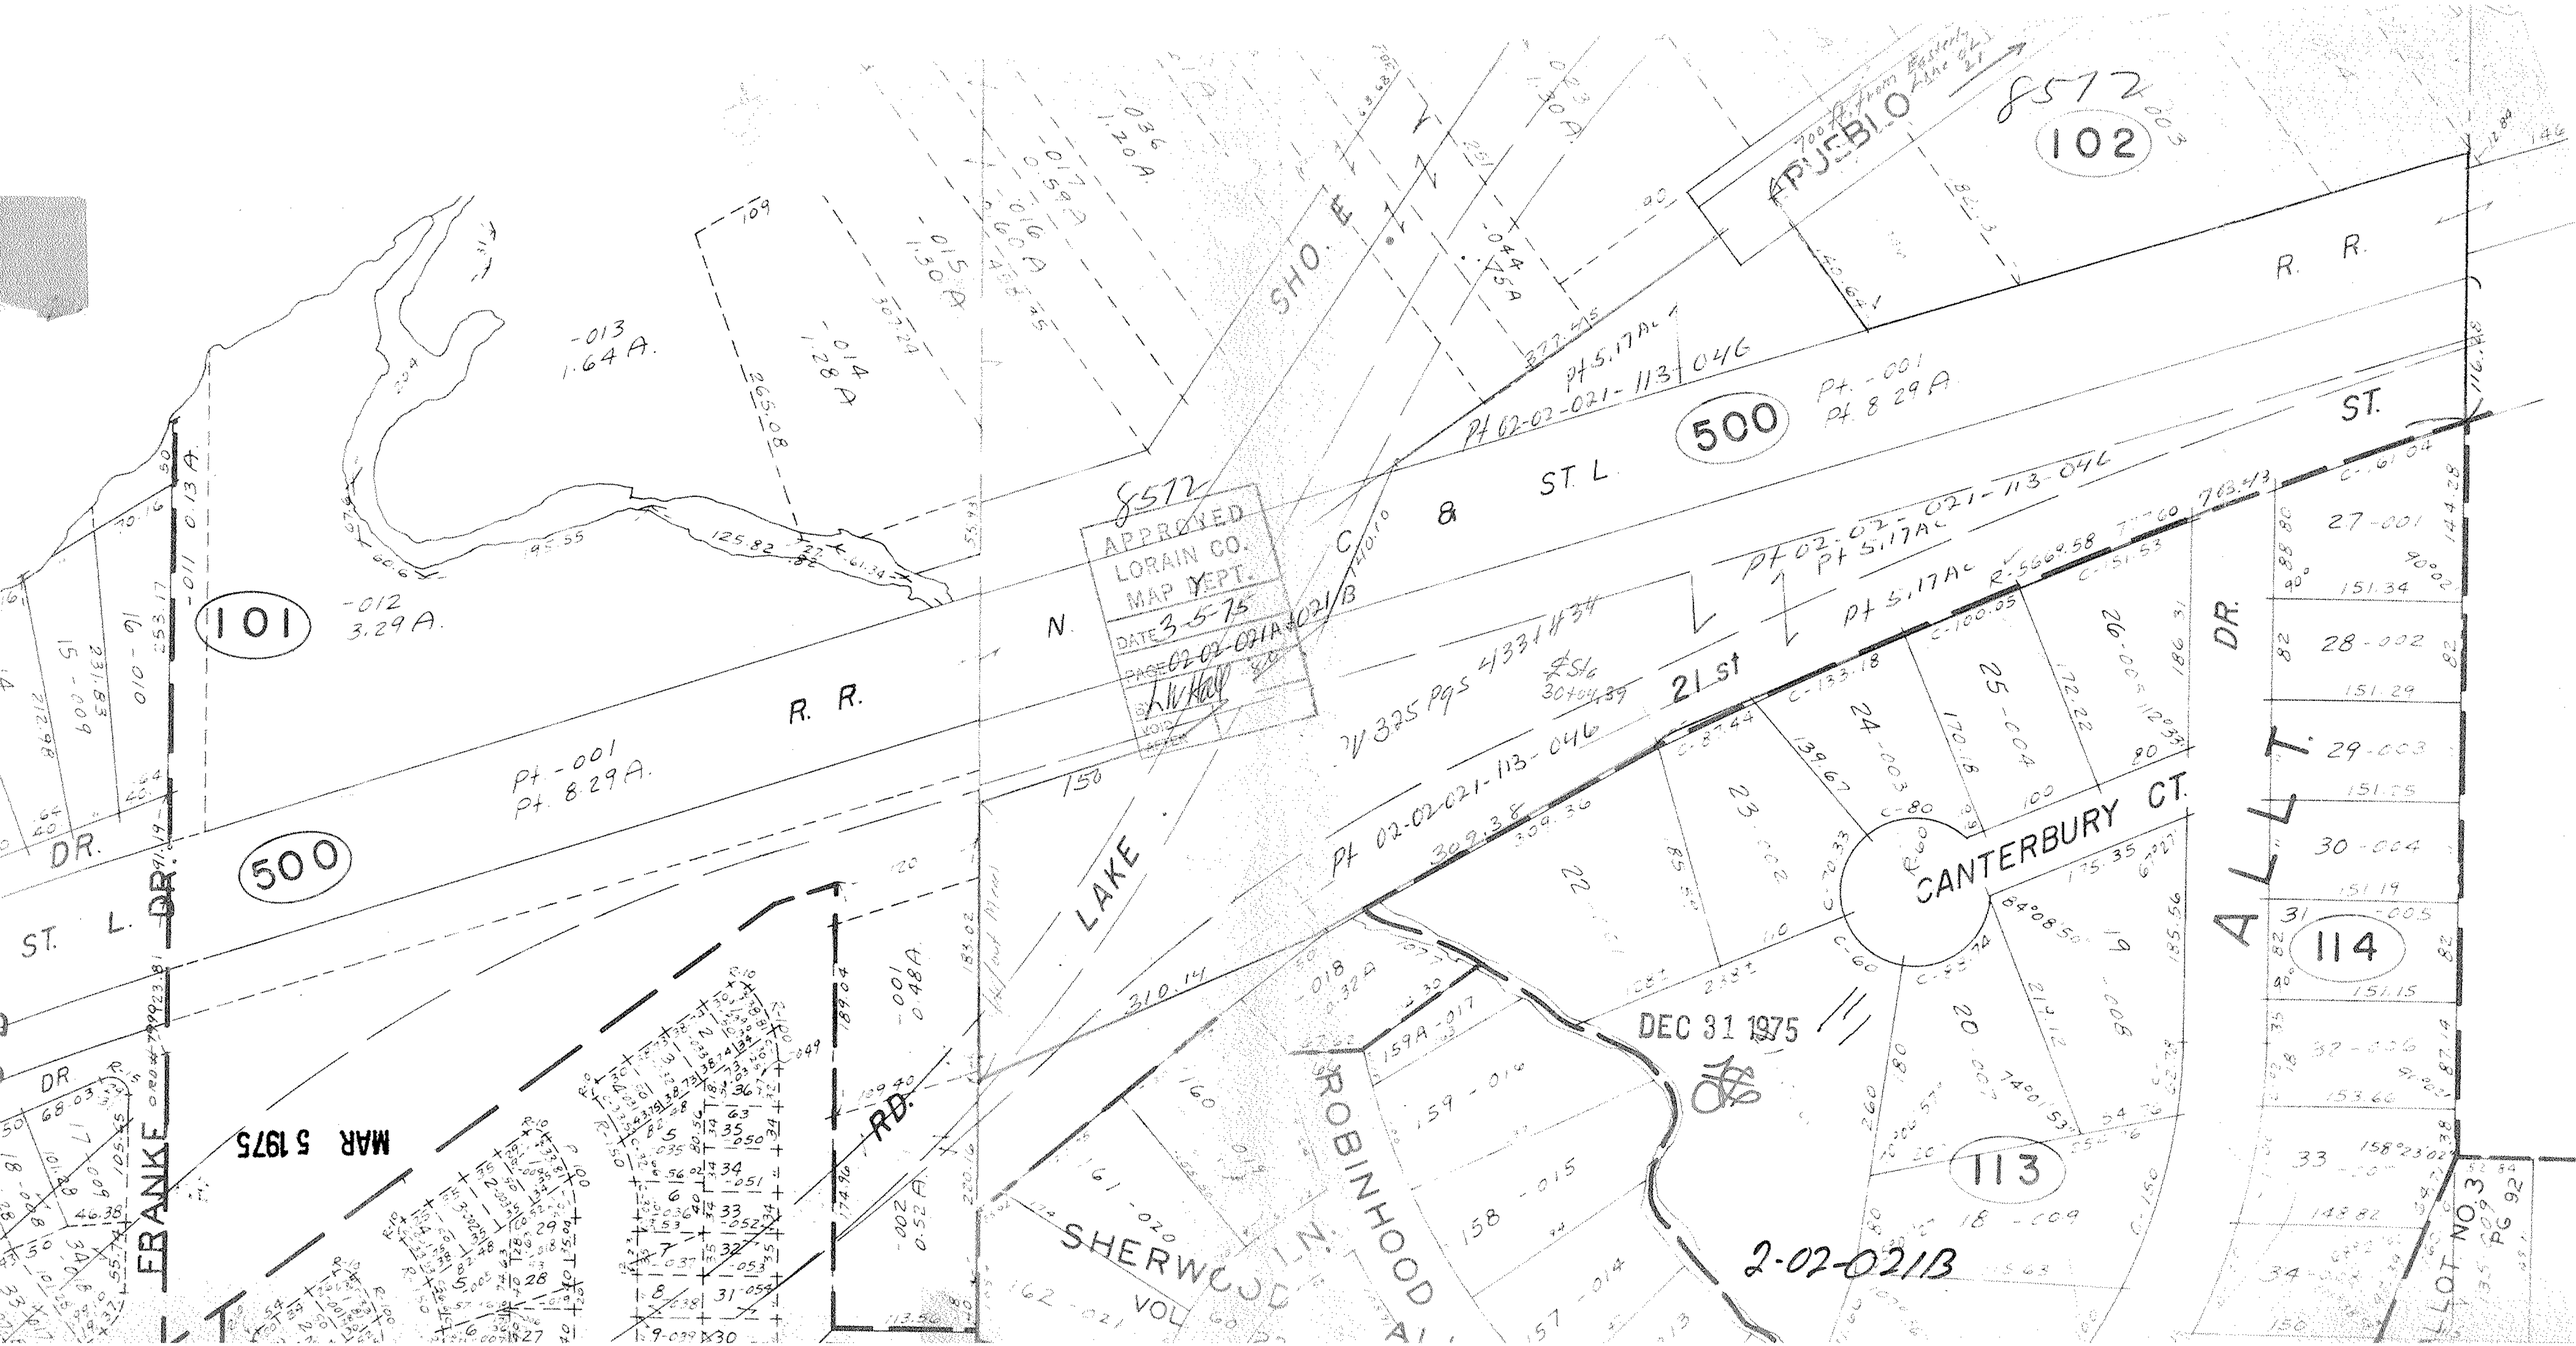
APPROVED
LORAIN CO.
MAP DEPT.
DATE 3-5-75
PARCEL 02-02-021A+021B
BY
LOT
SECT.
MAR 5 1975
DEC 31 1975
2-02-021B
CANTERBURY CT.
ROBINHOOD
SHERWOOD
LAKE
FRANKE
ALLT.
DR.
RD.
R. R.
N. C. & ST. L.
ST. L.
21st
ST.
APUBLO
102
101
500
114
113
Pt. 02-02-021-113-046
Pt. 5.17 Ac
Pt. -001
Pt. 8.29 A
V 325 Pgs 433 & 434
PLOT NO. 3
PG 92