


SEE 7-00-014-D

8600

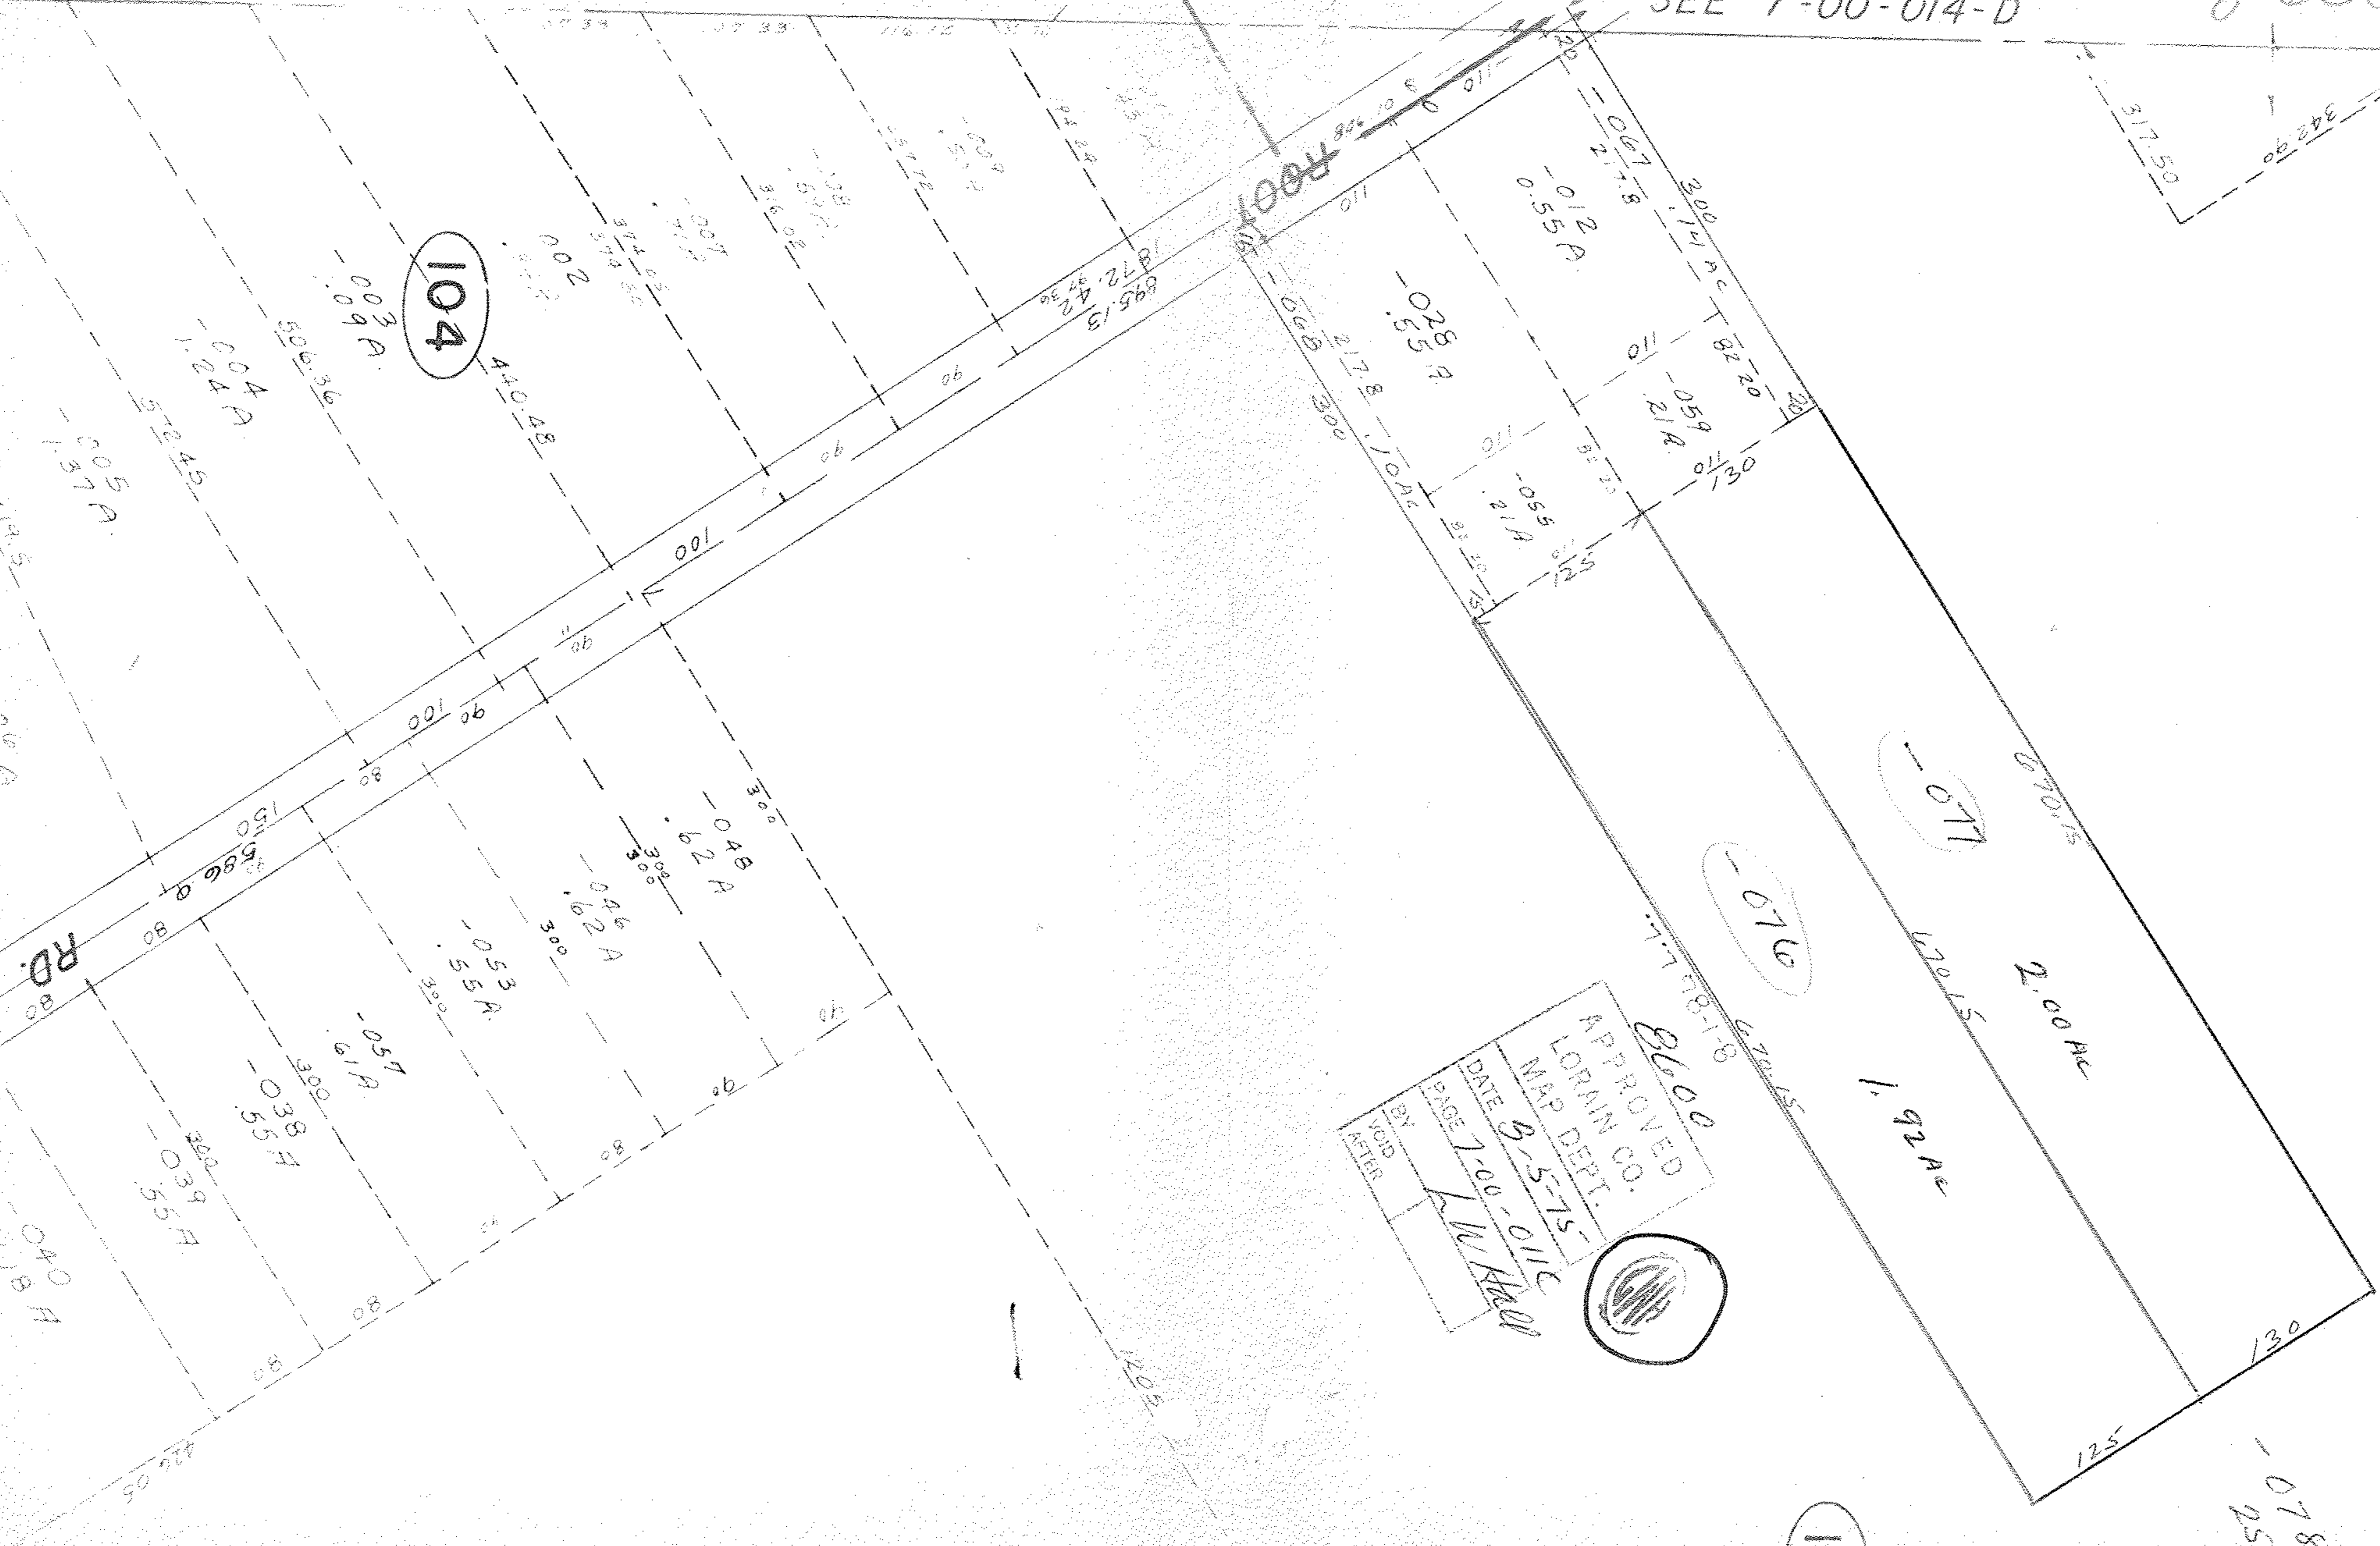

APPROVED
 LORAIN CO.
 MAP DEPT.
 DATE 6-5-75
 PAGE 7-00-011C
 VOID AFTER



8600
 875

RD.

103

104

076

071

078

RD.