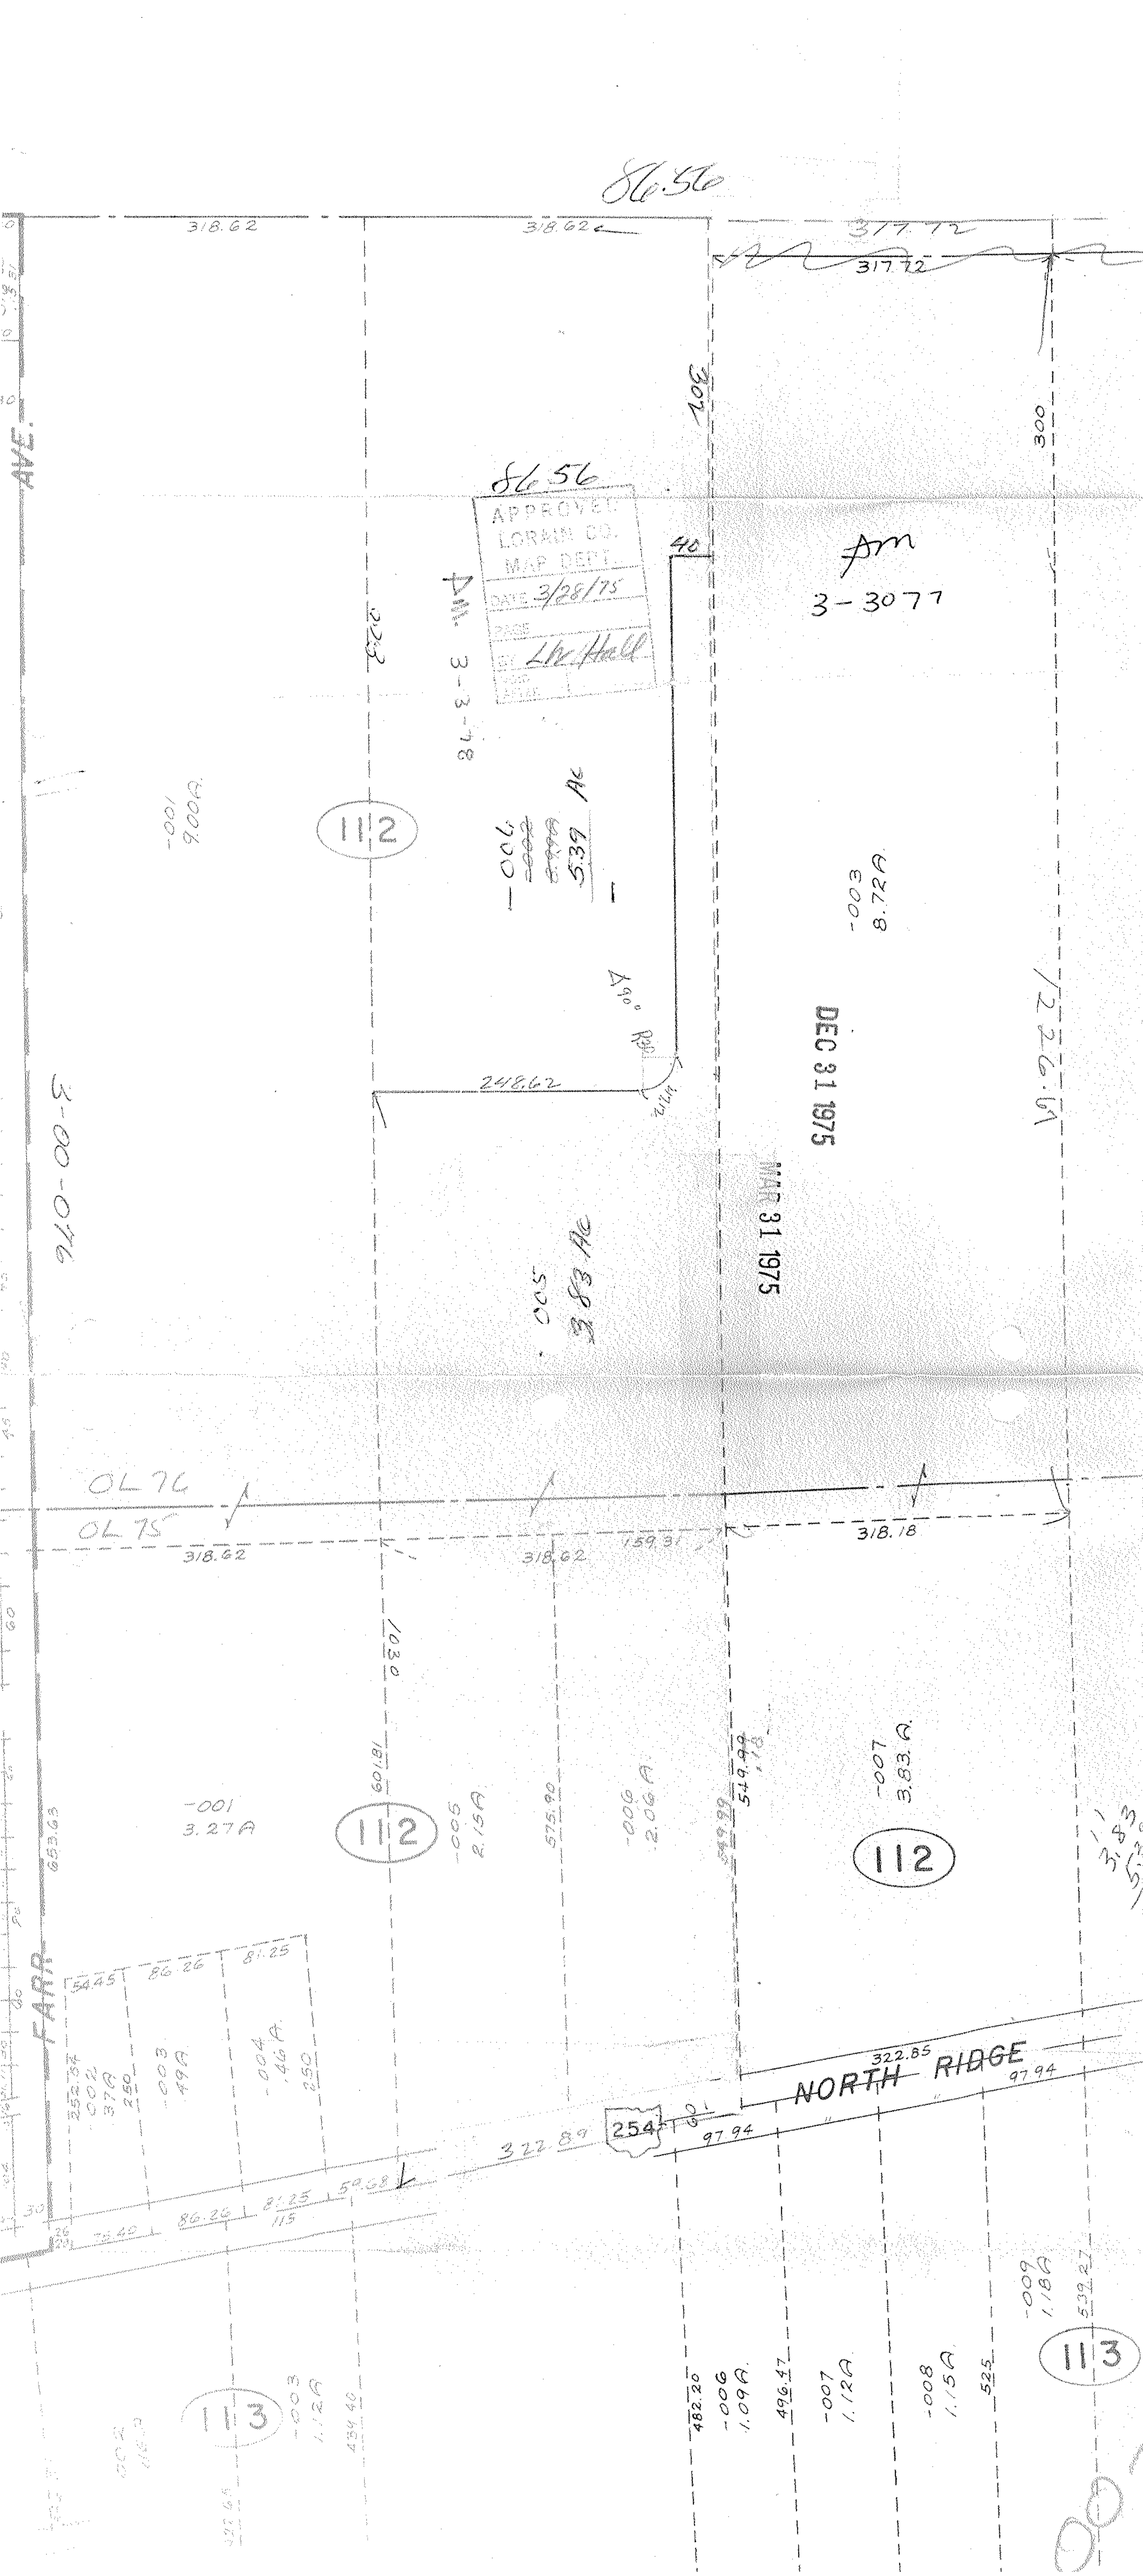
86.56
318.62
318.62
317.72
317.72
300
86.56
APPROVED
LORAIN CO.
MAP DEPT.
DATE 3/28/75
BY Lhc Hall
40
Am
3-3077
AVE.
3-3-78
112
-001
9.00A
-006
5.39 Ac
-003
8.72A
DEC 31 1975
MAR 31 1975
248.62
3-00-076
-005
3.83 Ac
OL 76
OL 75
318.62
318.62
159.31
318.18
1030
601.81
-001
3.27A
112
-005
2.15A
575.90
-006
2.06A
549.99
-007
3.83A
112
FARR
54.45
86.26
81.25
-002
37A
250
-003
49A
-004
46A
250
322.85
NORTH RIDGE
97.94
254
322.89
97.94
86.26
81.25
115
59.68
-009
1.18A
539.27
113
-003
1.12A
482.20
-006
1.09A
496.47
-007
1.12A
-008
1.15A
525
113