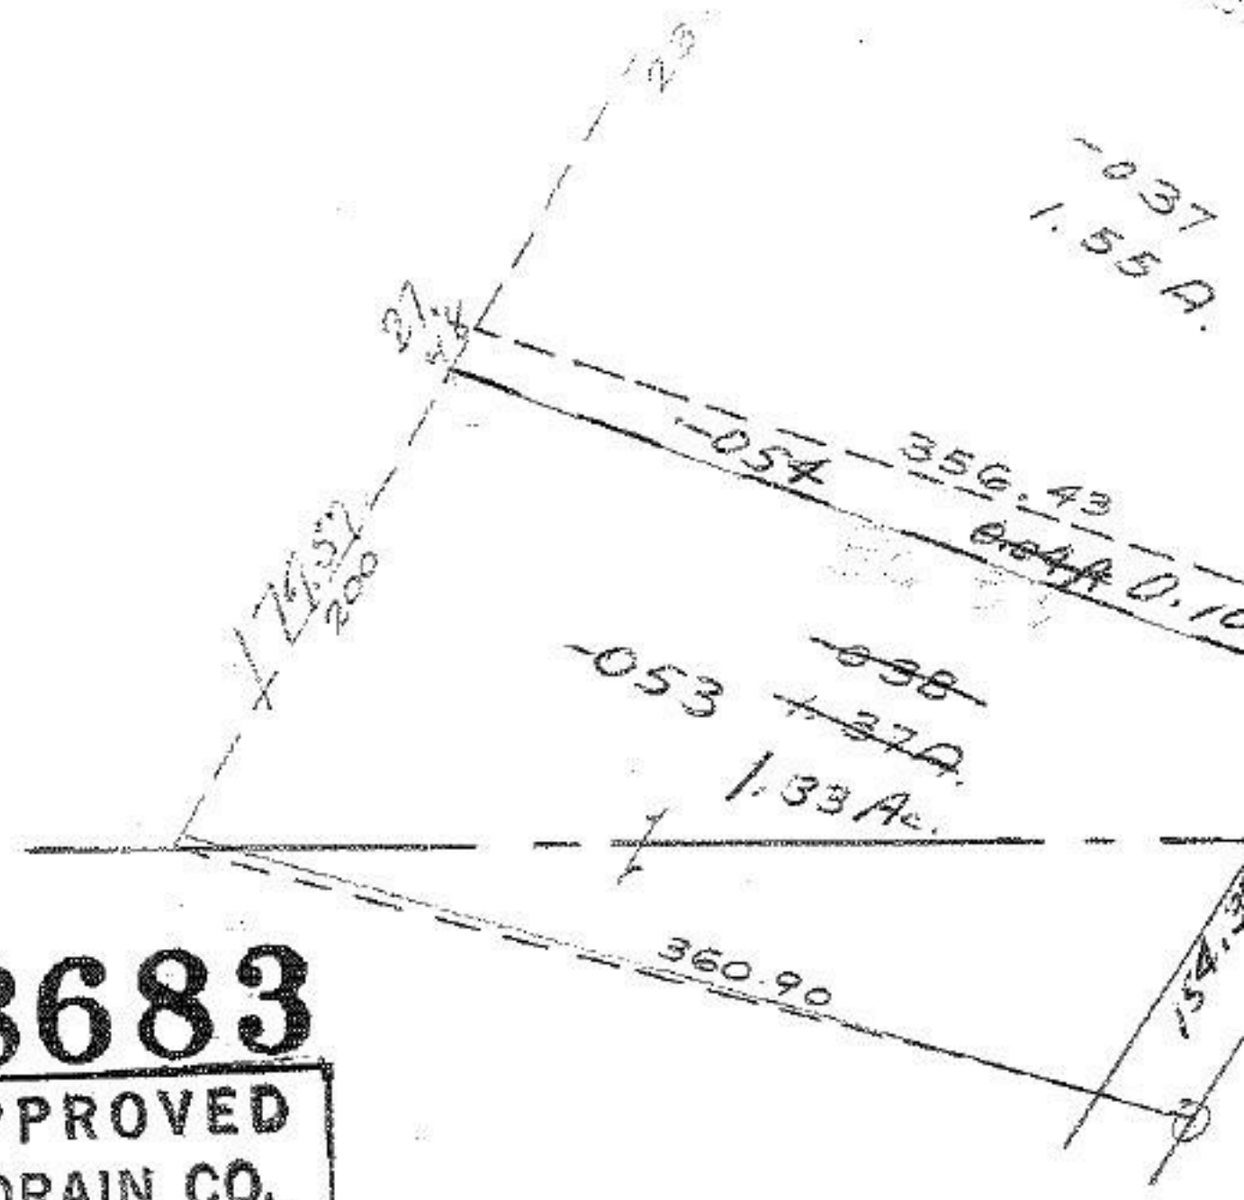

APR 10 1975

8683

APPROVED
LORAIN CO.
MAP DEPT.
DATE 4-8-75
PAGE 5-006B
BY
VOID AFTER

7-7 98-1-8

10-20-25

DEC 31 1975

AMHERST

SCALE: = 100'