


GRISWOLD

86 85

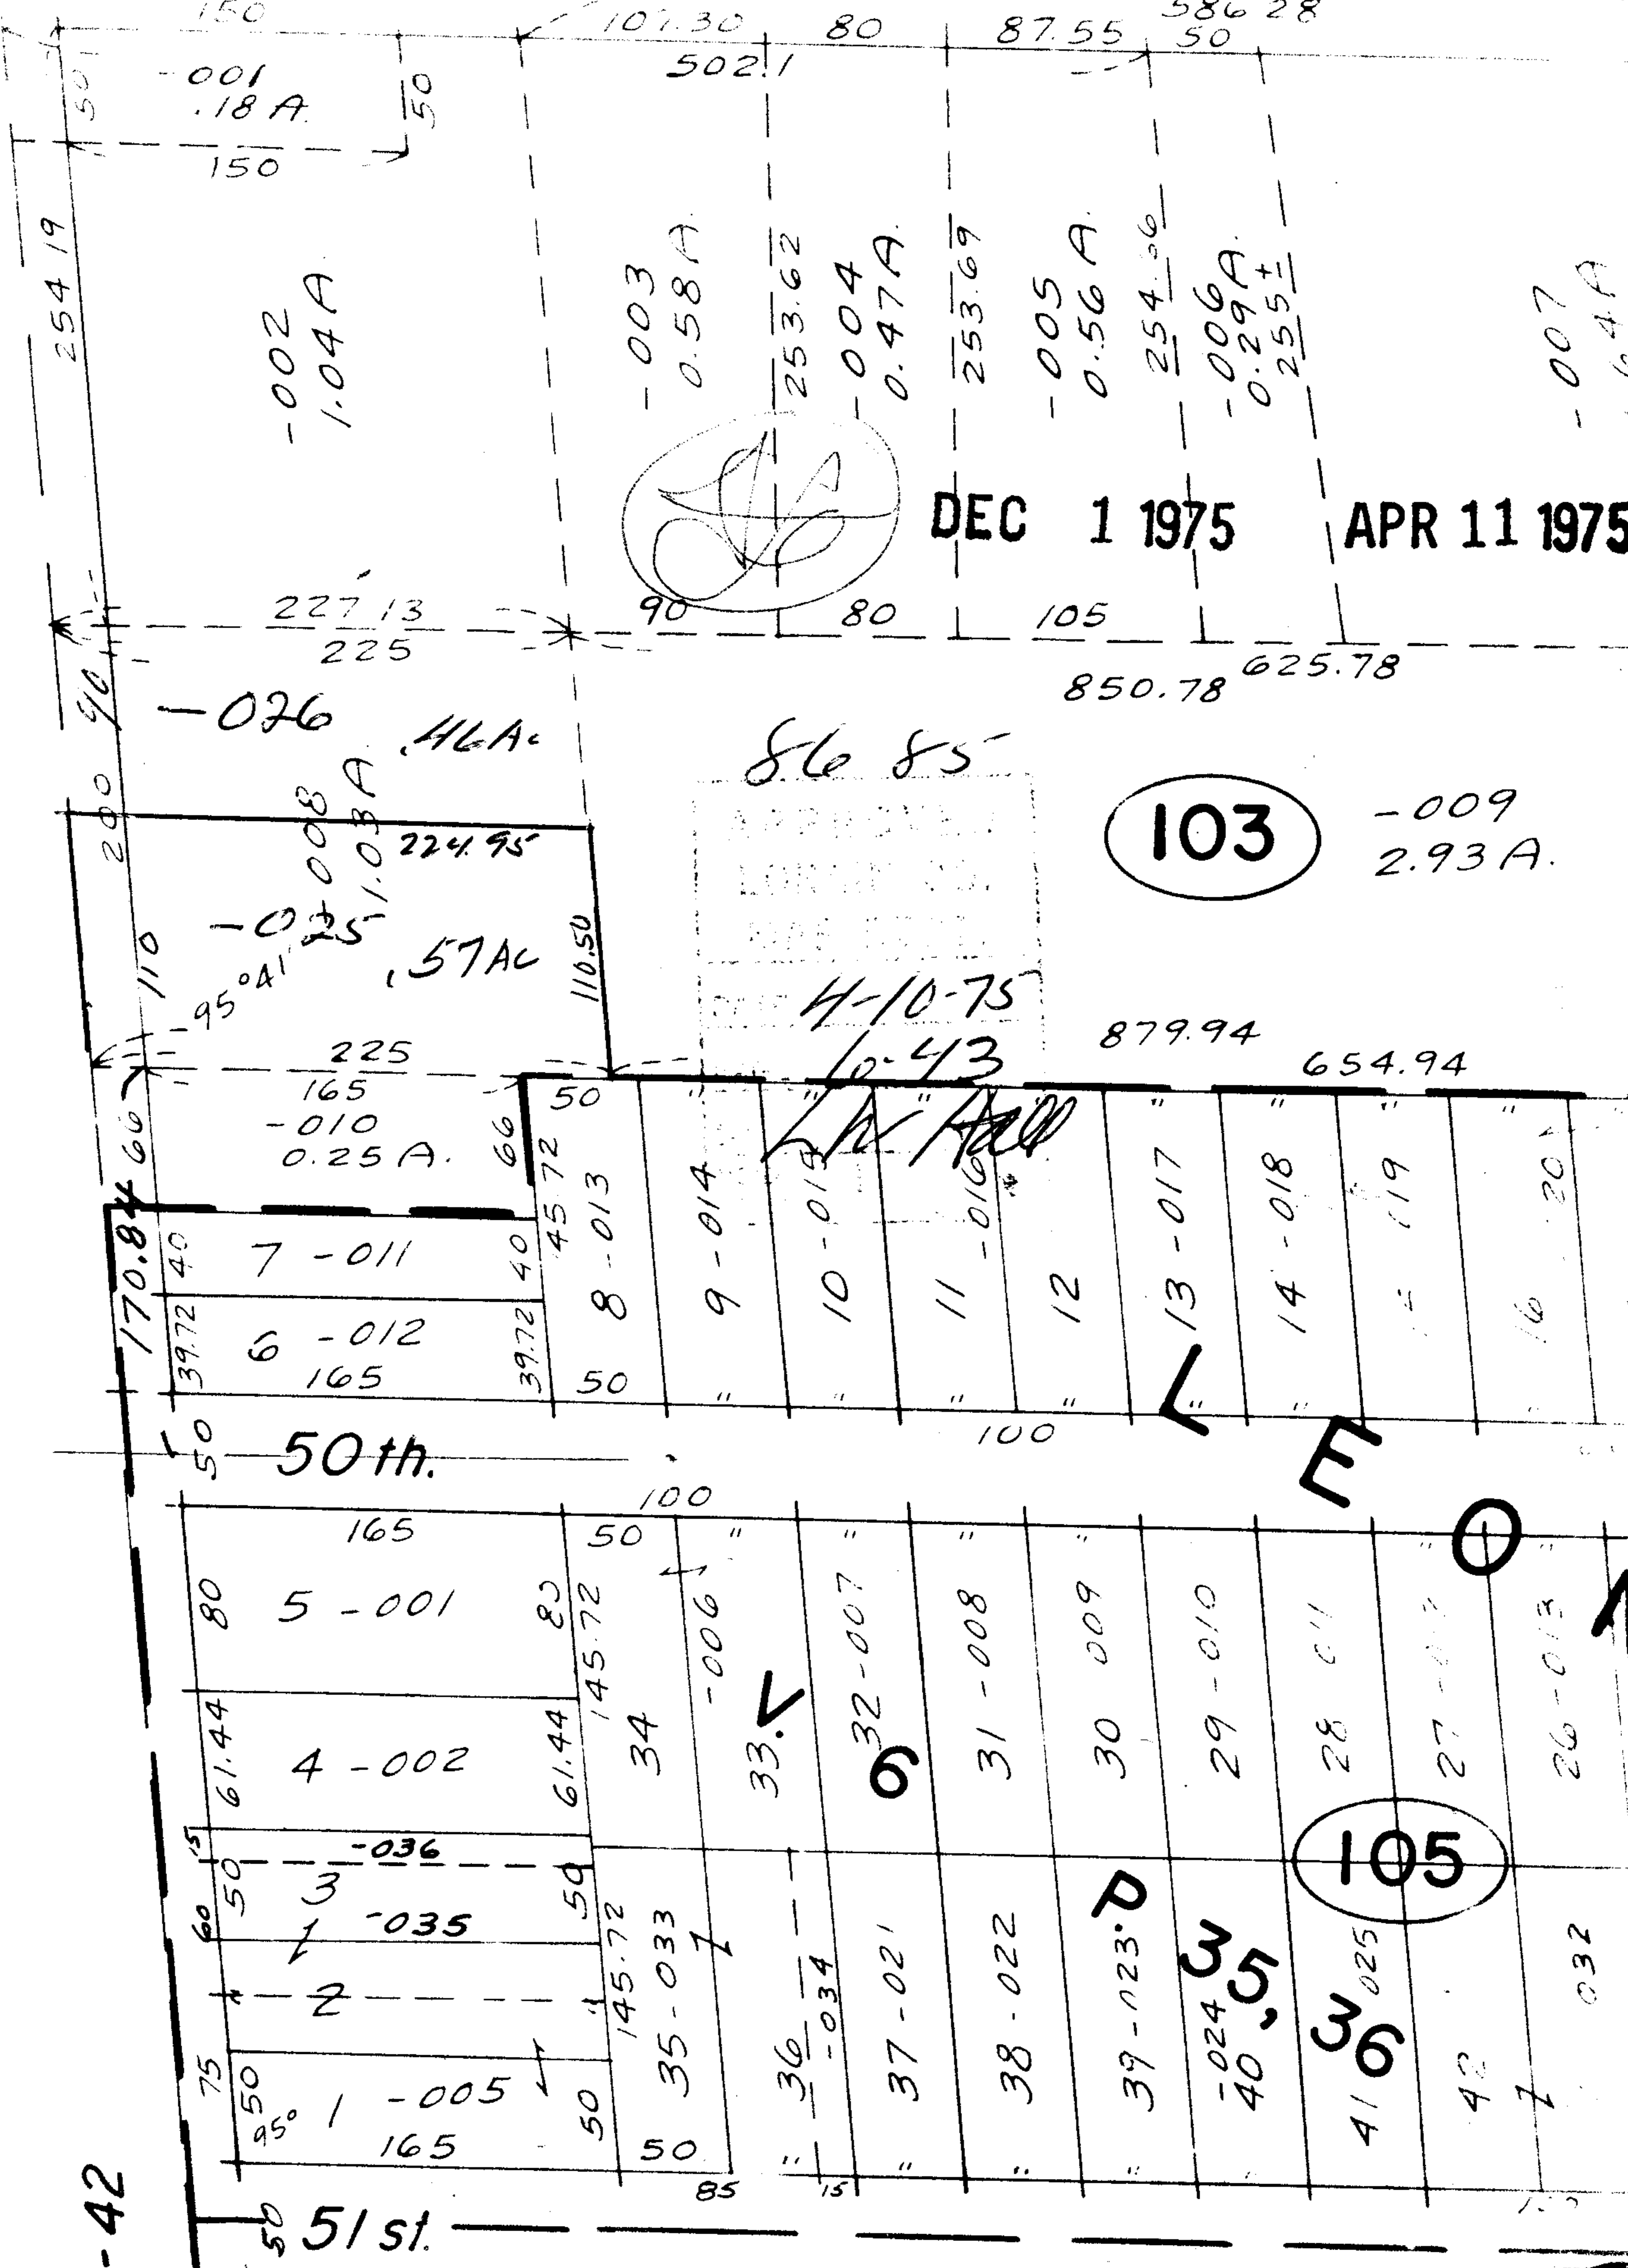

001  
18A

002  
1.04A

003  
0.58A

004  
0.47A

005  
0.56A

006  
0.29A

007  
0.64A

026  
46A

008  
1.03A

57A

010  
0.25A

7-011

6-012  
165

50th

5-001

4-002

3-036

3-035

2

1-005  
165

51st

8-013

9-014

10-013

11-016

12

13-017

14-018

15-019

16-020

33.7

32-007

31-008

30-009

29-010

28-011

27-012

26-013

105

41-025

42

032

DEC 1 1975

APR 11 1975

103

009  
2.93A

4-10-75

10-43

-42

51st

50

39.72

170.84

110

200

254.19

150

50

150

107.30

80

87.55

586.28  
50

502.1

003  
0.58A

253.62

004  
0.47A

253.69

005  
0.56A

254.56

006  
0.29A

255.1

227.13  
225

90

80

105

850.78  
625.78

225

165

110.50

224.95

008  
1.03A

46A

879.94

654.94

50

150