


SEE 6-47

8688

APR 11 1975

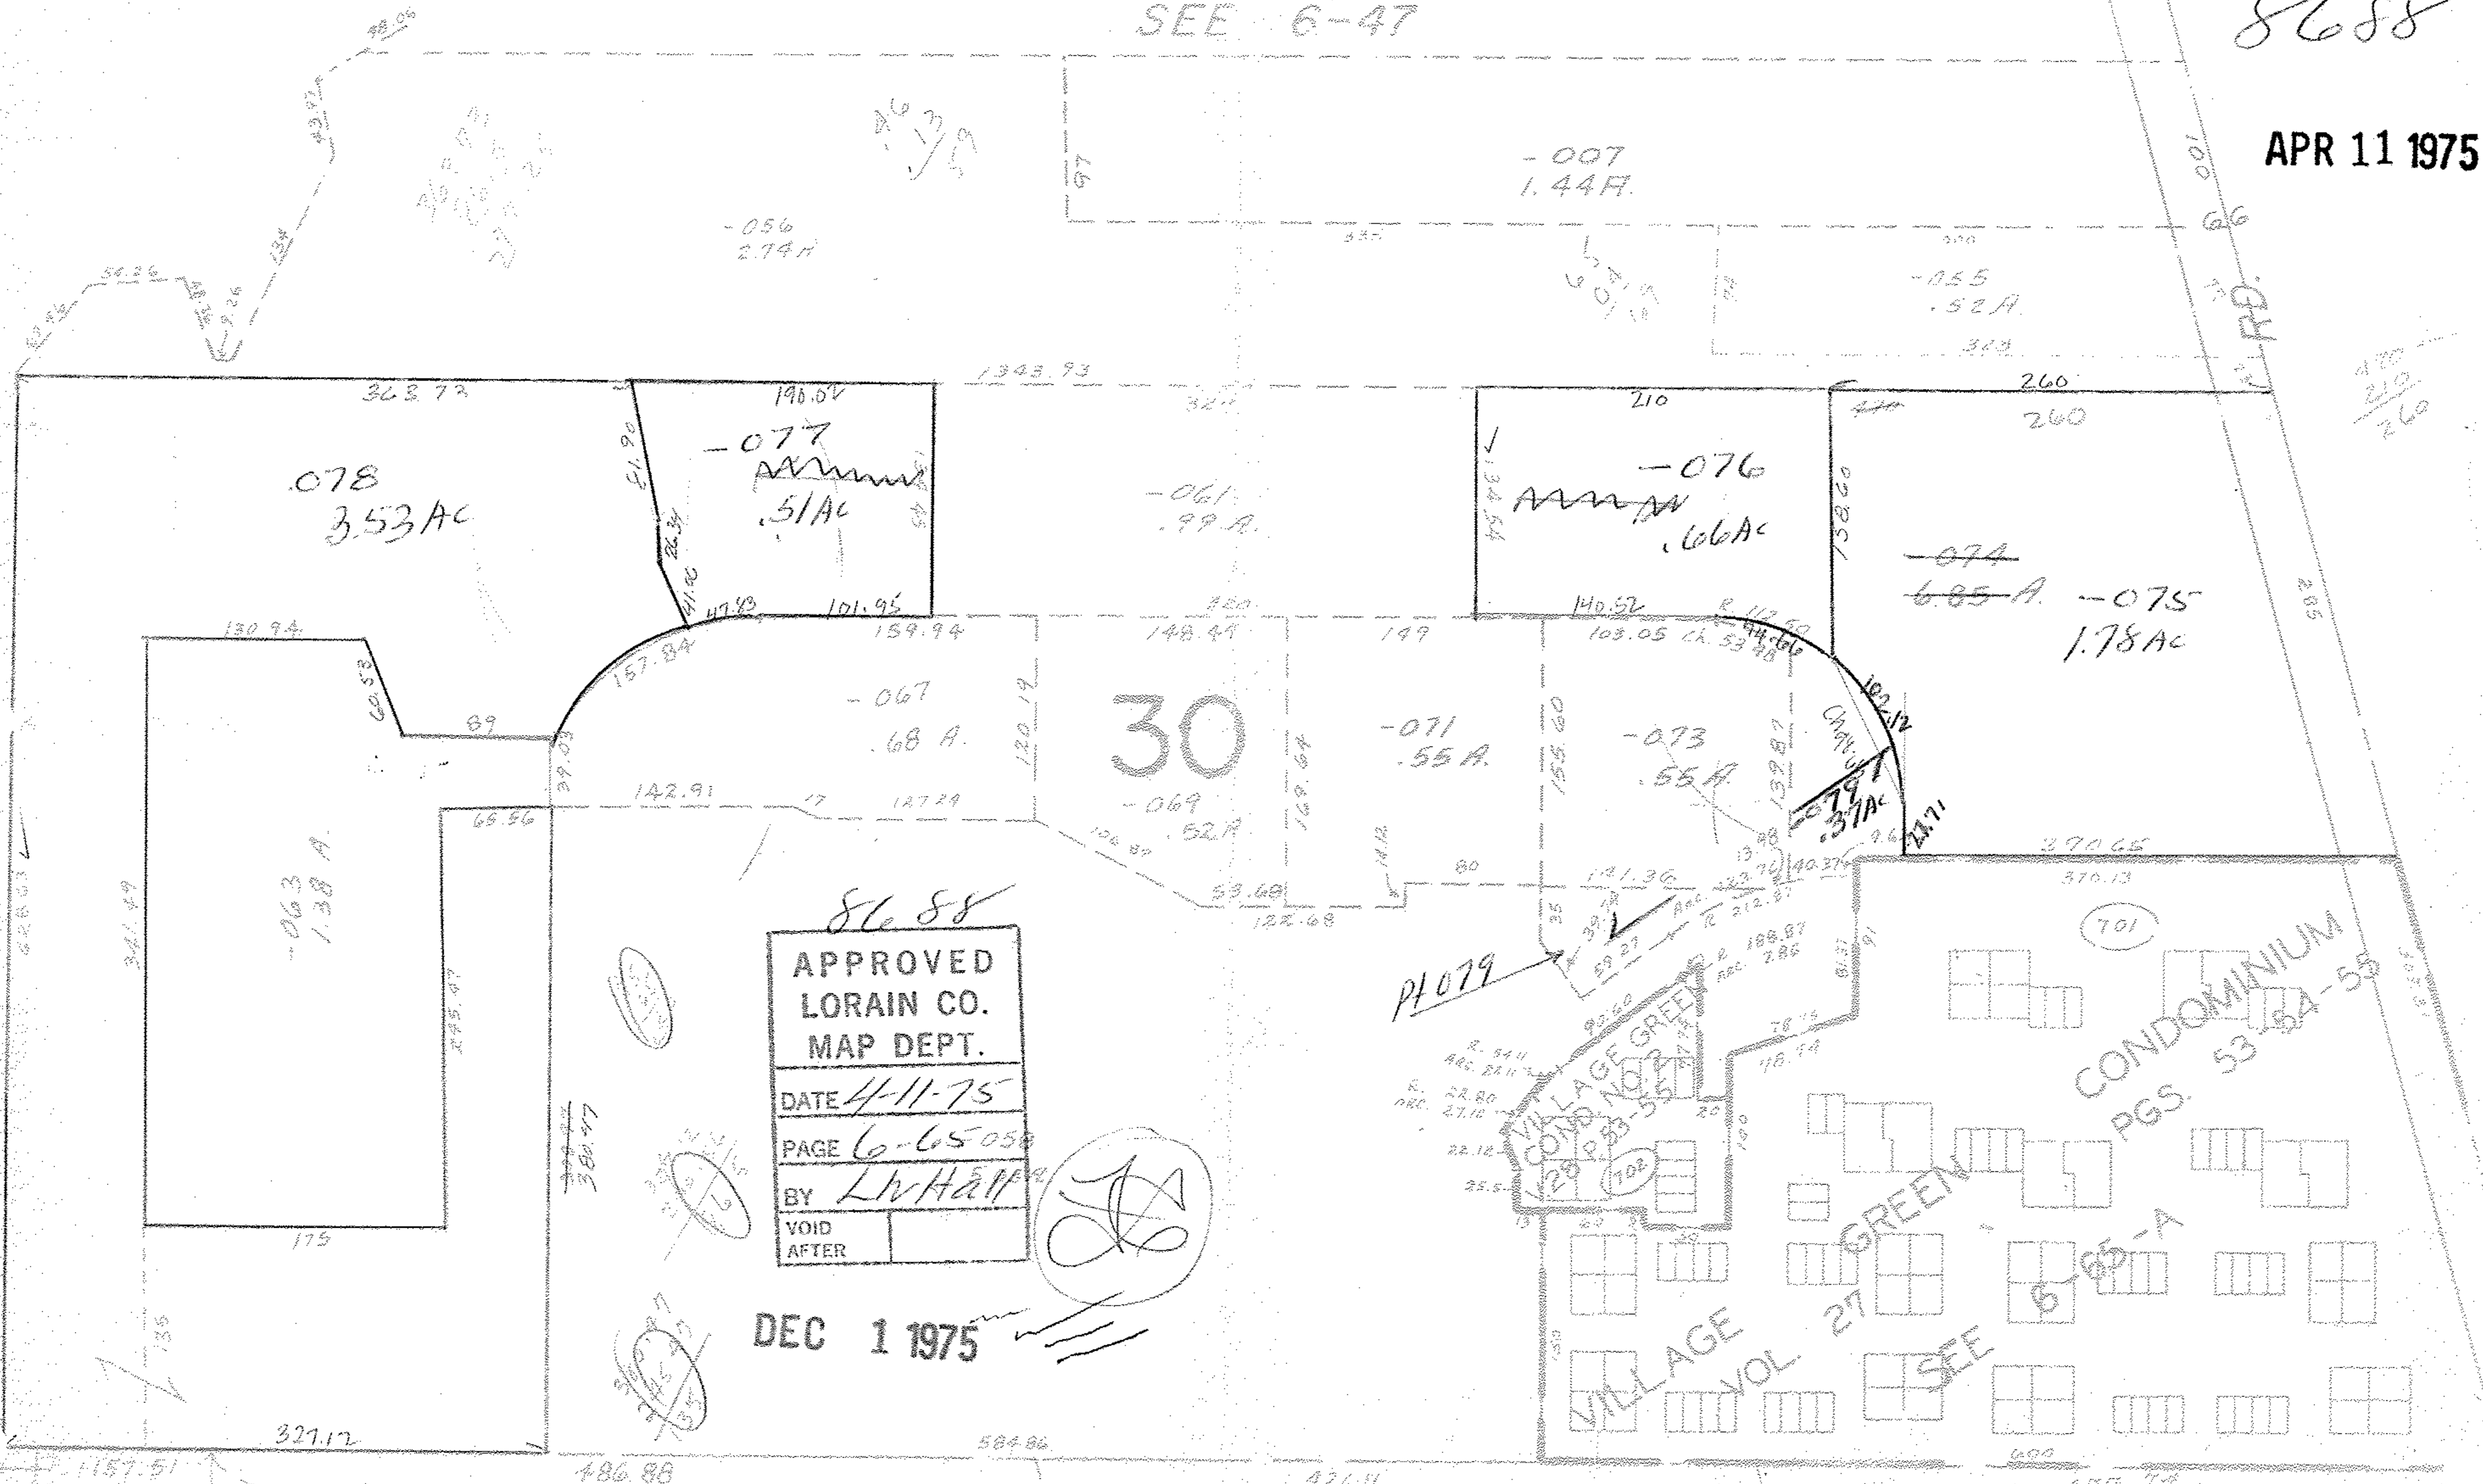

8688
APPROVED
LORAIN CO.
MAP DEPT.
 DATE 4-11-75
 PAGE 6-65058
 BY L.V. HALL
 VOID
 AFTER

DEC 1 1975

701
 CONDOMINIUM
 PGS. 53-54-55

VILLAGE GREEN
 VOL 27
 SEE