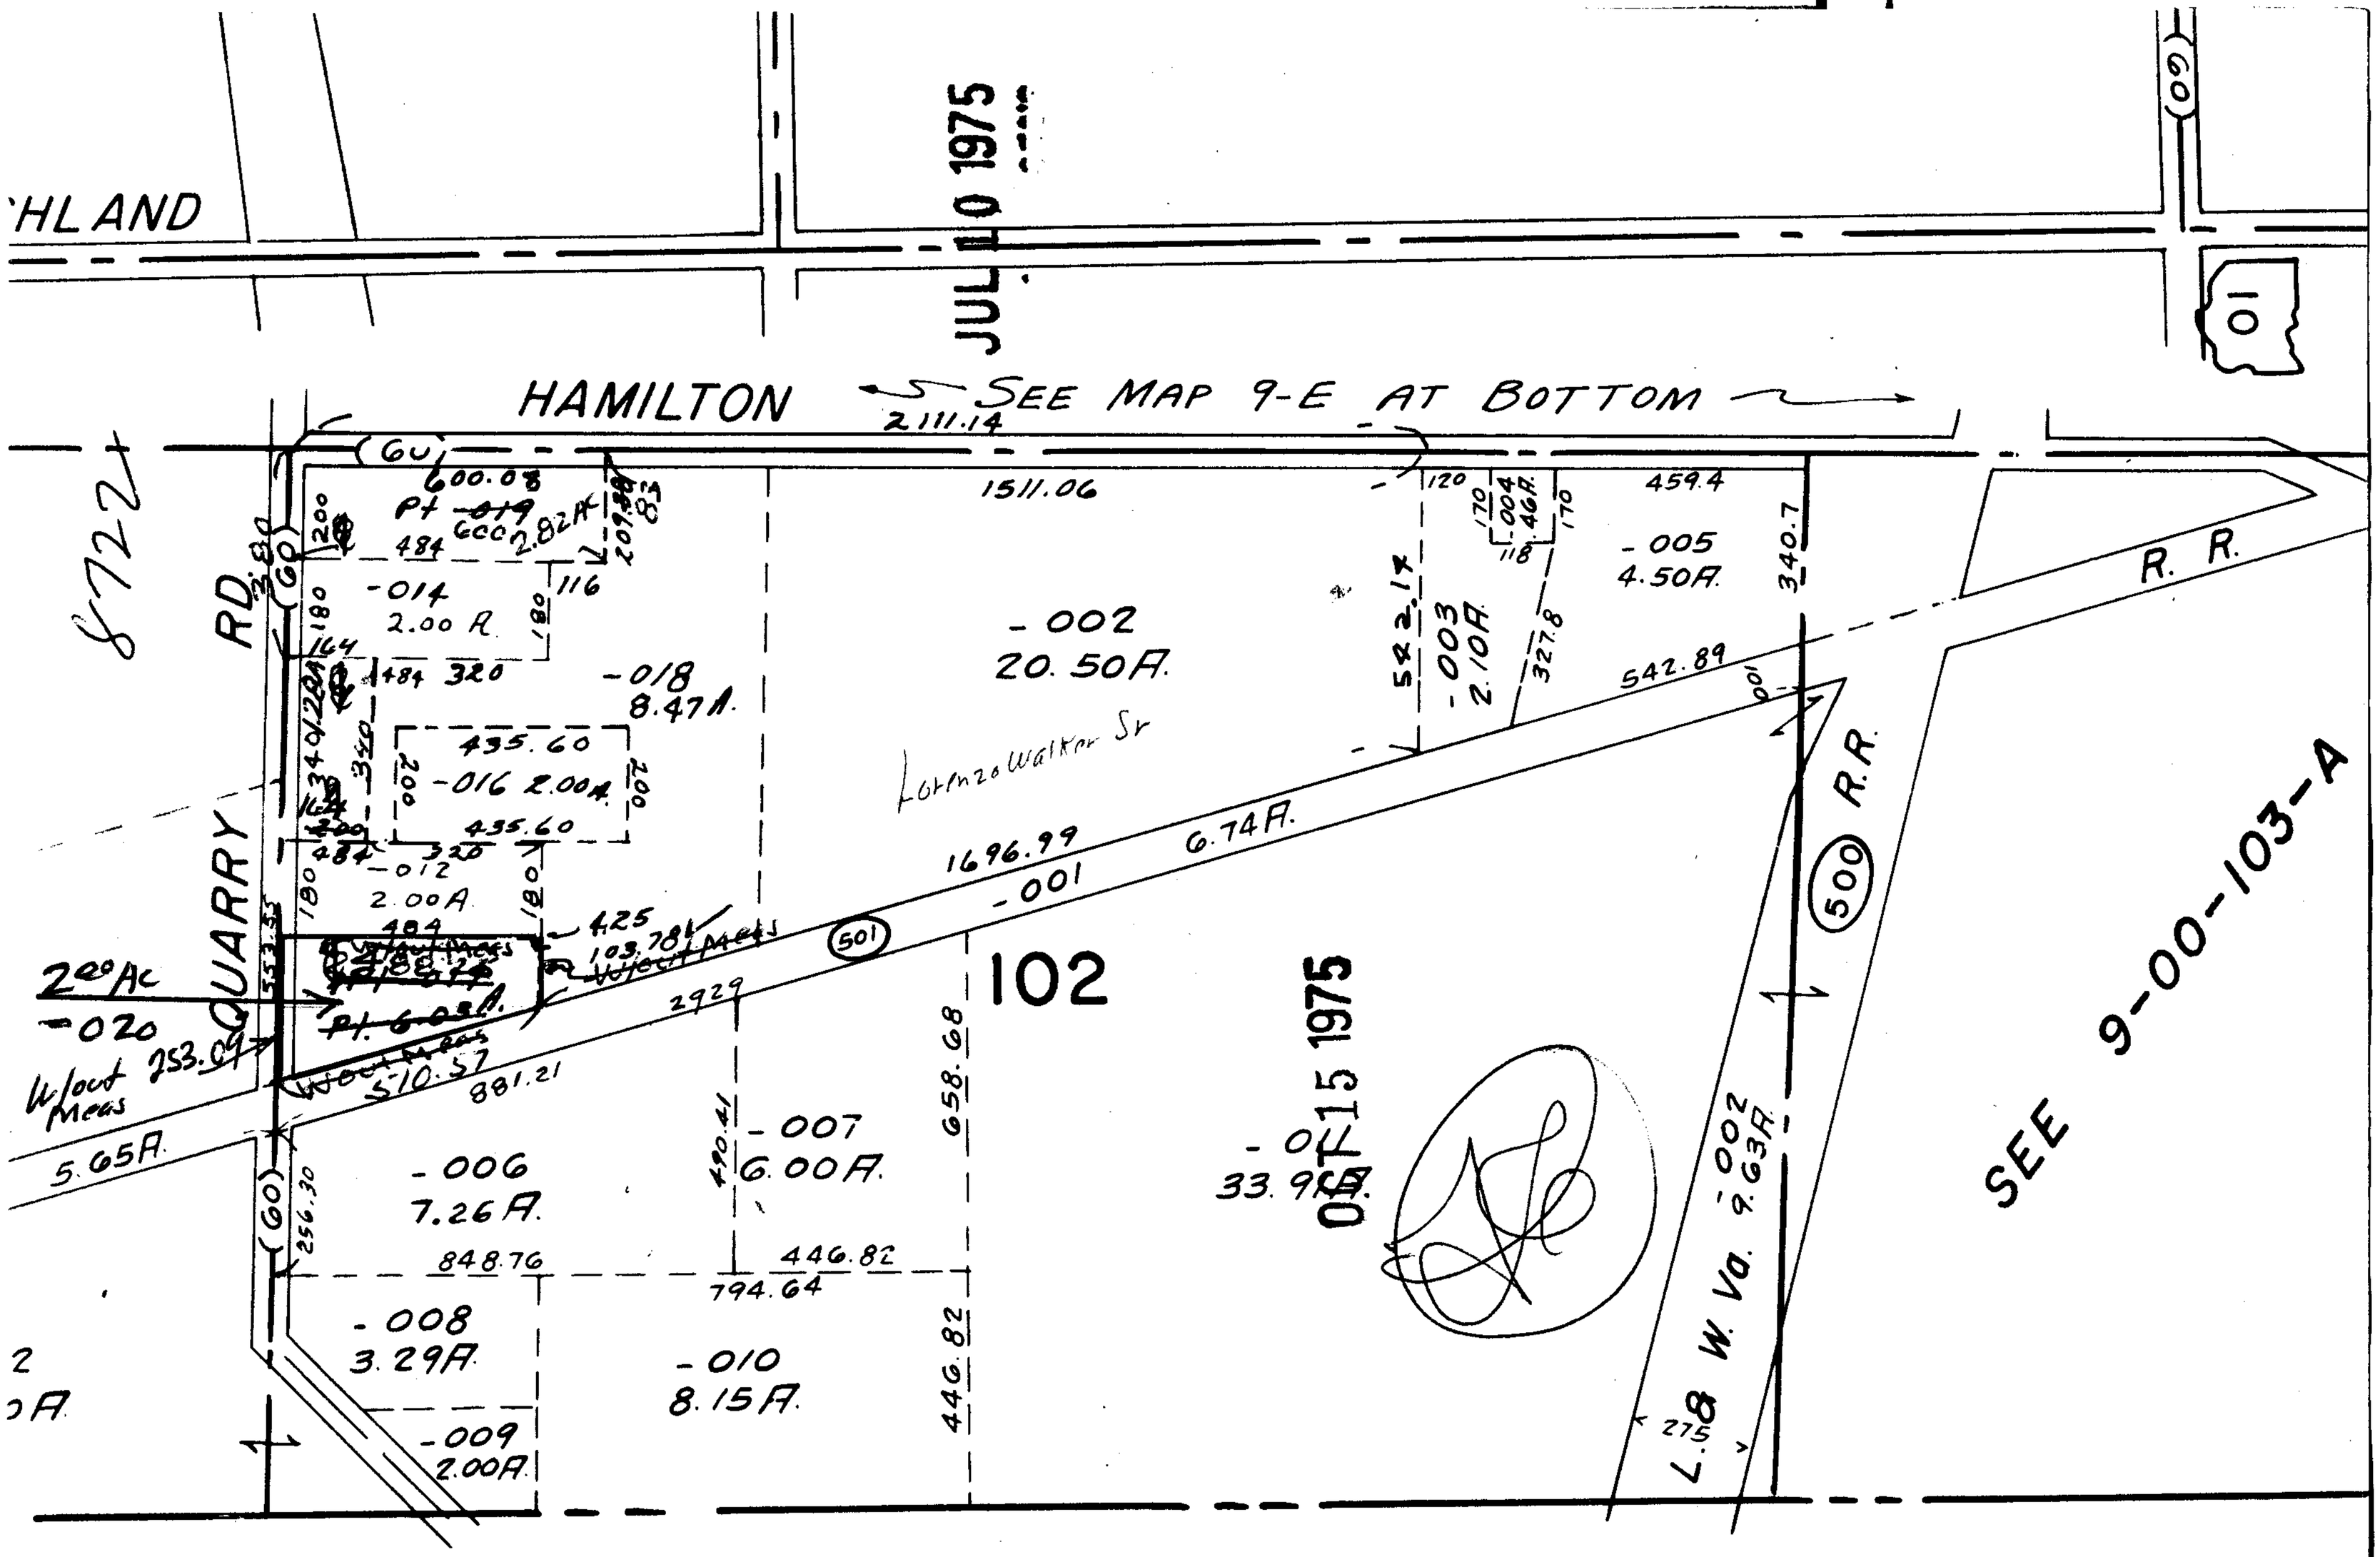

HLAND
JUL 10 1975
HAMILTON
SEE MAP 9-E AT BOTTOM
2111.14
1511.06
600.08
Pt -019
600
2.82A
484
-014
2.00 A
116
180
164
320
-018
8.47A
435.60
-016 2.00A
200
-012
2.00A
484
425
103.78
Wout Meas
2.00 Ac
-020
Wout Meas 253.09
510.57
881.21
5.65A
QUARRY RD.
-002
20.50A
Lorenzo Walker Sr
1696.99
-001
6.74A
501
102
2929
658.68
490.41
-007
6.00A
-006
7.26A
848.76
446.82
794.64
-008
3.29A
-010
8.15A
446.82
-009
2.00A
-003
2.10A
542.17
327.8
-005
4.50A
459.4
340.7
542.89
R. R.
R.R.
500
-002
9.63A
L. & W. Va.
275
SEE 9-00-103-A
OCT 15 1975