


SEE 5-00-017-A

19.25  
82.50  
101.75  
95.75

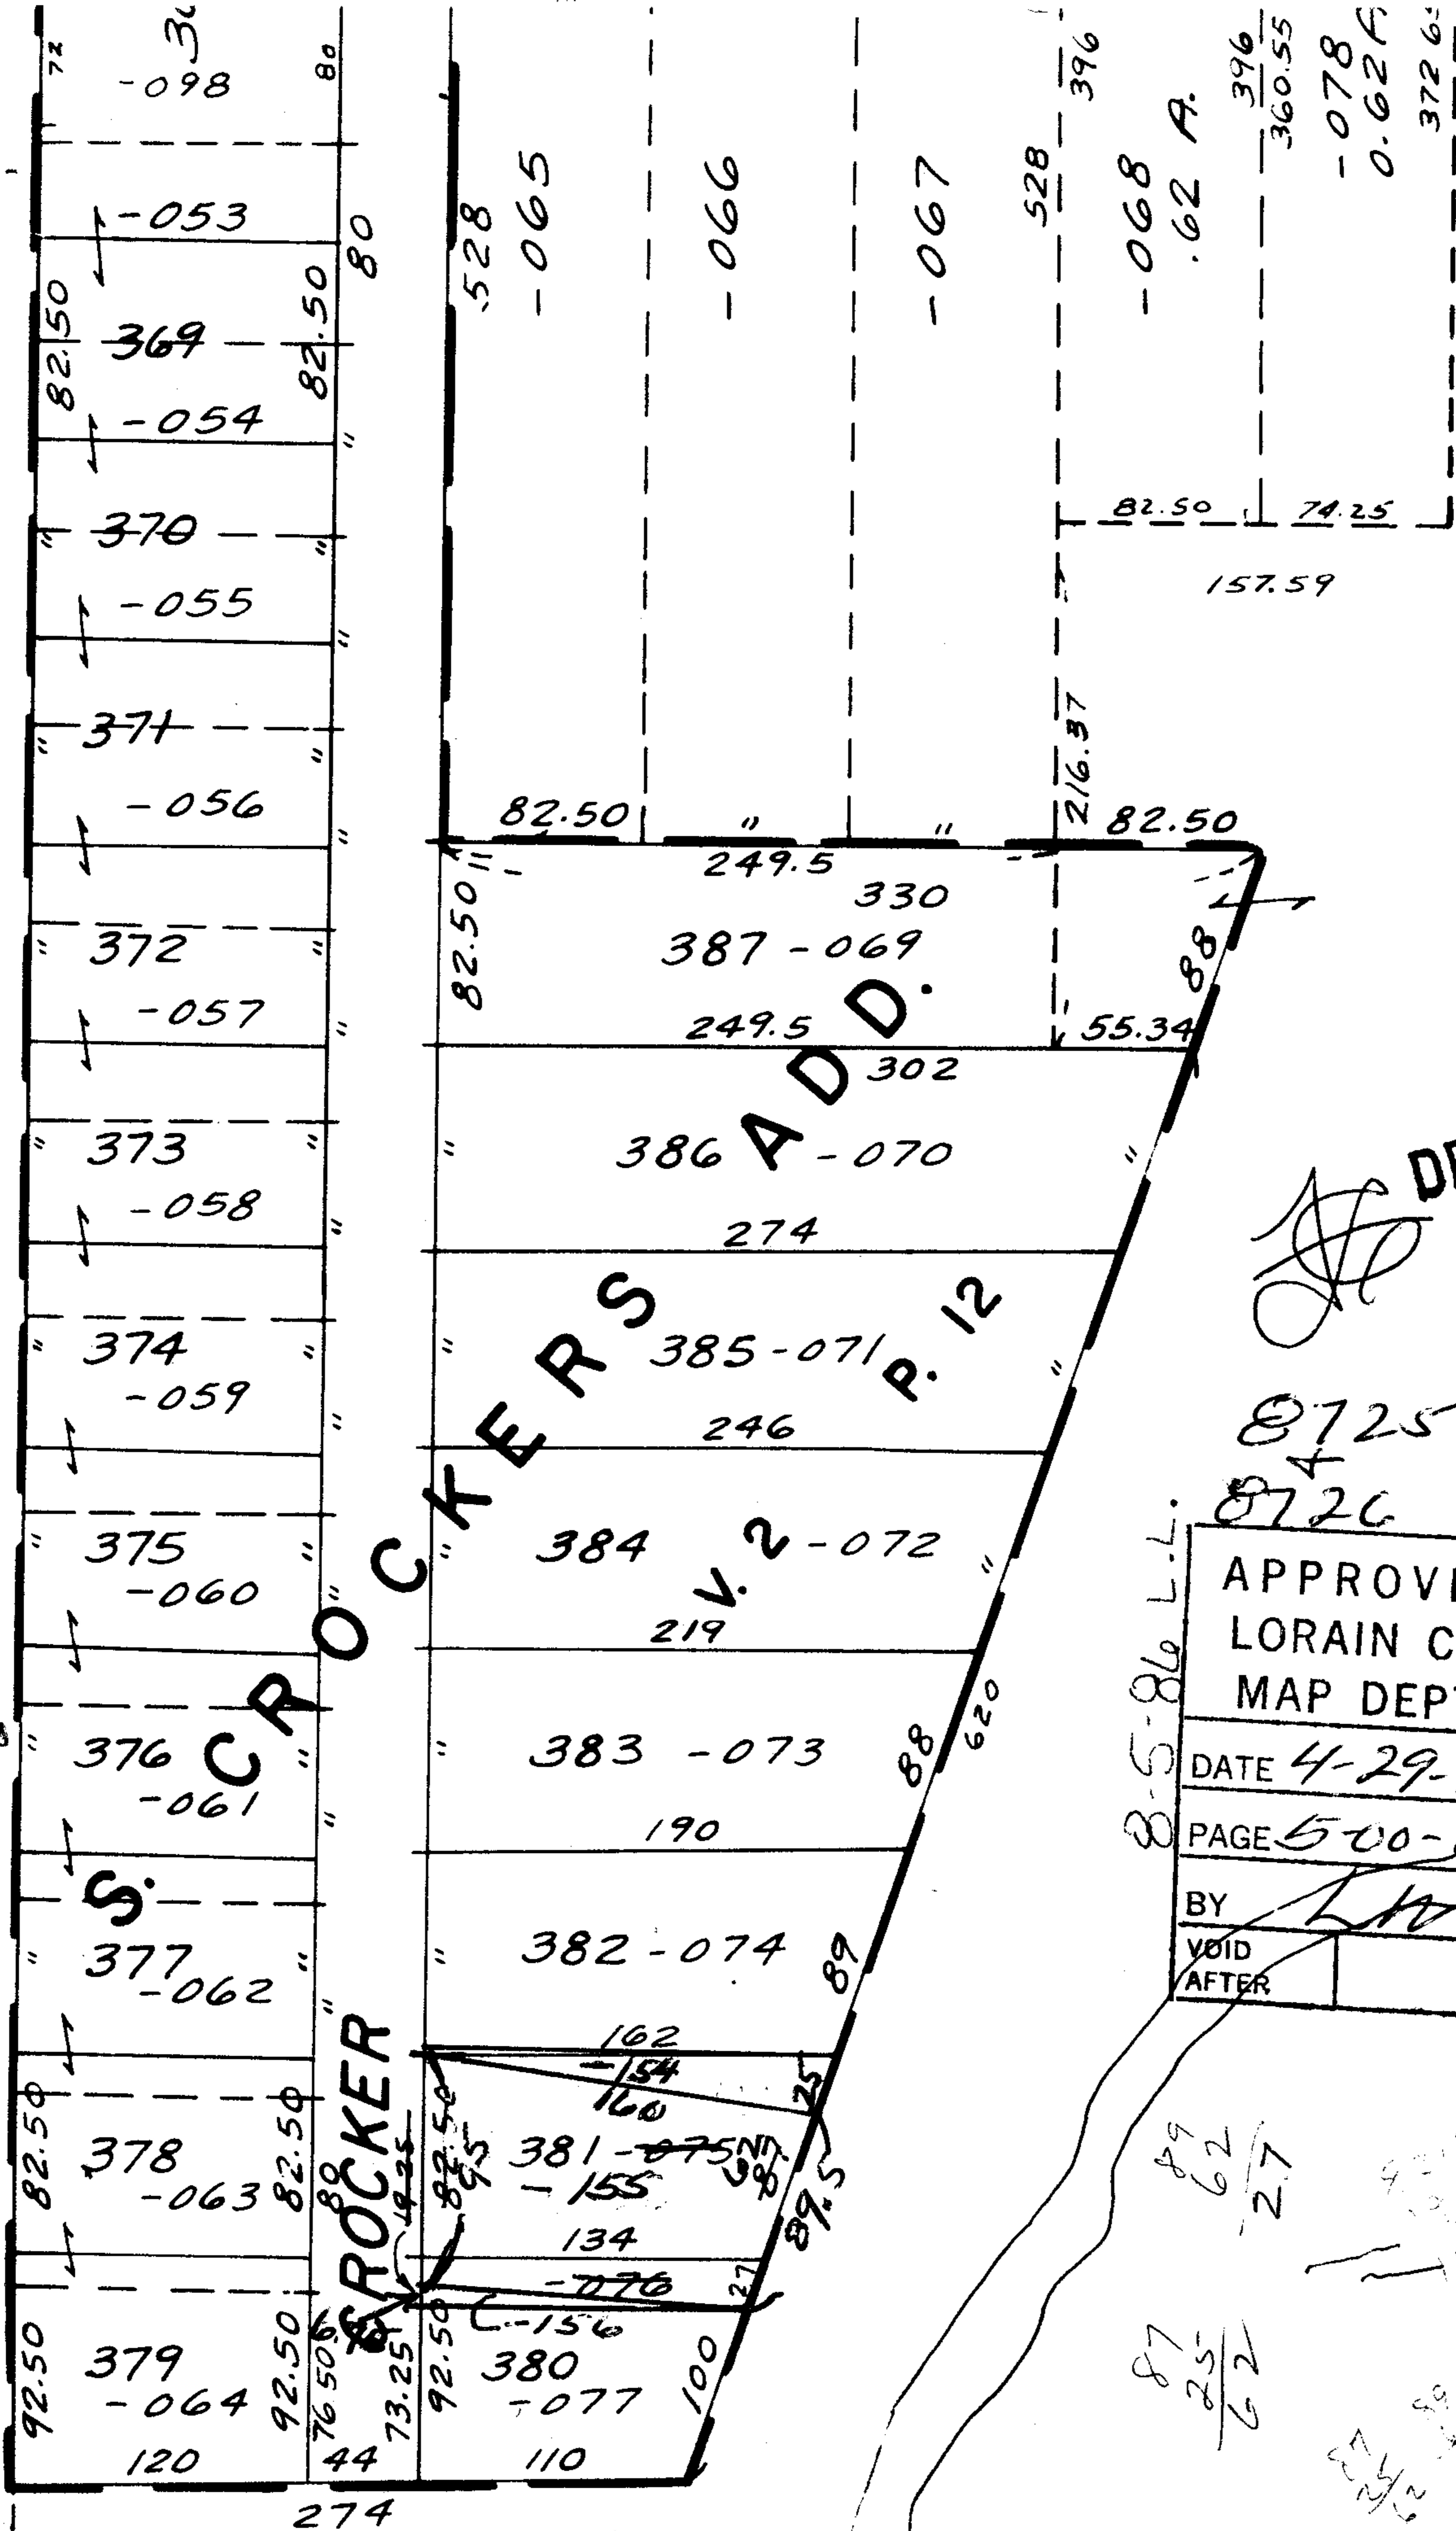

MAY 1 1975

8725  
And  
8726

DEC 31 1975

8725  
8726

APPROVED
LORAIN CO.
MAP DEPT.
DATE 4-29-75
PAGE 500-017B
BY <i>L.W. Hall</i>
VOID AFTER


87  
25  
62  
89  
62  
27

Handwritten notes and signatures, including a signature that appears to be 'L.W. Hall' and some illegible scribbles.

669.93