


18

MEDINA - NORWALK 8727

MAY 1 1975

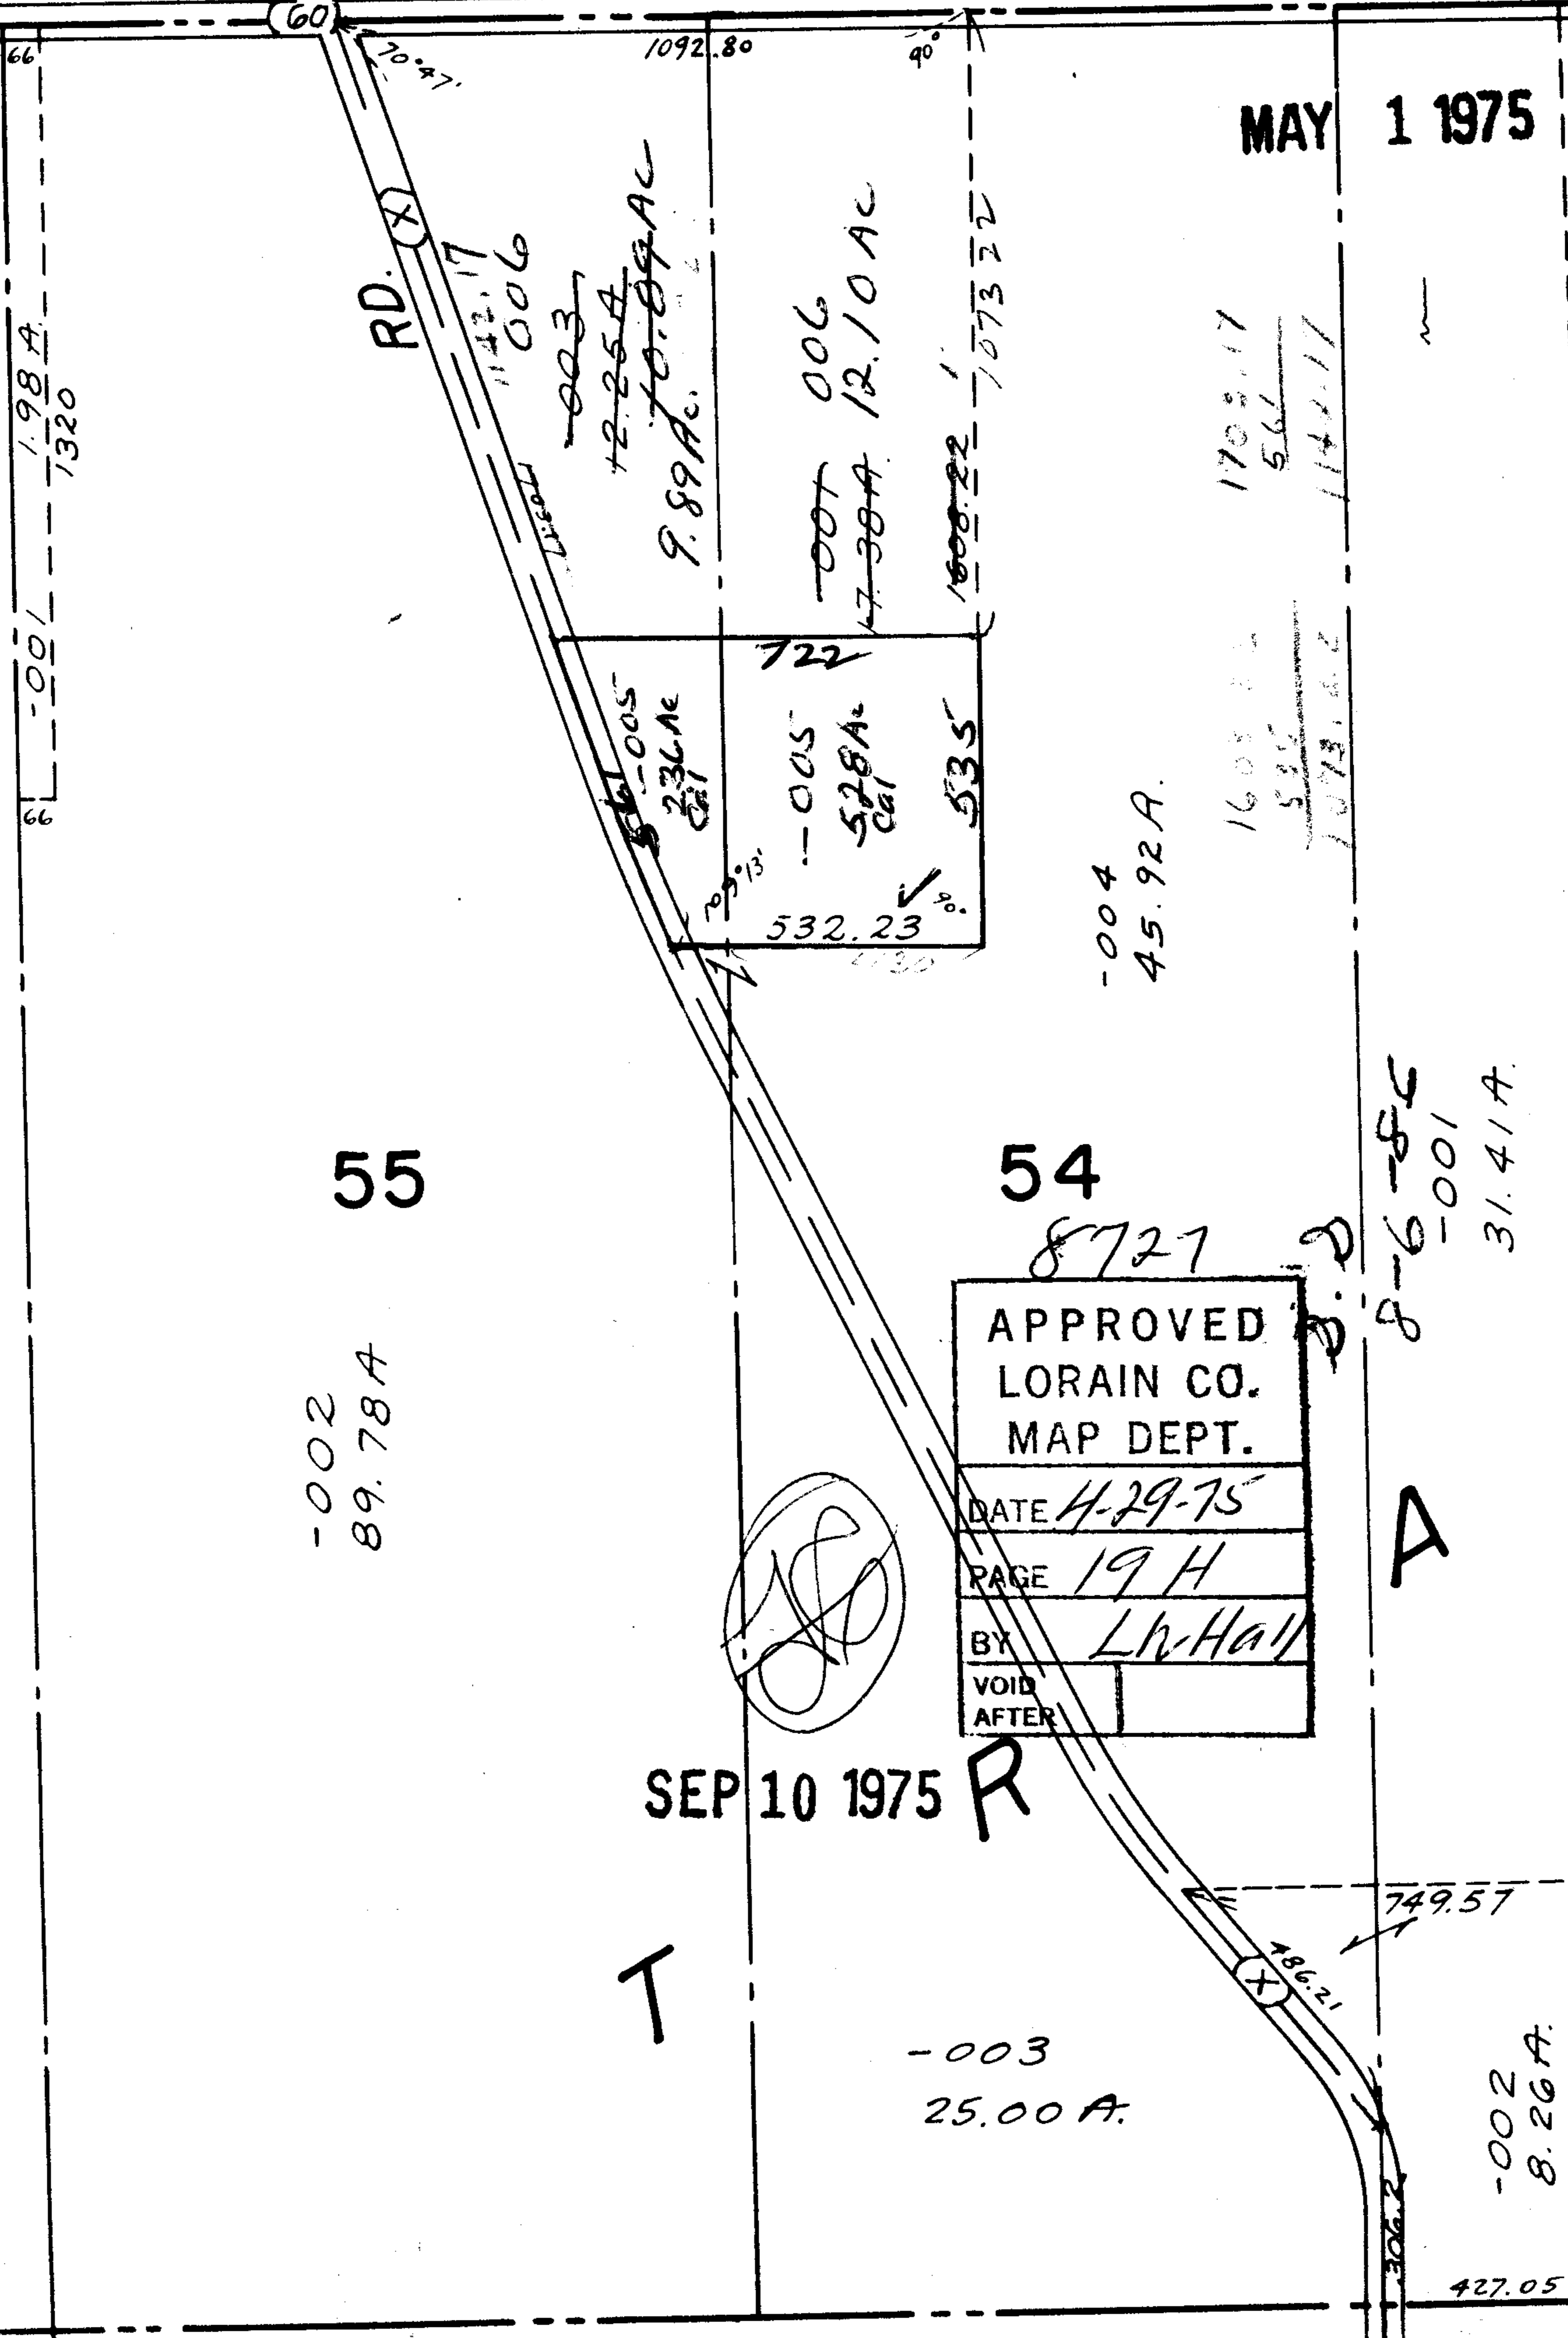

8727

| |
|--------------|
| APPROVED |
| LORAIN CO. |
| MAP DEPT. |
| DATE 4-29-75 |
| PAGE 19 H |
| BY L.H. Hall |
| VOID AFTER |

SEP 10 1975 R

8-6-86
-001
31.41 A.

3862.98

-002
8.26 A.

695.6

427.05