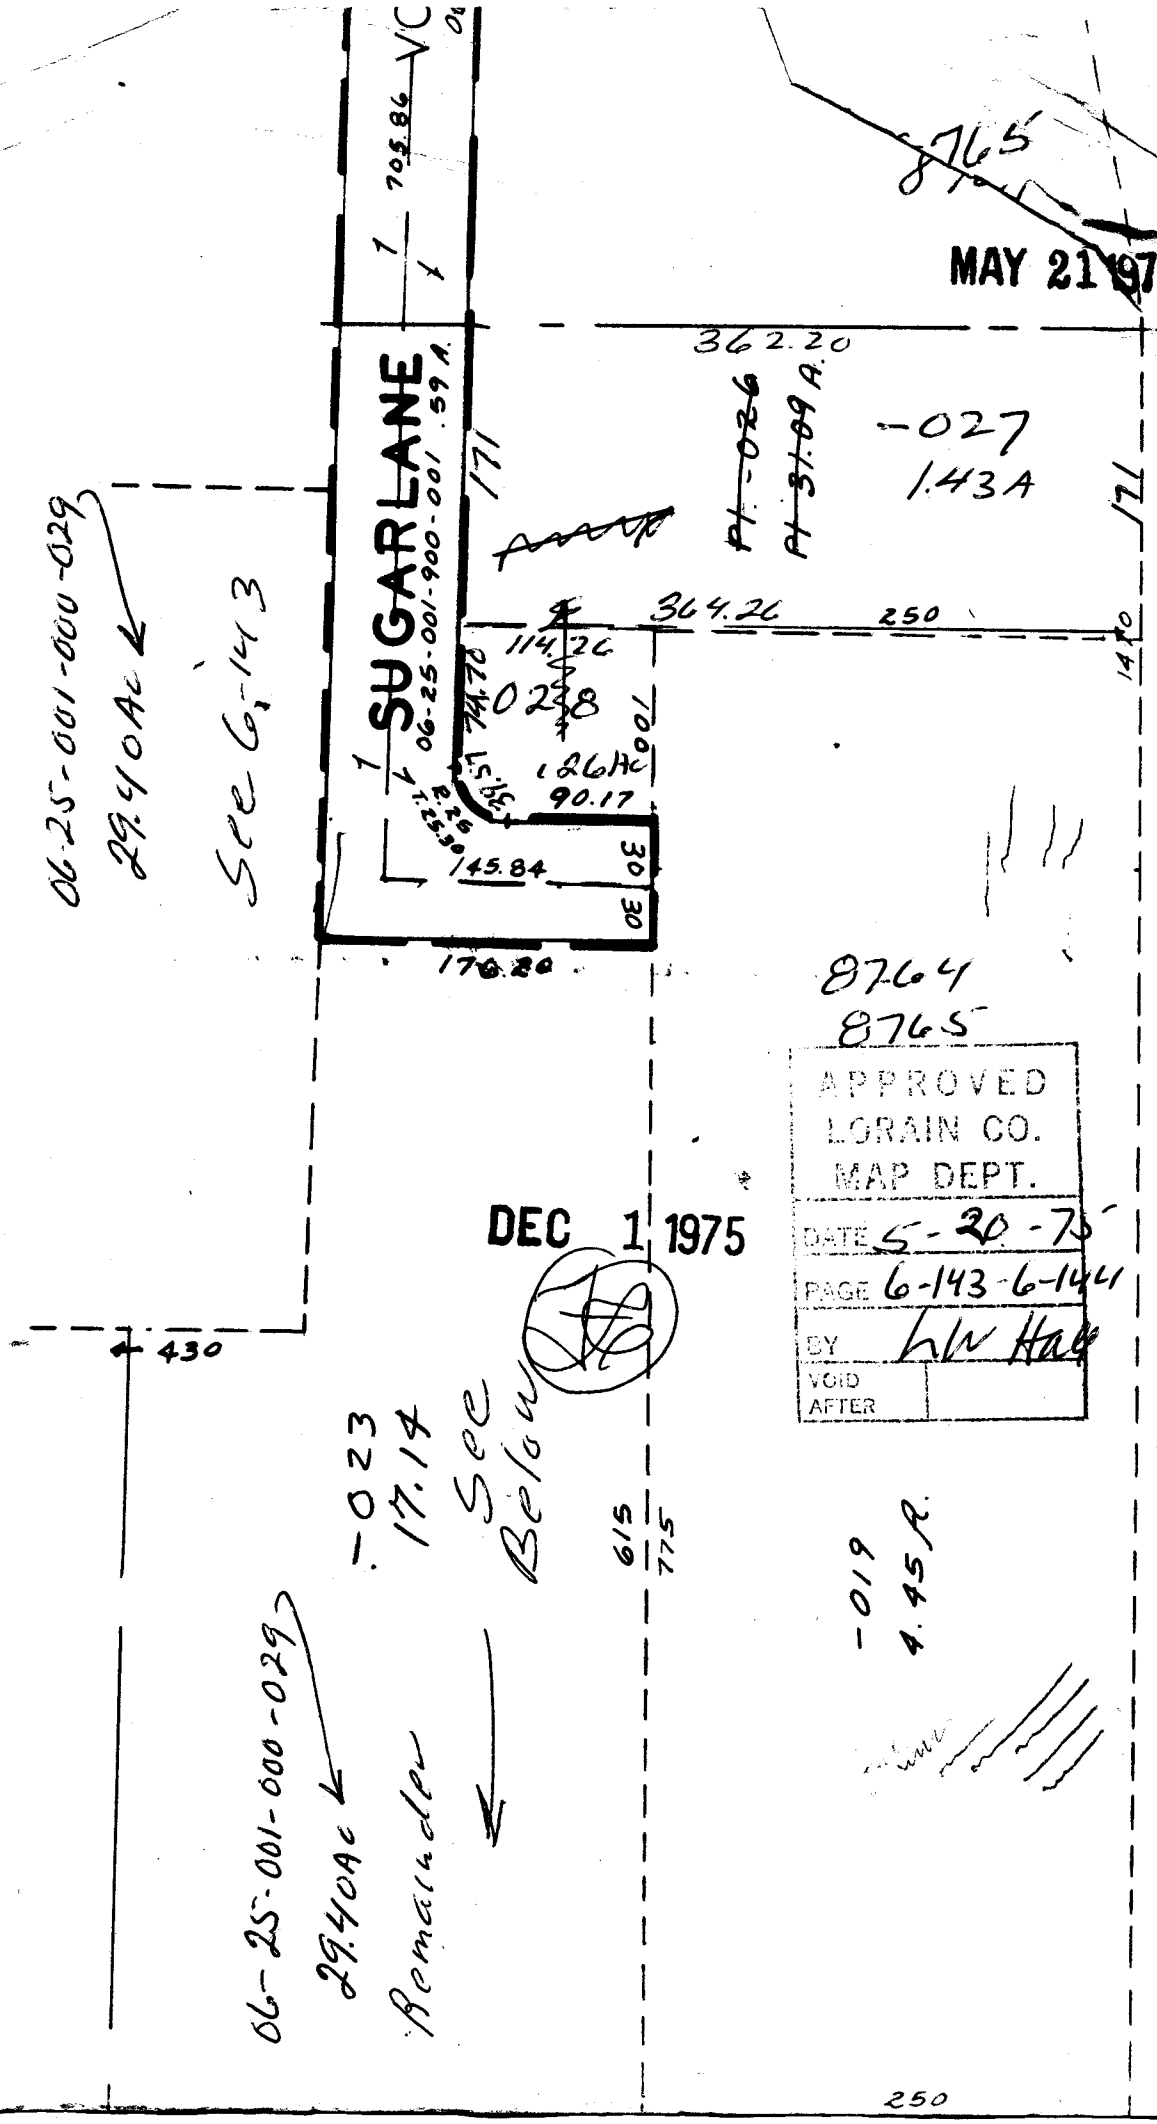
8765
MAY 21 1975
705.86
VC
362.20
SUGAR LANE
06-25-001-900-001 .59 A.
171
Pt. -026
Pt. 31.09 A.
-027
1.43A
06-25-001-000-029
29.40Ac
See 6-143
364.26
250
114.26
0238
1.26Ac
90.17
145.84
30
30
170.20
14.70
8764
8765
APPROVED
LORAIN CO.
MAP DEPT.
DATE 5-20-75
PAGE 6-143-6-144
BY LW Hall
VOID AFTER
DEC 1 1975
430
-023
17.14
See Below
615
775
-019
4.45A.
06-25-001-000-029
29.40Ac
Remainder
250