8767
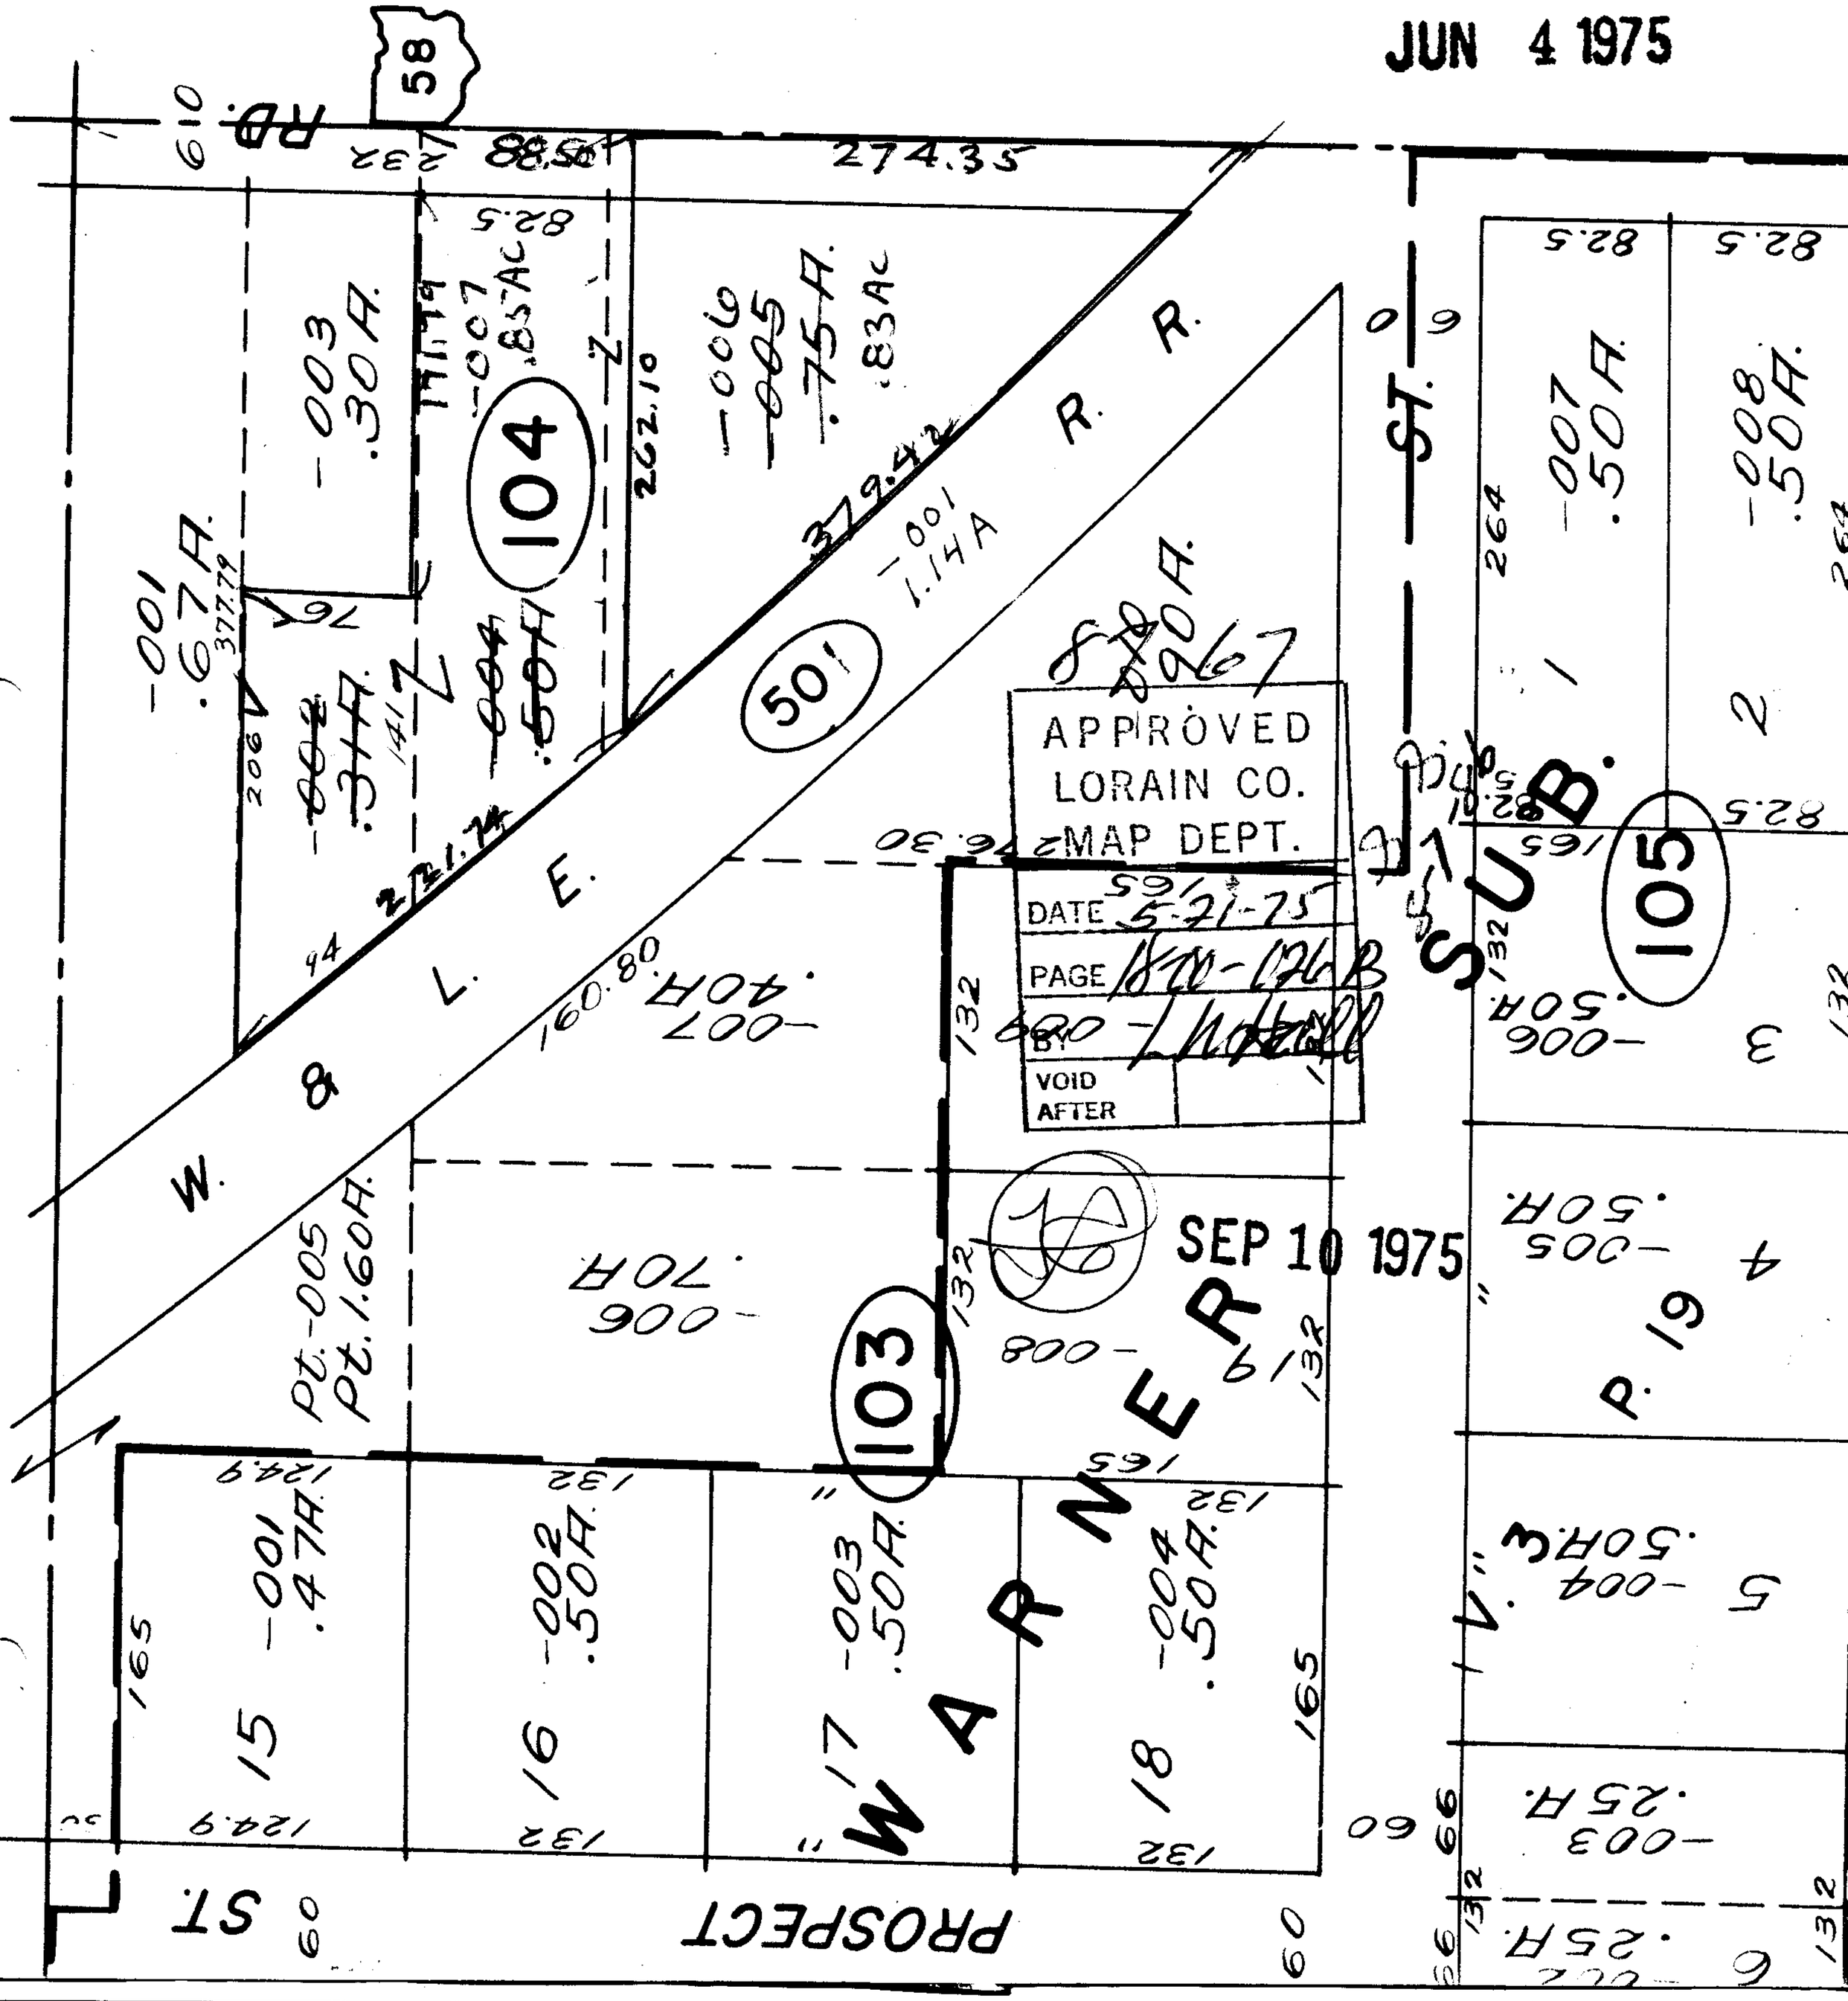
JUN 4 1975