# ARLISLE TWP.

E: = 400'

8768

SECS. S.E. 17, E. 1/2 18

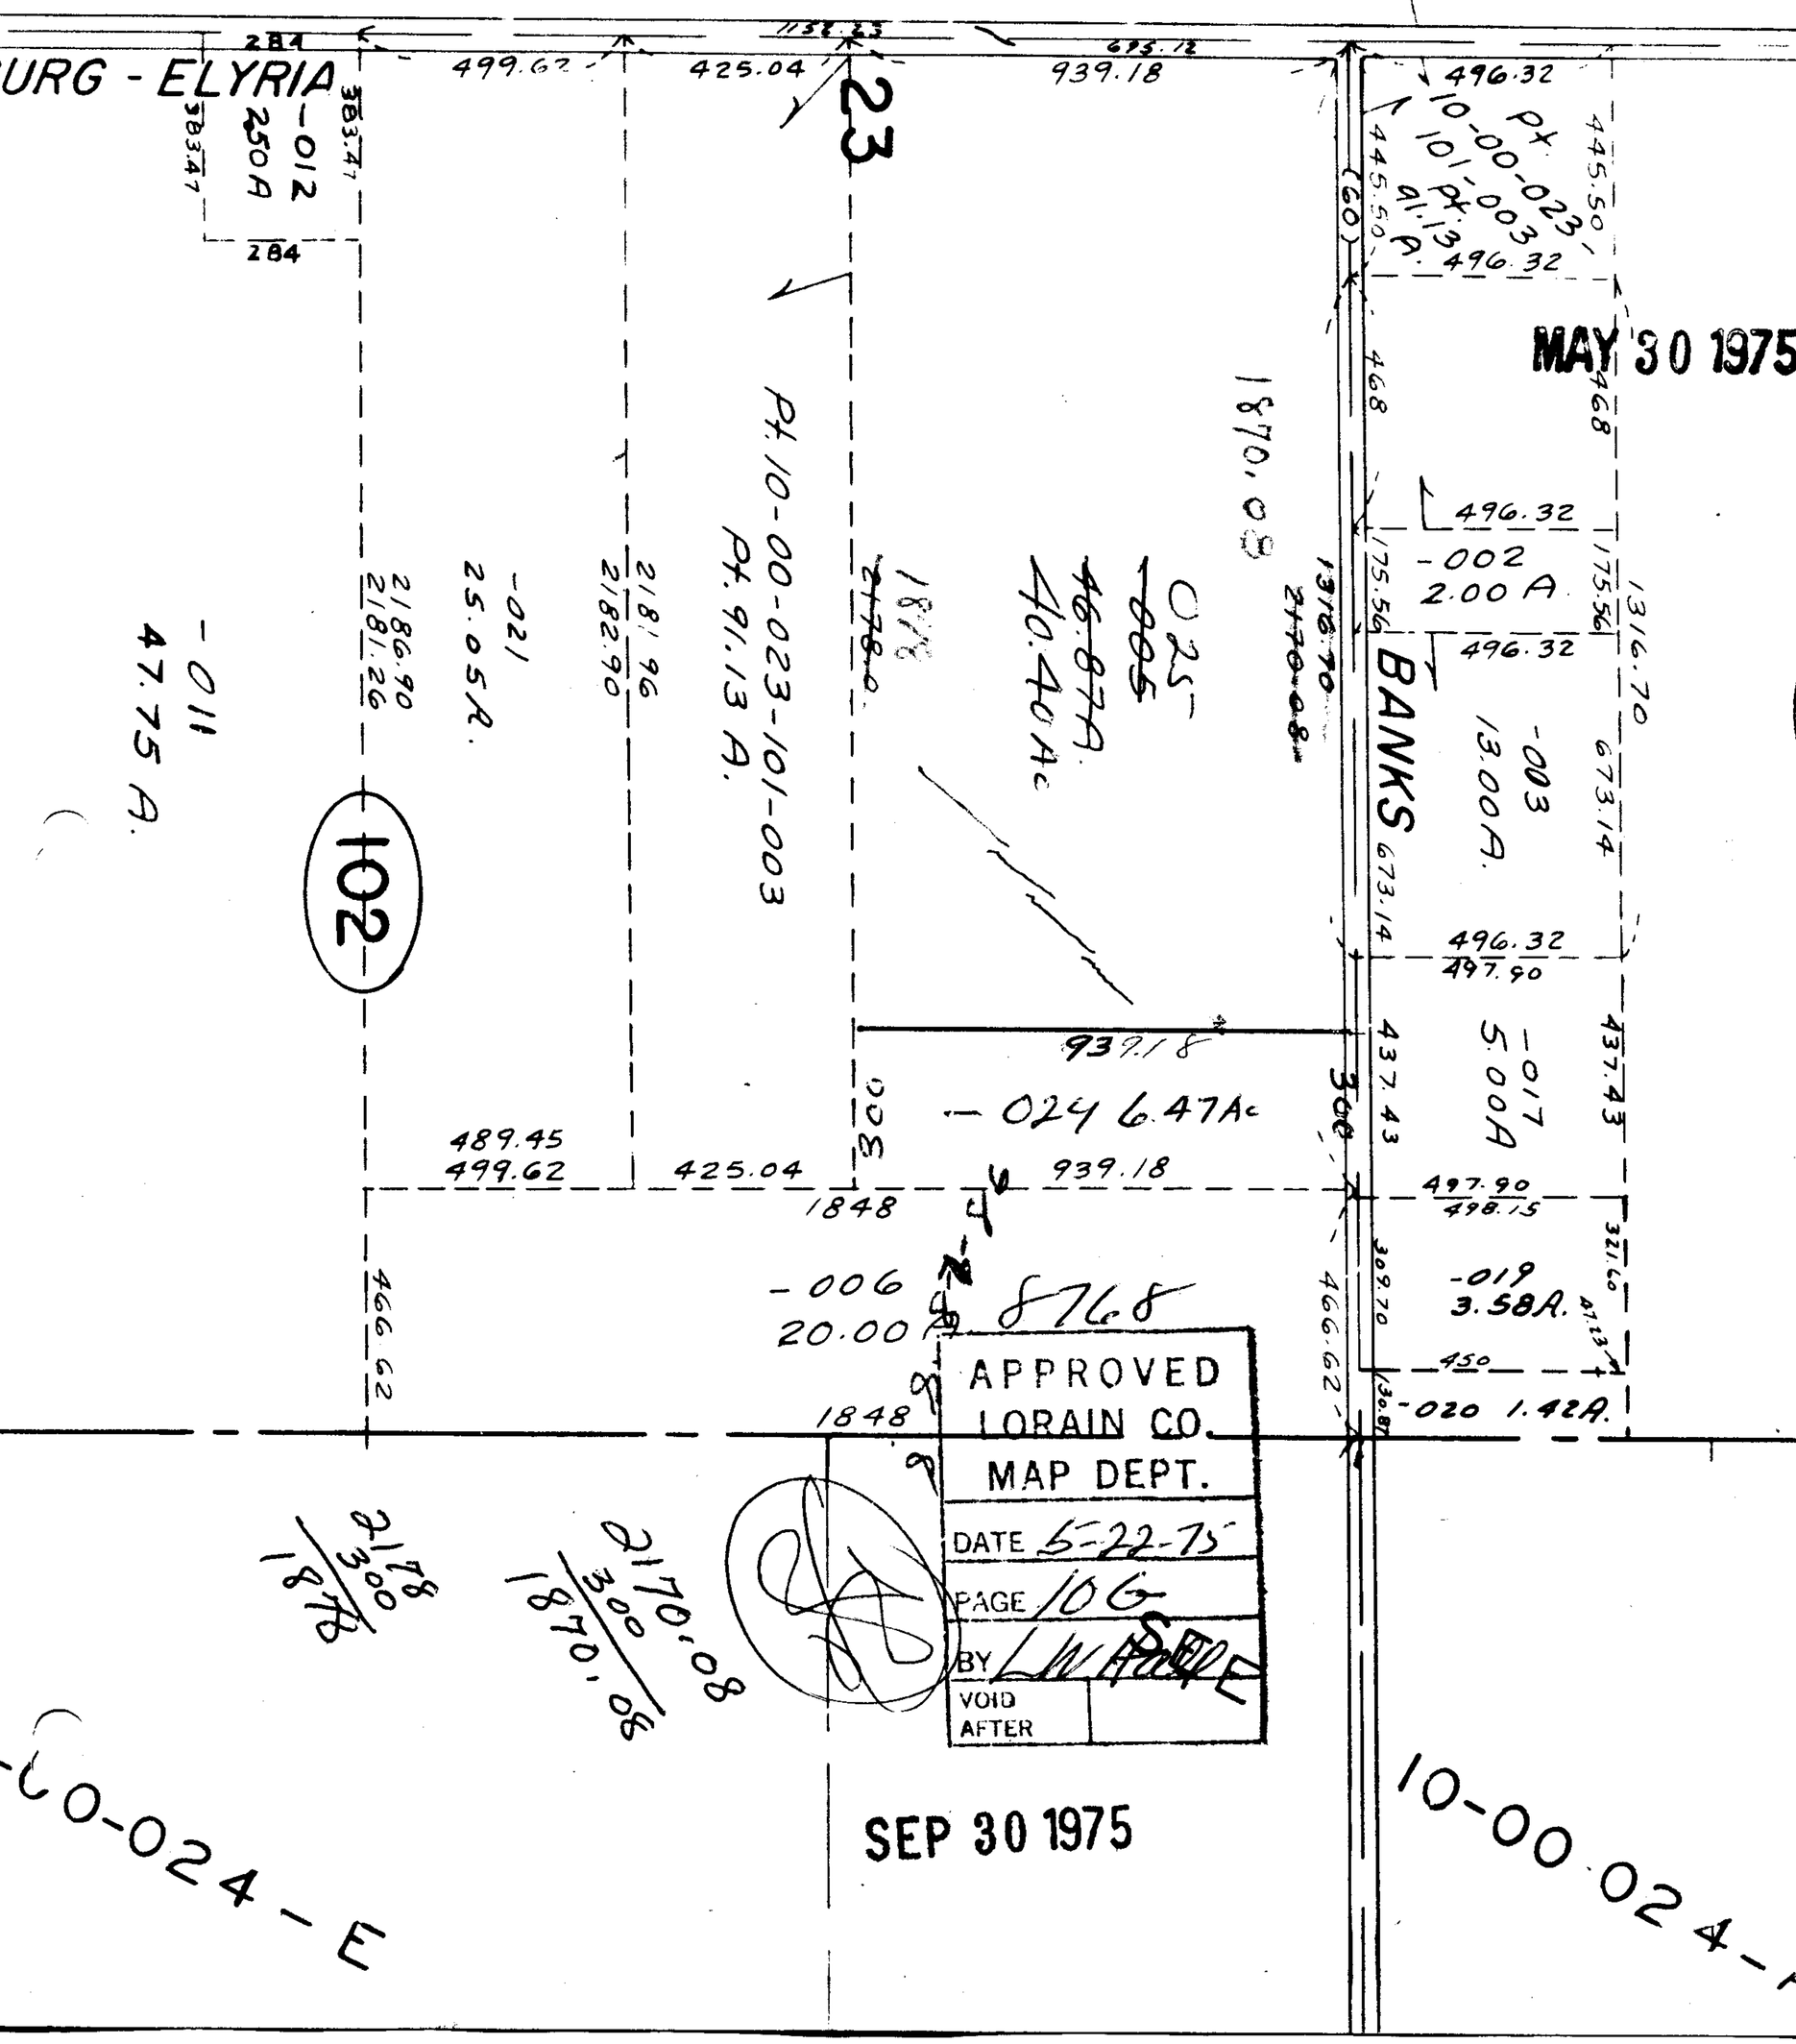


MAY 30 1975

APPROVED
LORAIN CO.
MAP DEPT.
DATE 5-22-75
PAGE 106
BY LW
VOID AFTER

SEP 30 1975