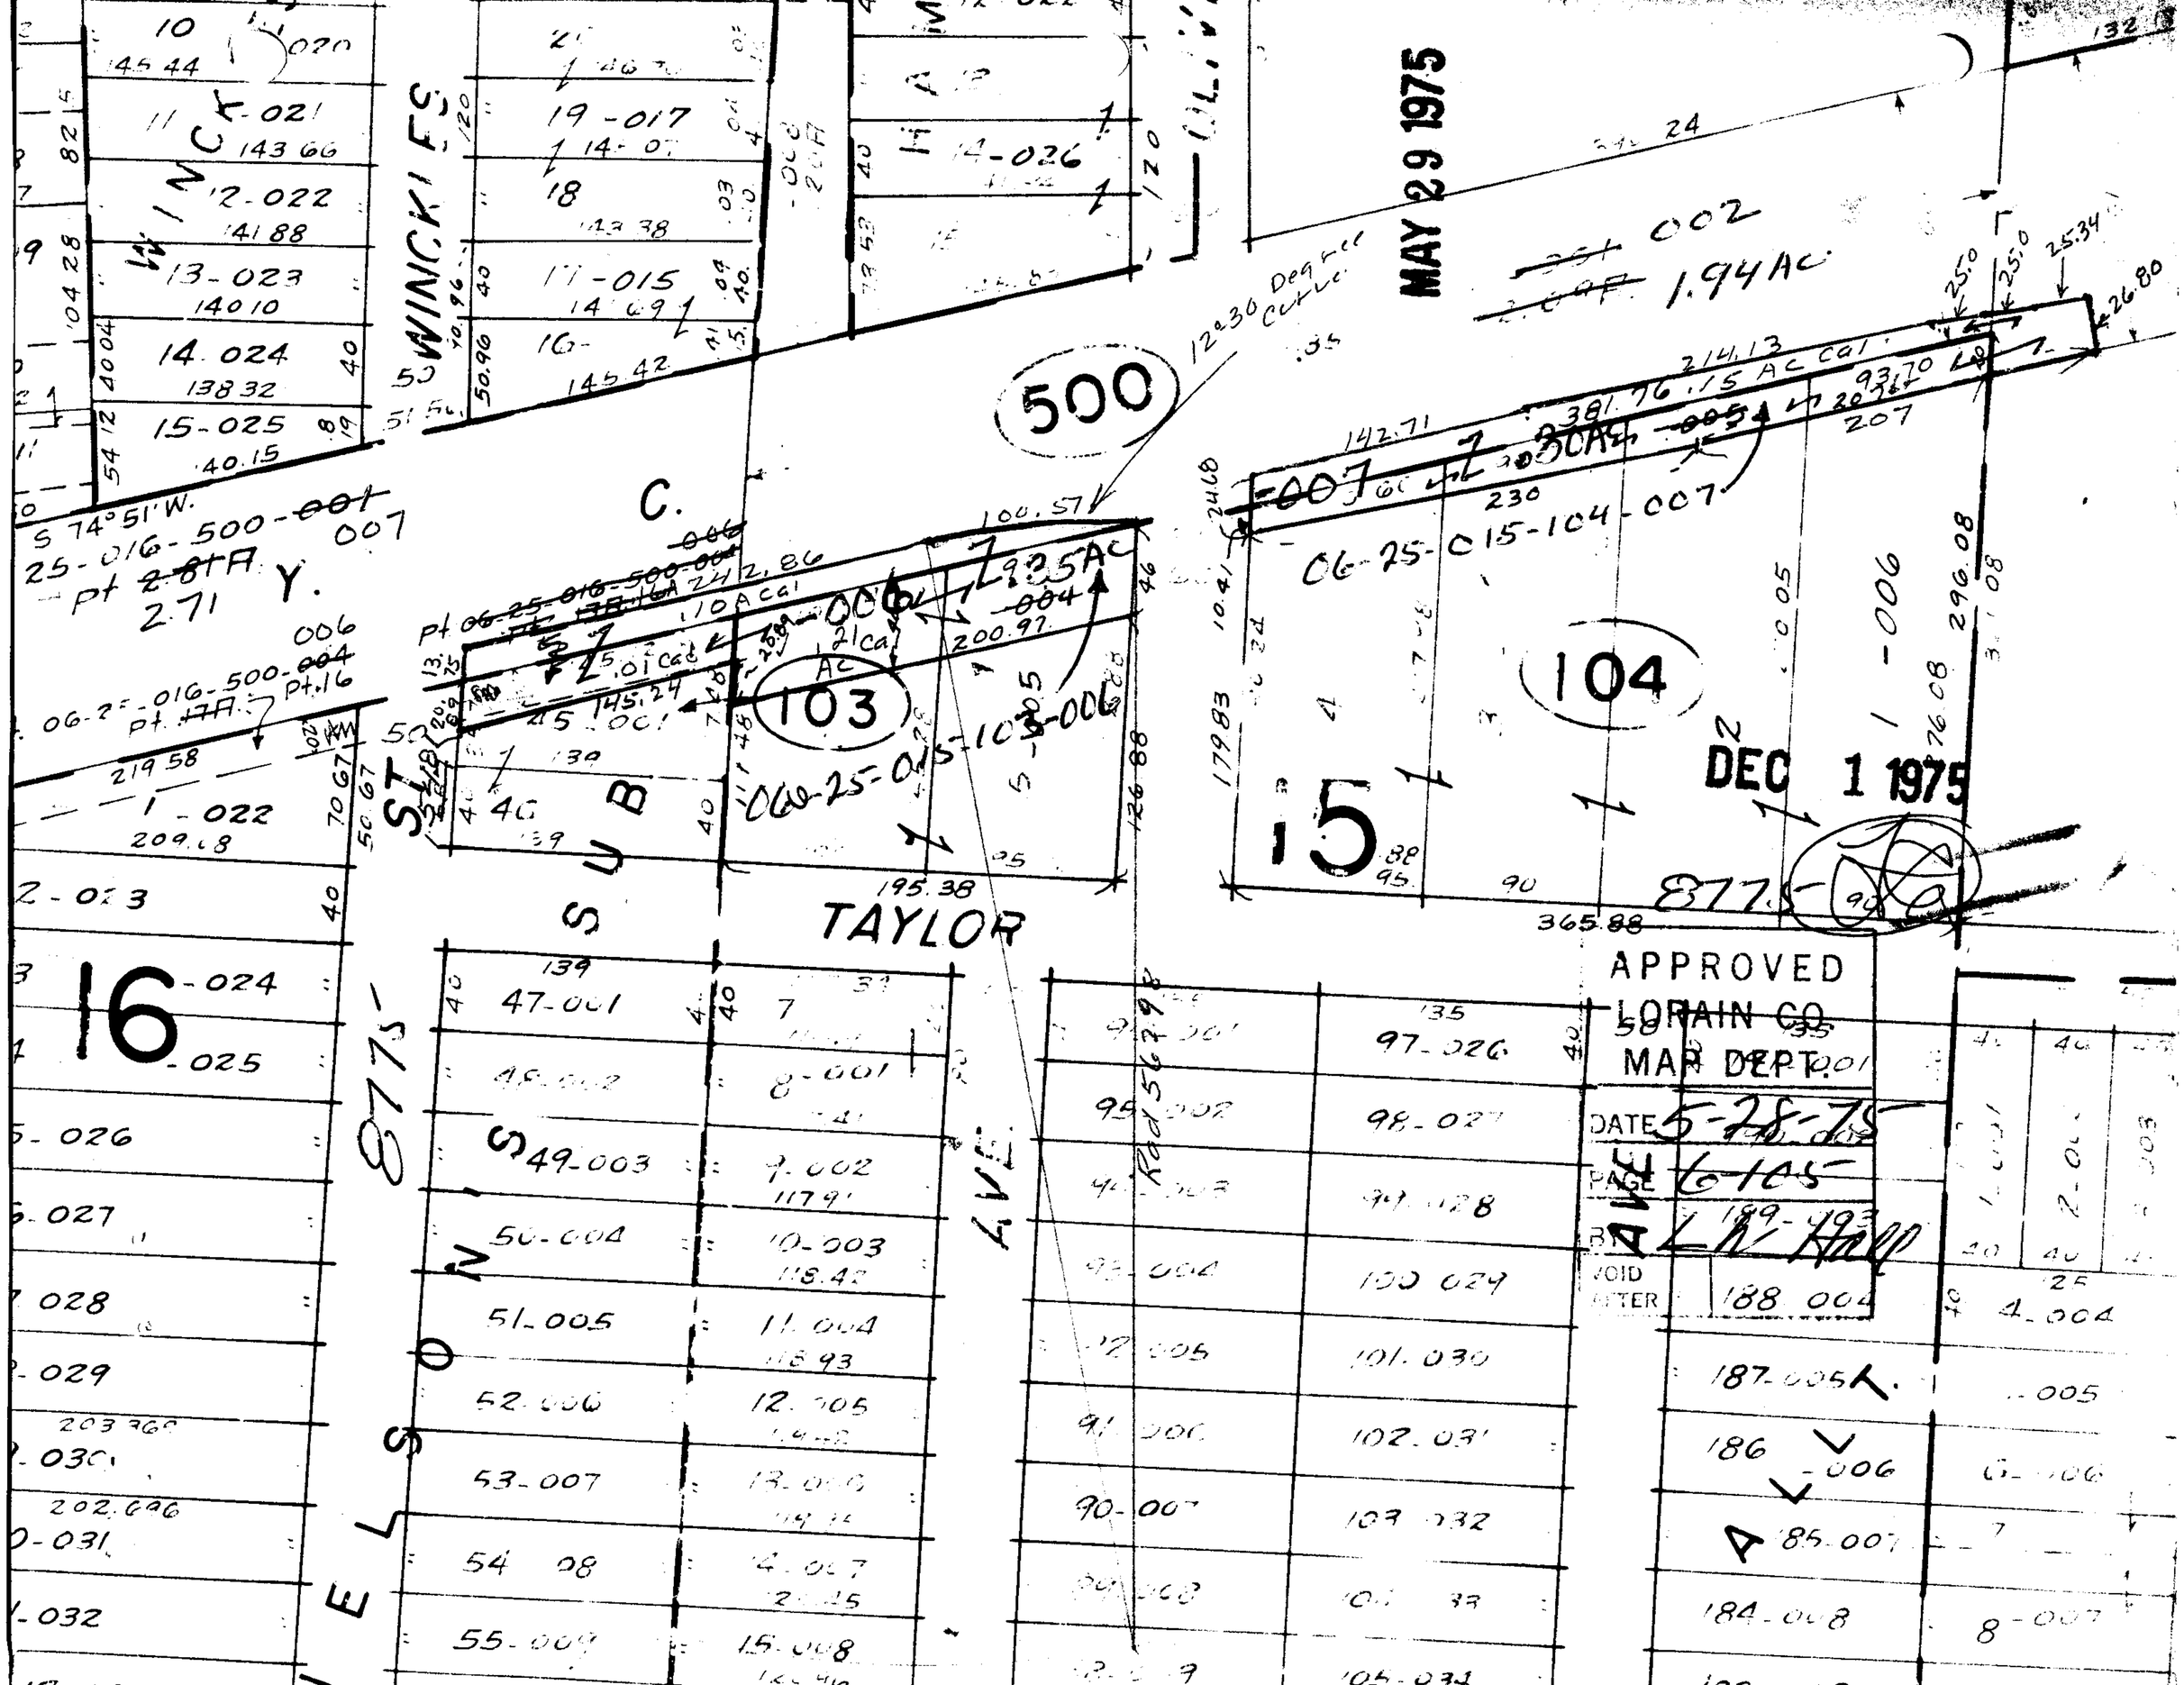

MAY 29 1975
DEC 1 1975
APPROVED
LORAIN CO.
MAP DEPT.
DATE 5-28-75
PAGE 6-105
BY L.W. Hall
VOID AFTER
WINCKLES
WINCKLES
TAYLOR
AVE
ALLT.
500
103
104
15
16
8775
12°30 Degree Curve
06-25-015-104-007
06-25-015-103-006
25-016-500-001
S 74°51'W.