

292.31  
- 002  
29A  
274  
**ELECTRIC**

252.93  
247.49

Pt. - 078  
Pt. 20.92 A.

**DEC 31 1975**

- 083  
7.25 A.

~~8793~~  
**8783**

**JUL 8 1975**

**135**


~~8793~~



63-75  
4-00-006D  
LW Hall

- 081  
7.11 A.

DV 793 - Py 291  
793 - 689

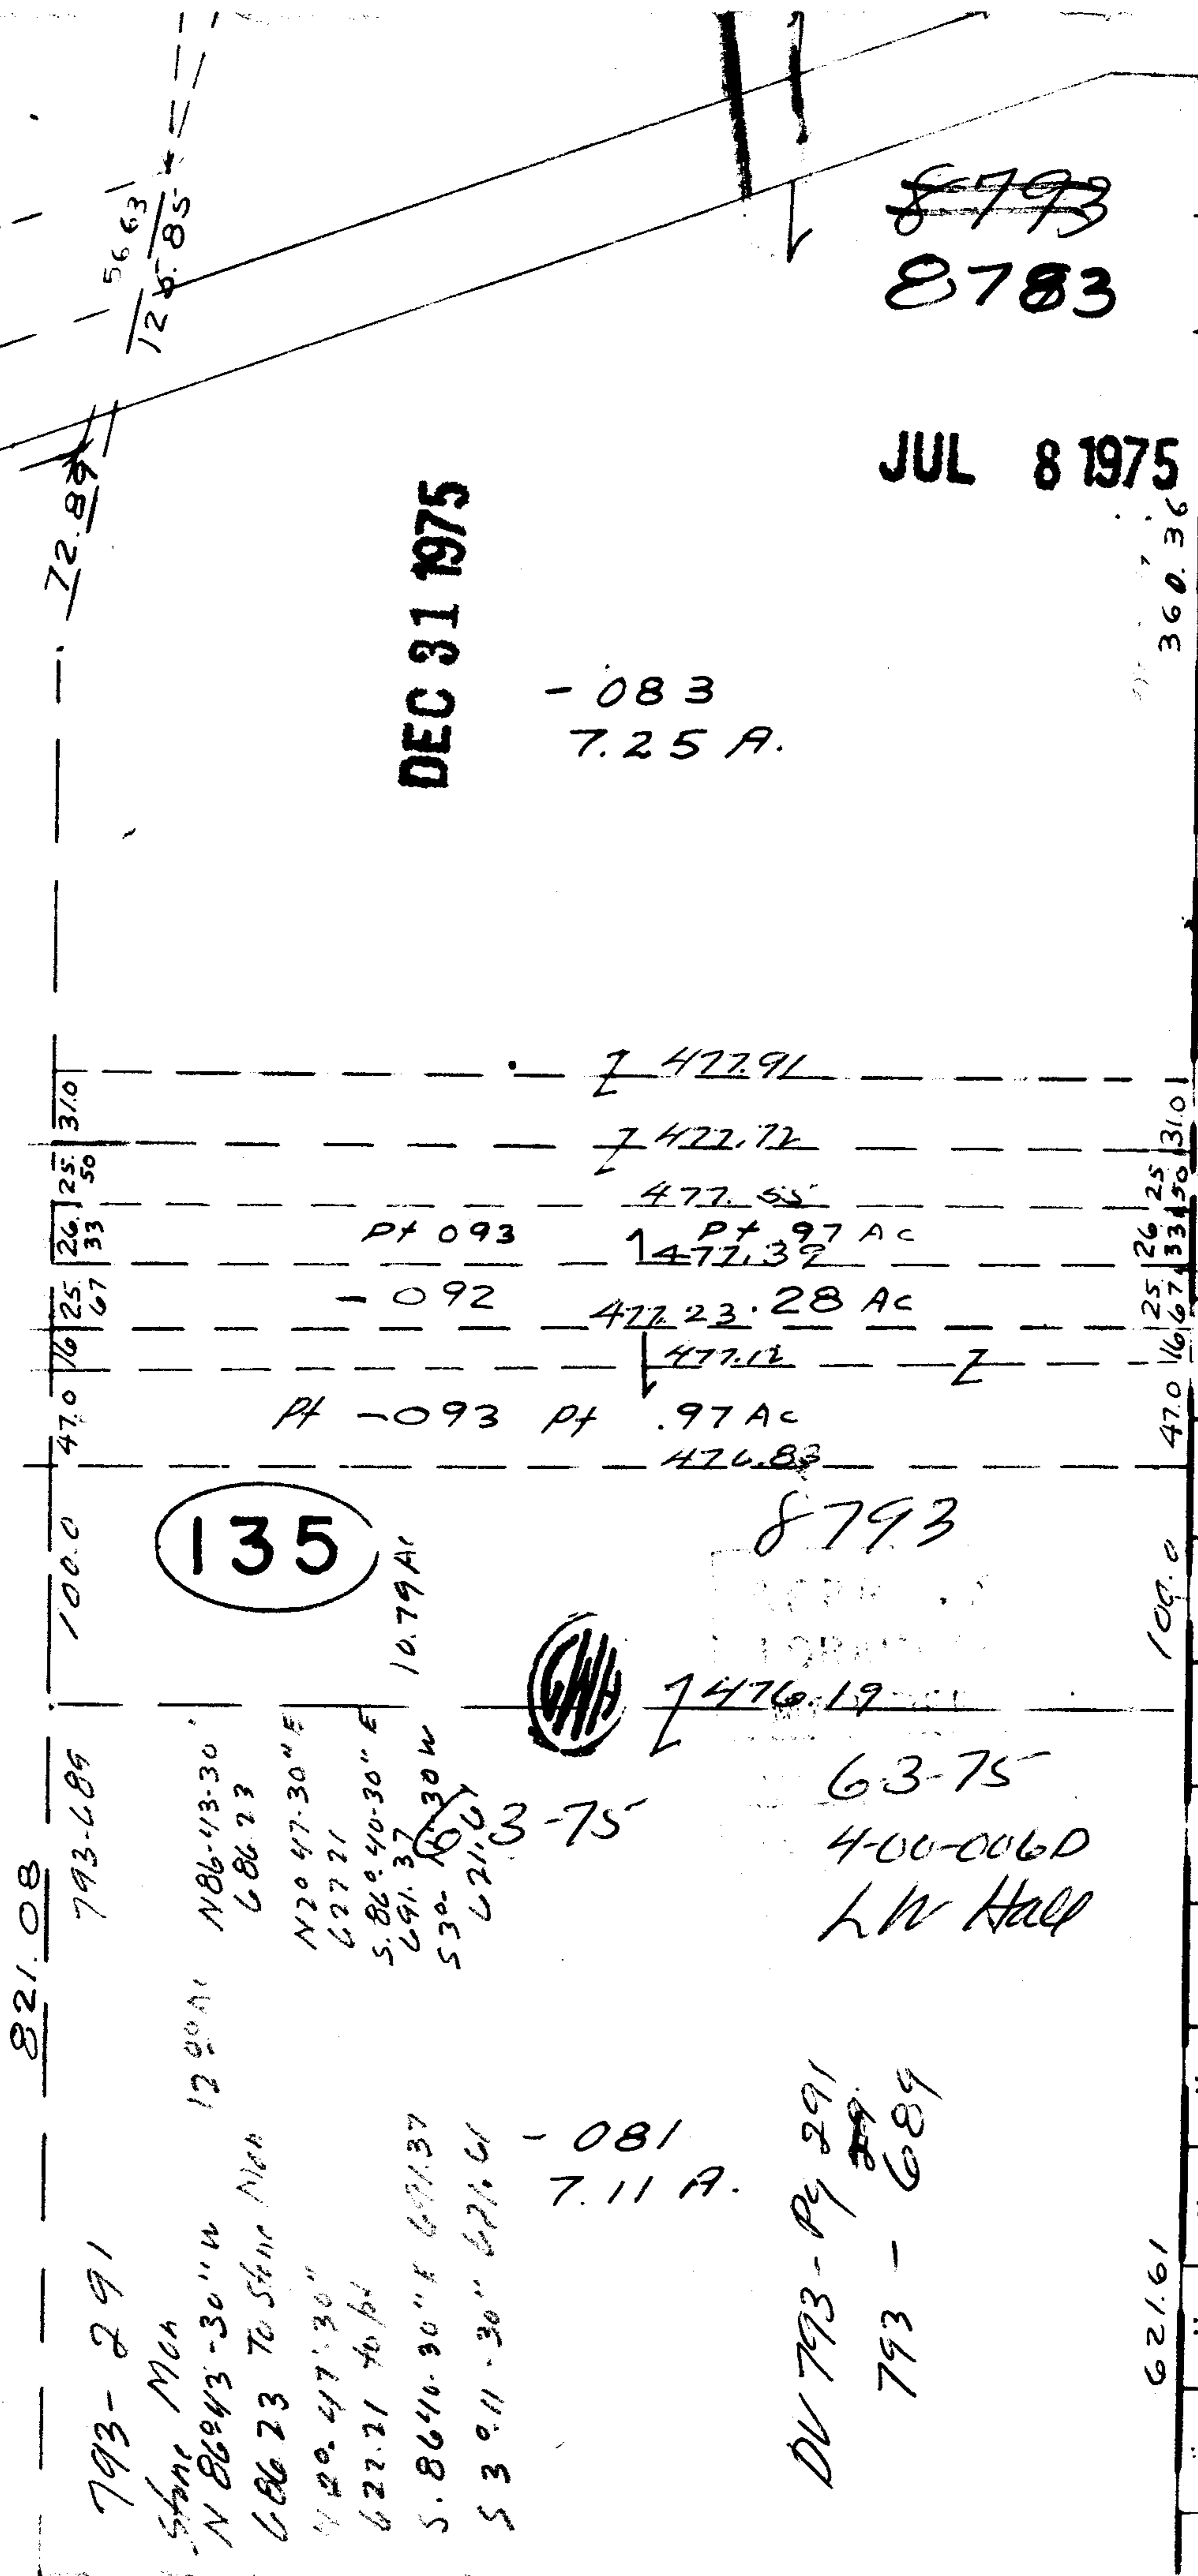

40	40	151.29
50	57.50	151.18
47	151.07	140
49-0	150.9	
50	150.8	
51-0	150.70	
52-0	150.60	
-0	150.55	
-0	150.49	
55-0	150.34	
-0	150.20	
59-03	149.93	
-03	149.82	
-03	149.70	
-03	149.61	
63-038	149.51	
-039	149.40	
-040	149.30	
E-0	149.20	