MAY 30 1975

8784

DEC 31 1975

8784

APPROVED
TITLE INSURANCE CO.
MAP DEPT.
DATE 5-29-75
PAGE 5-00-042B
BY LH-HRB
VOID AFTER

8-5-86 L.L.

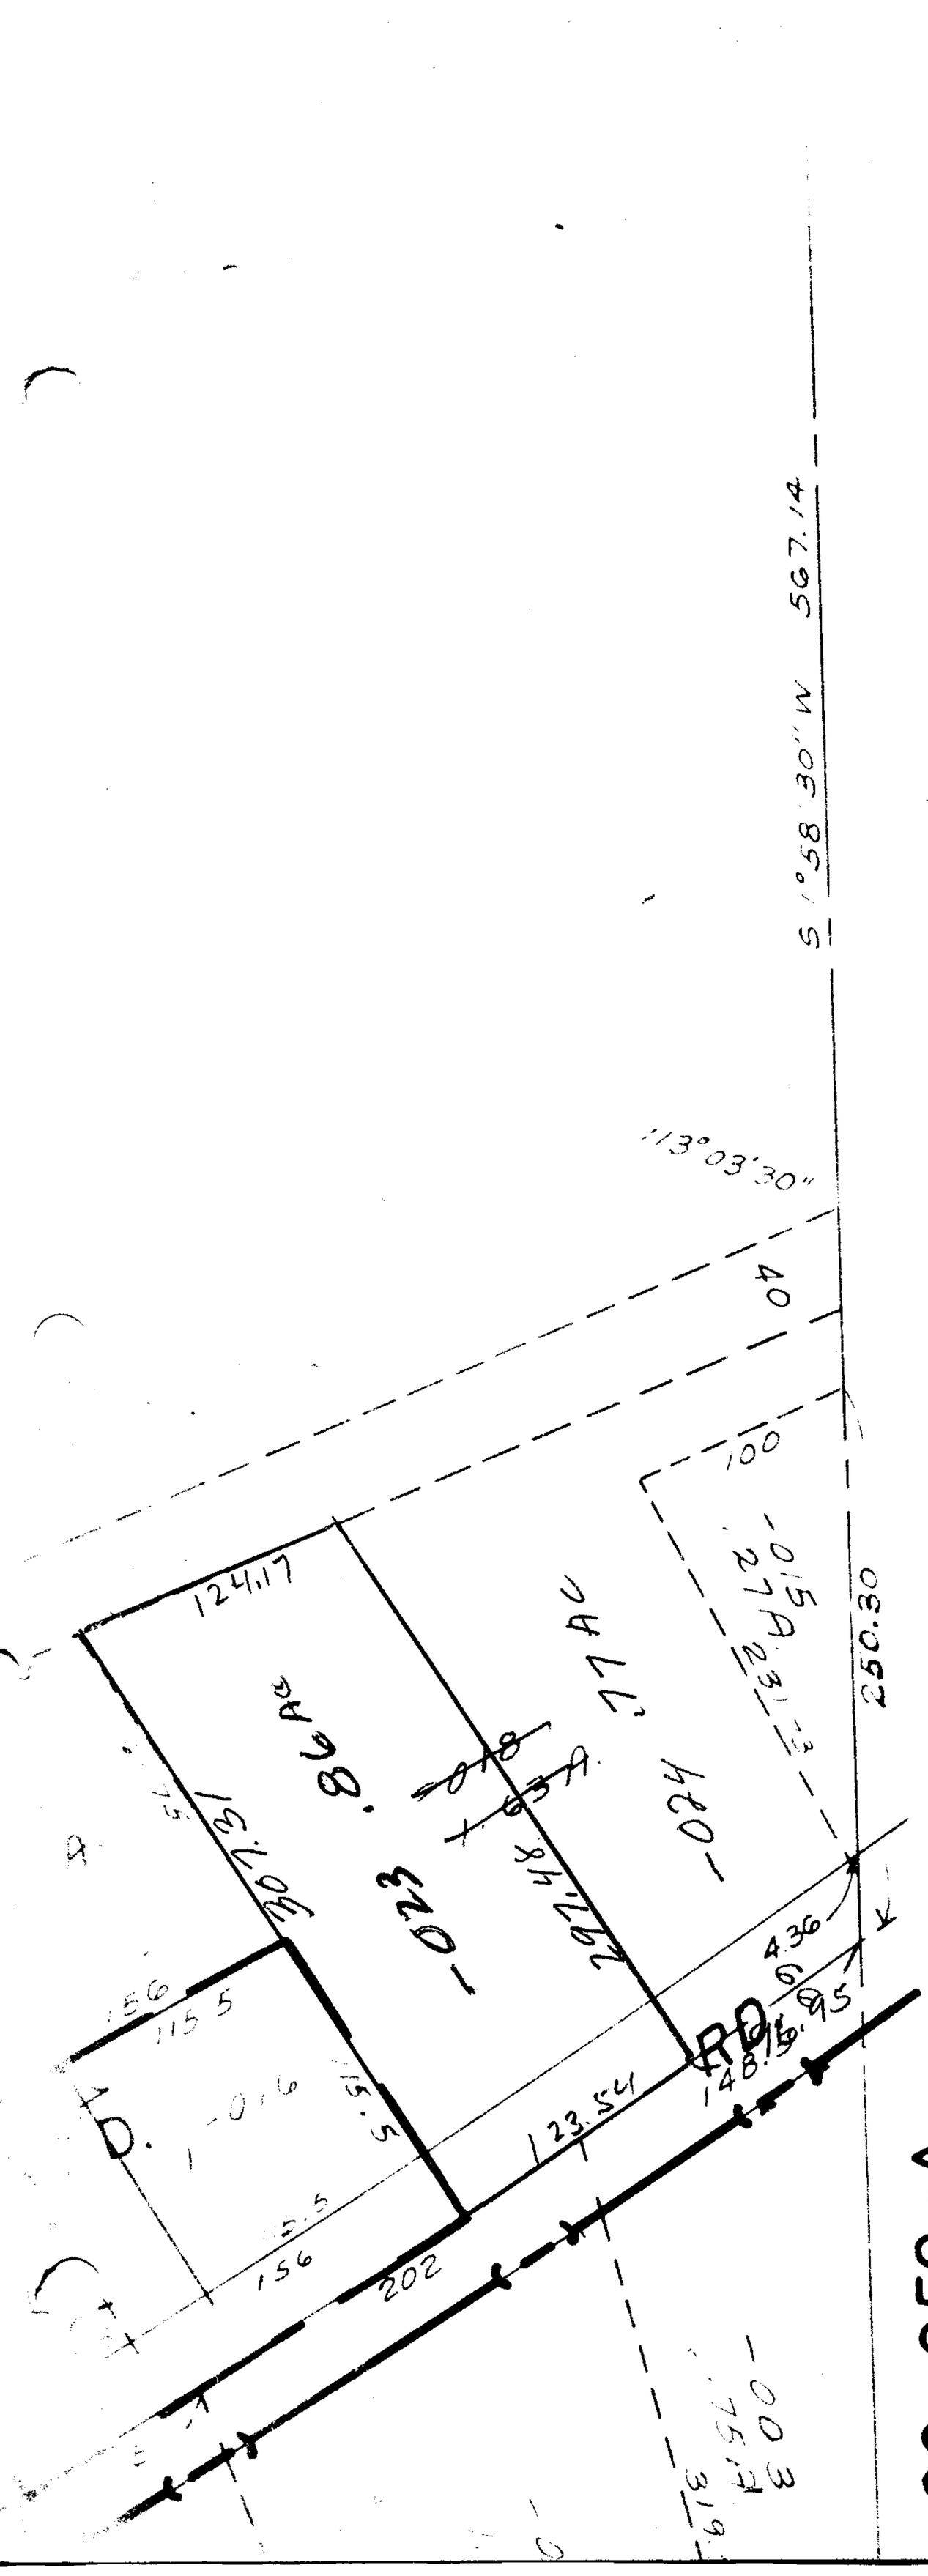

ANNEXATION DATA

COMM. RES. 65-776

CITY ORD. 66-6