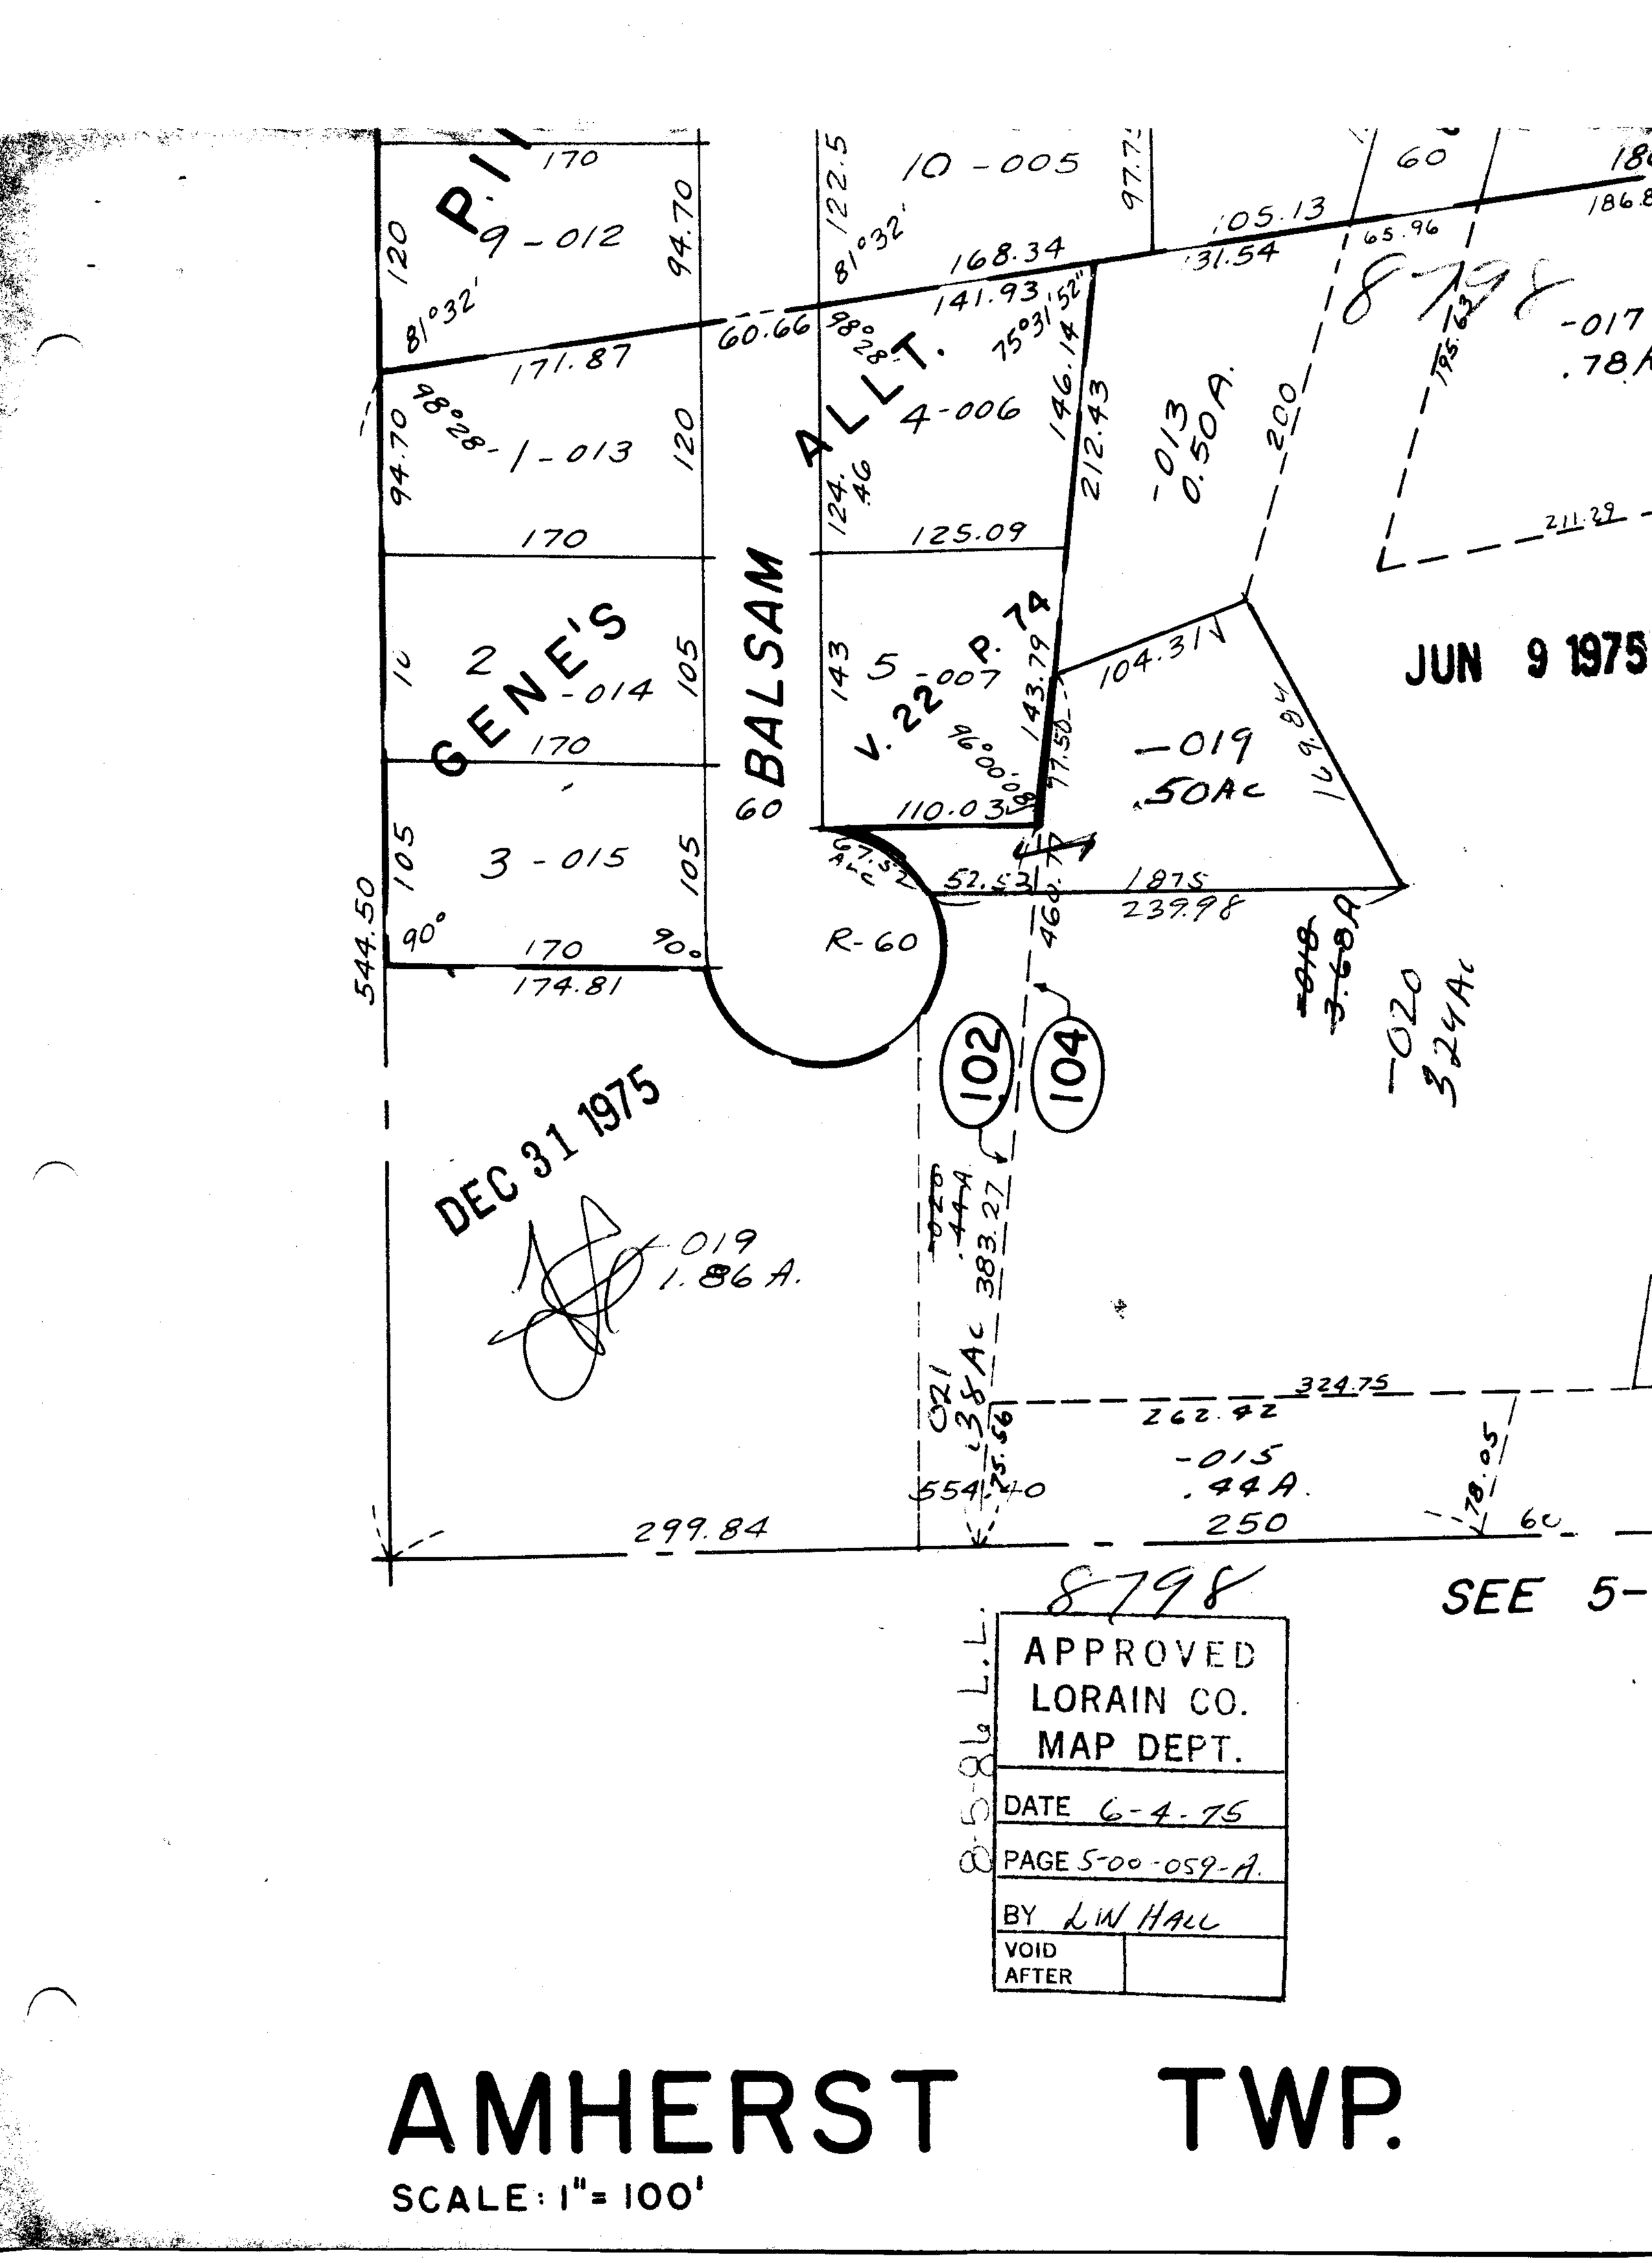

8798

APPROVED
LORAIN CO.
MAP DEPT.
DATE 6-4-75
PAGE 5-00-059-A.
BY L.W. HALL
VOID AFTER

AMHERST TWP.

SCALE: 1" = 100'