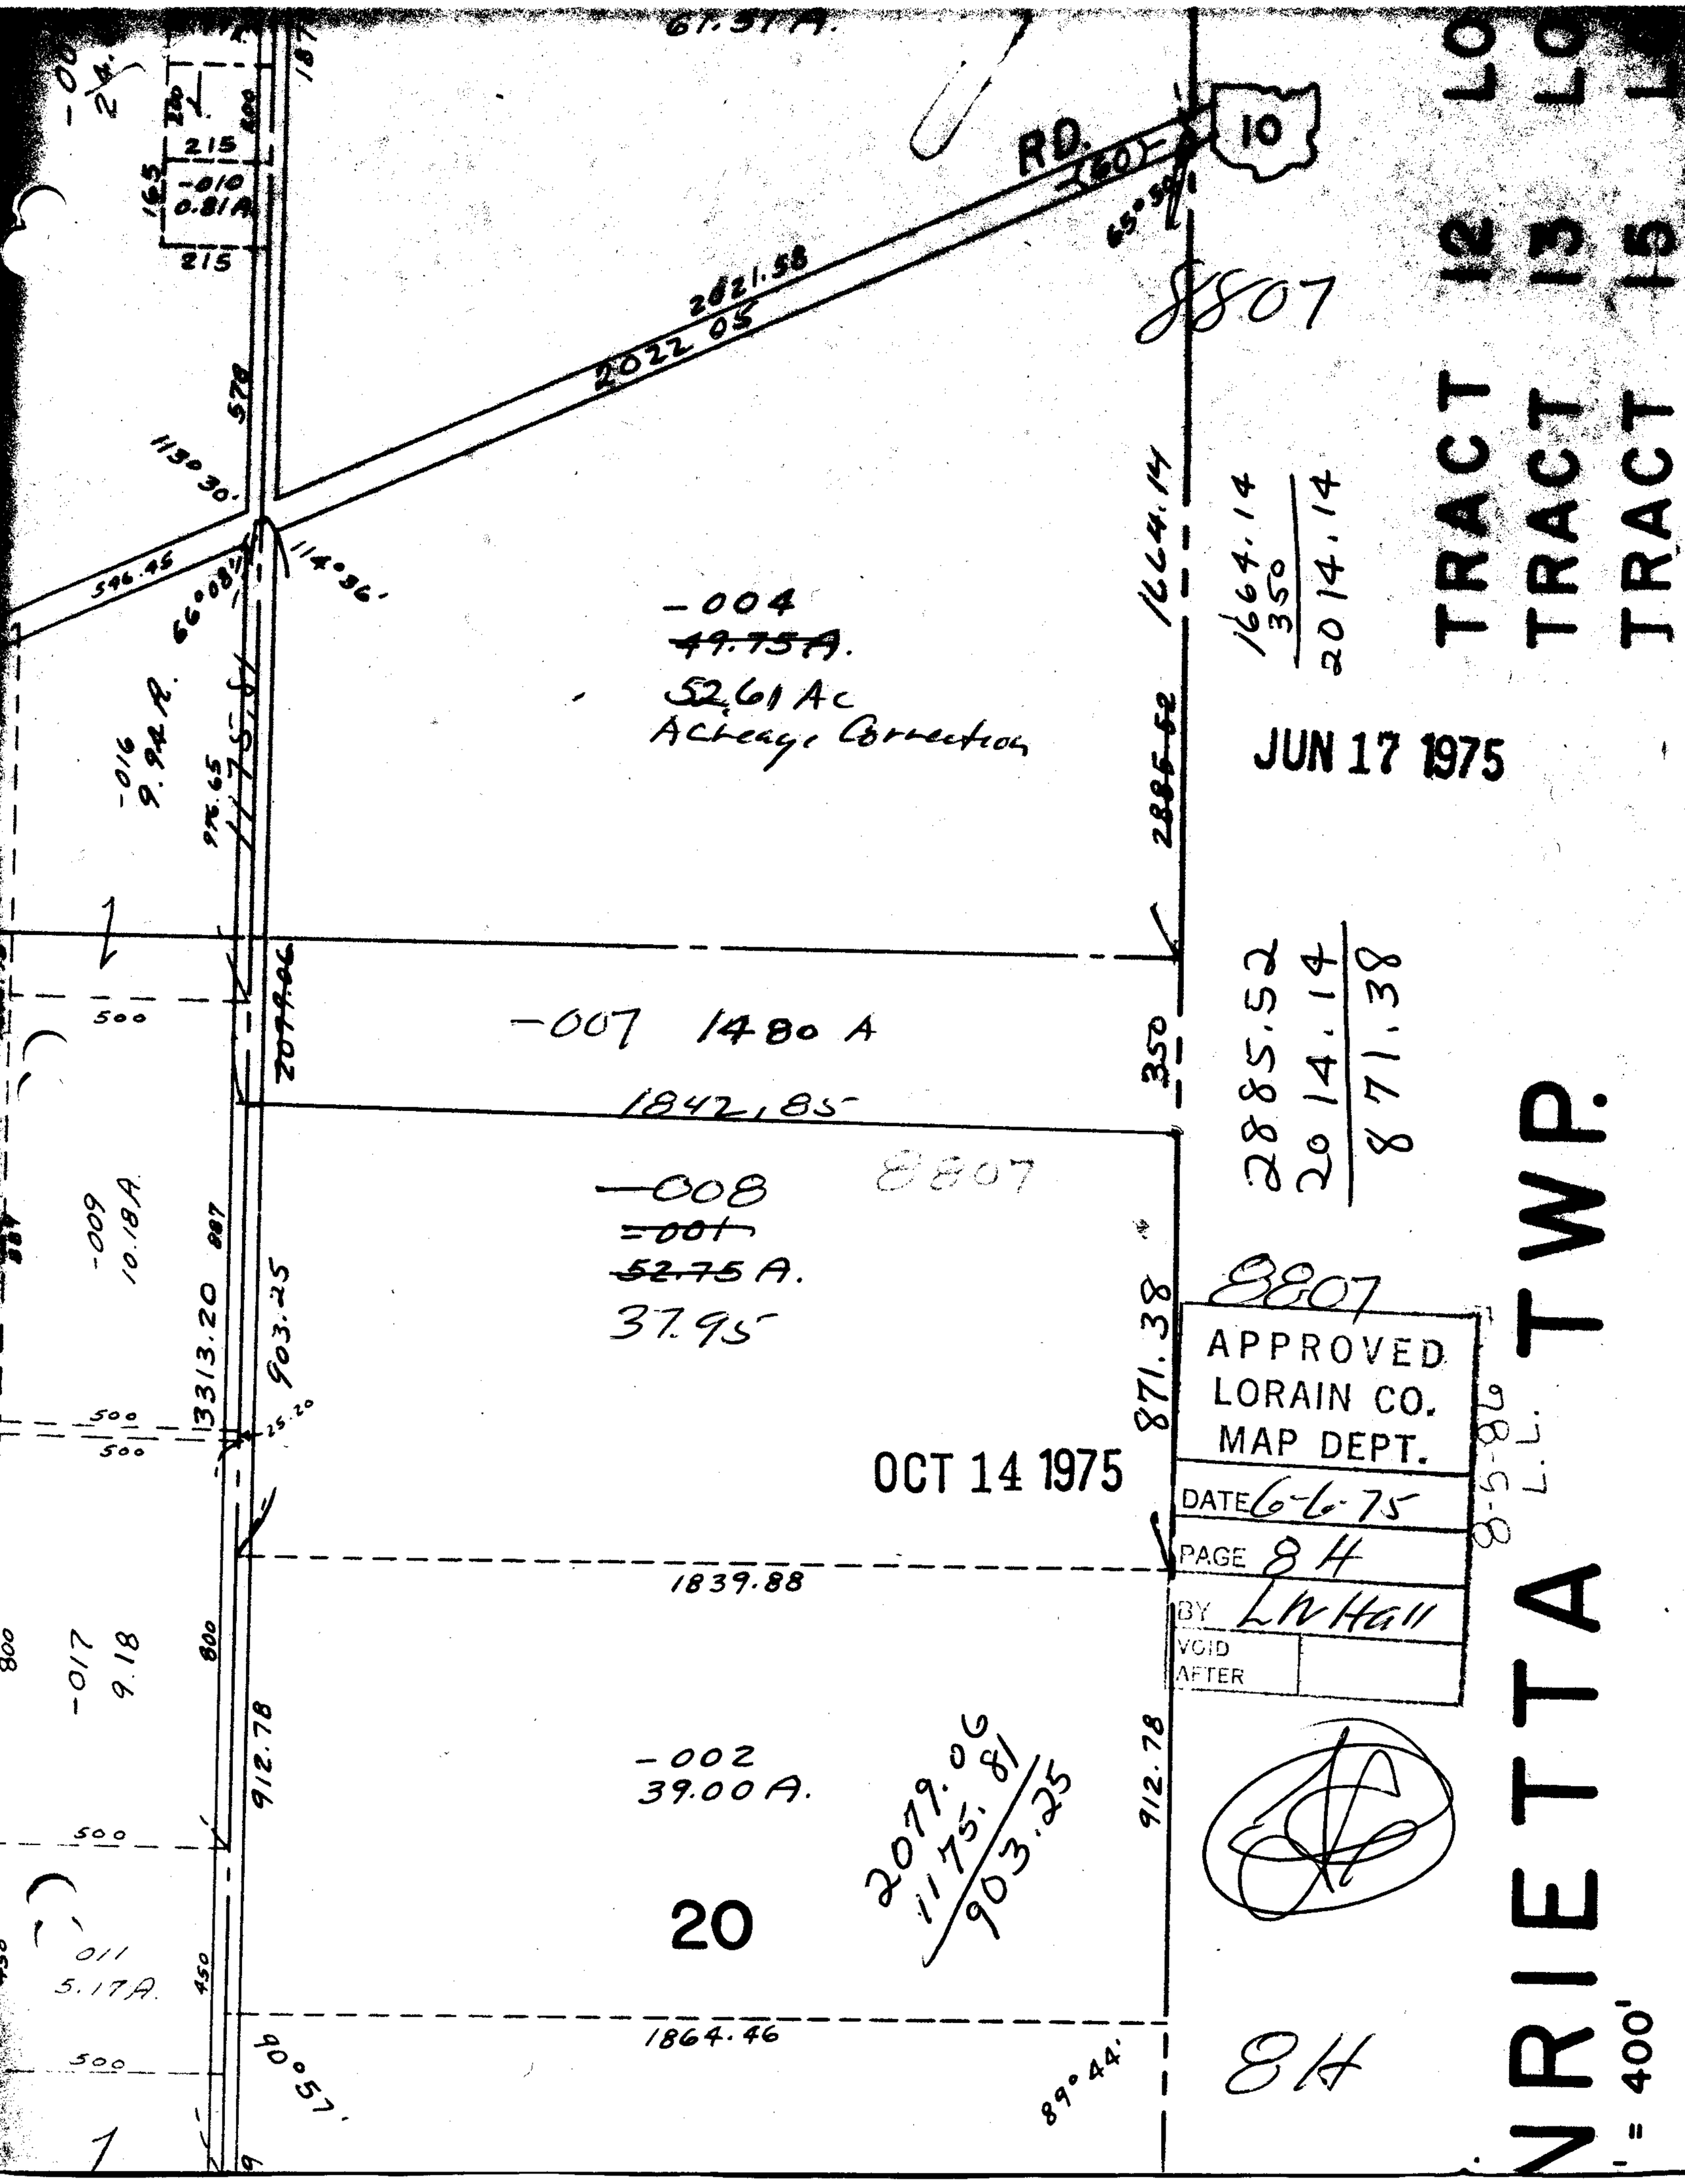

61.31 A.
RD.
10
2021.58
2022.05
8807
-004
~~49.75 A.~~
52.61 Ac
Acreage Correction
1664.14
350
2014.14
JUN 17 1975
-007 1480 A
1842.85
2885.52
2014.14
871.38
8807
-008
~~-001~~
~~52.75~~ A.
37.95
871.38
8807
APPROVED
LORAIN CO.
MAP DEPT.
DATE 6-6-75
PAGE 8H
BY LW Hall
VOID AFTER
OCT 14 1975
1839.88
-002
39.00 A.
2079.06
1175.81
903.25
912.78
20
1864.46
89°44'
90°57'
8H
TRACT 12
TRACT 13
TRACT 15
NRIETTA TWP.
= 400'