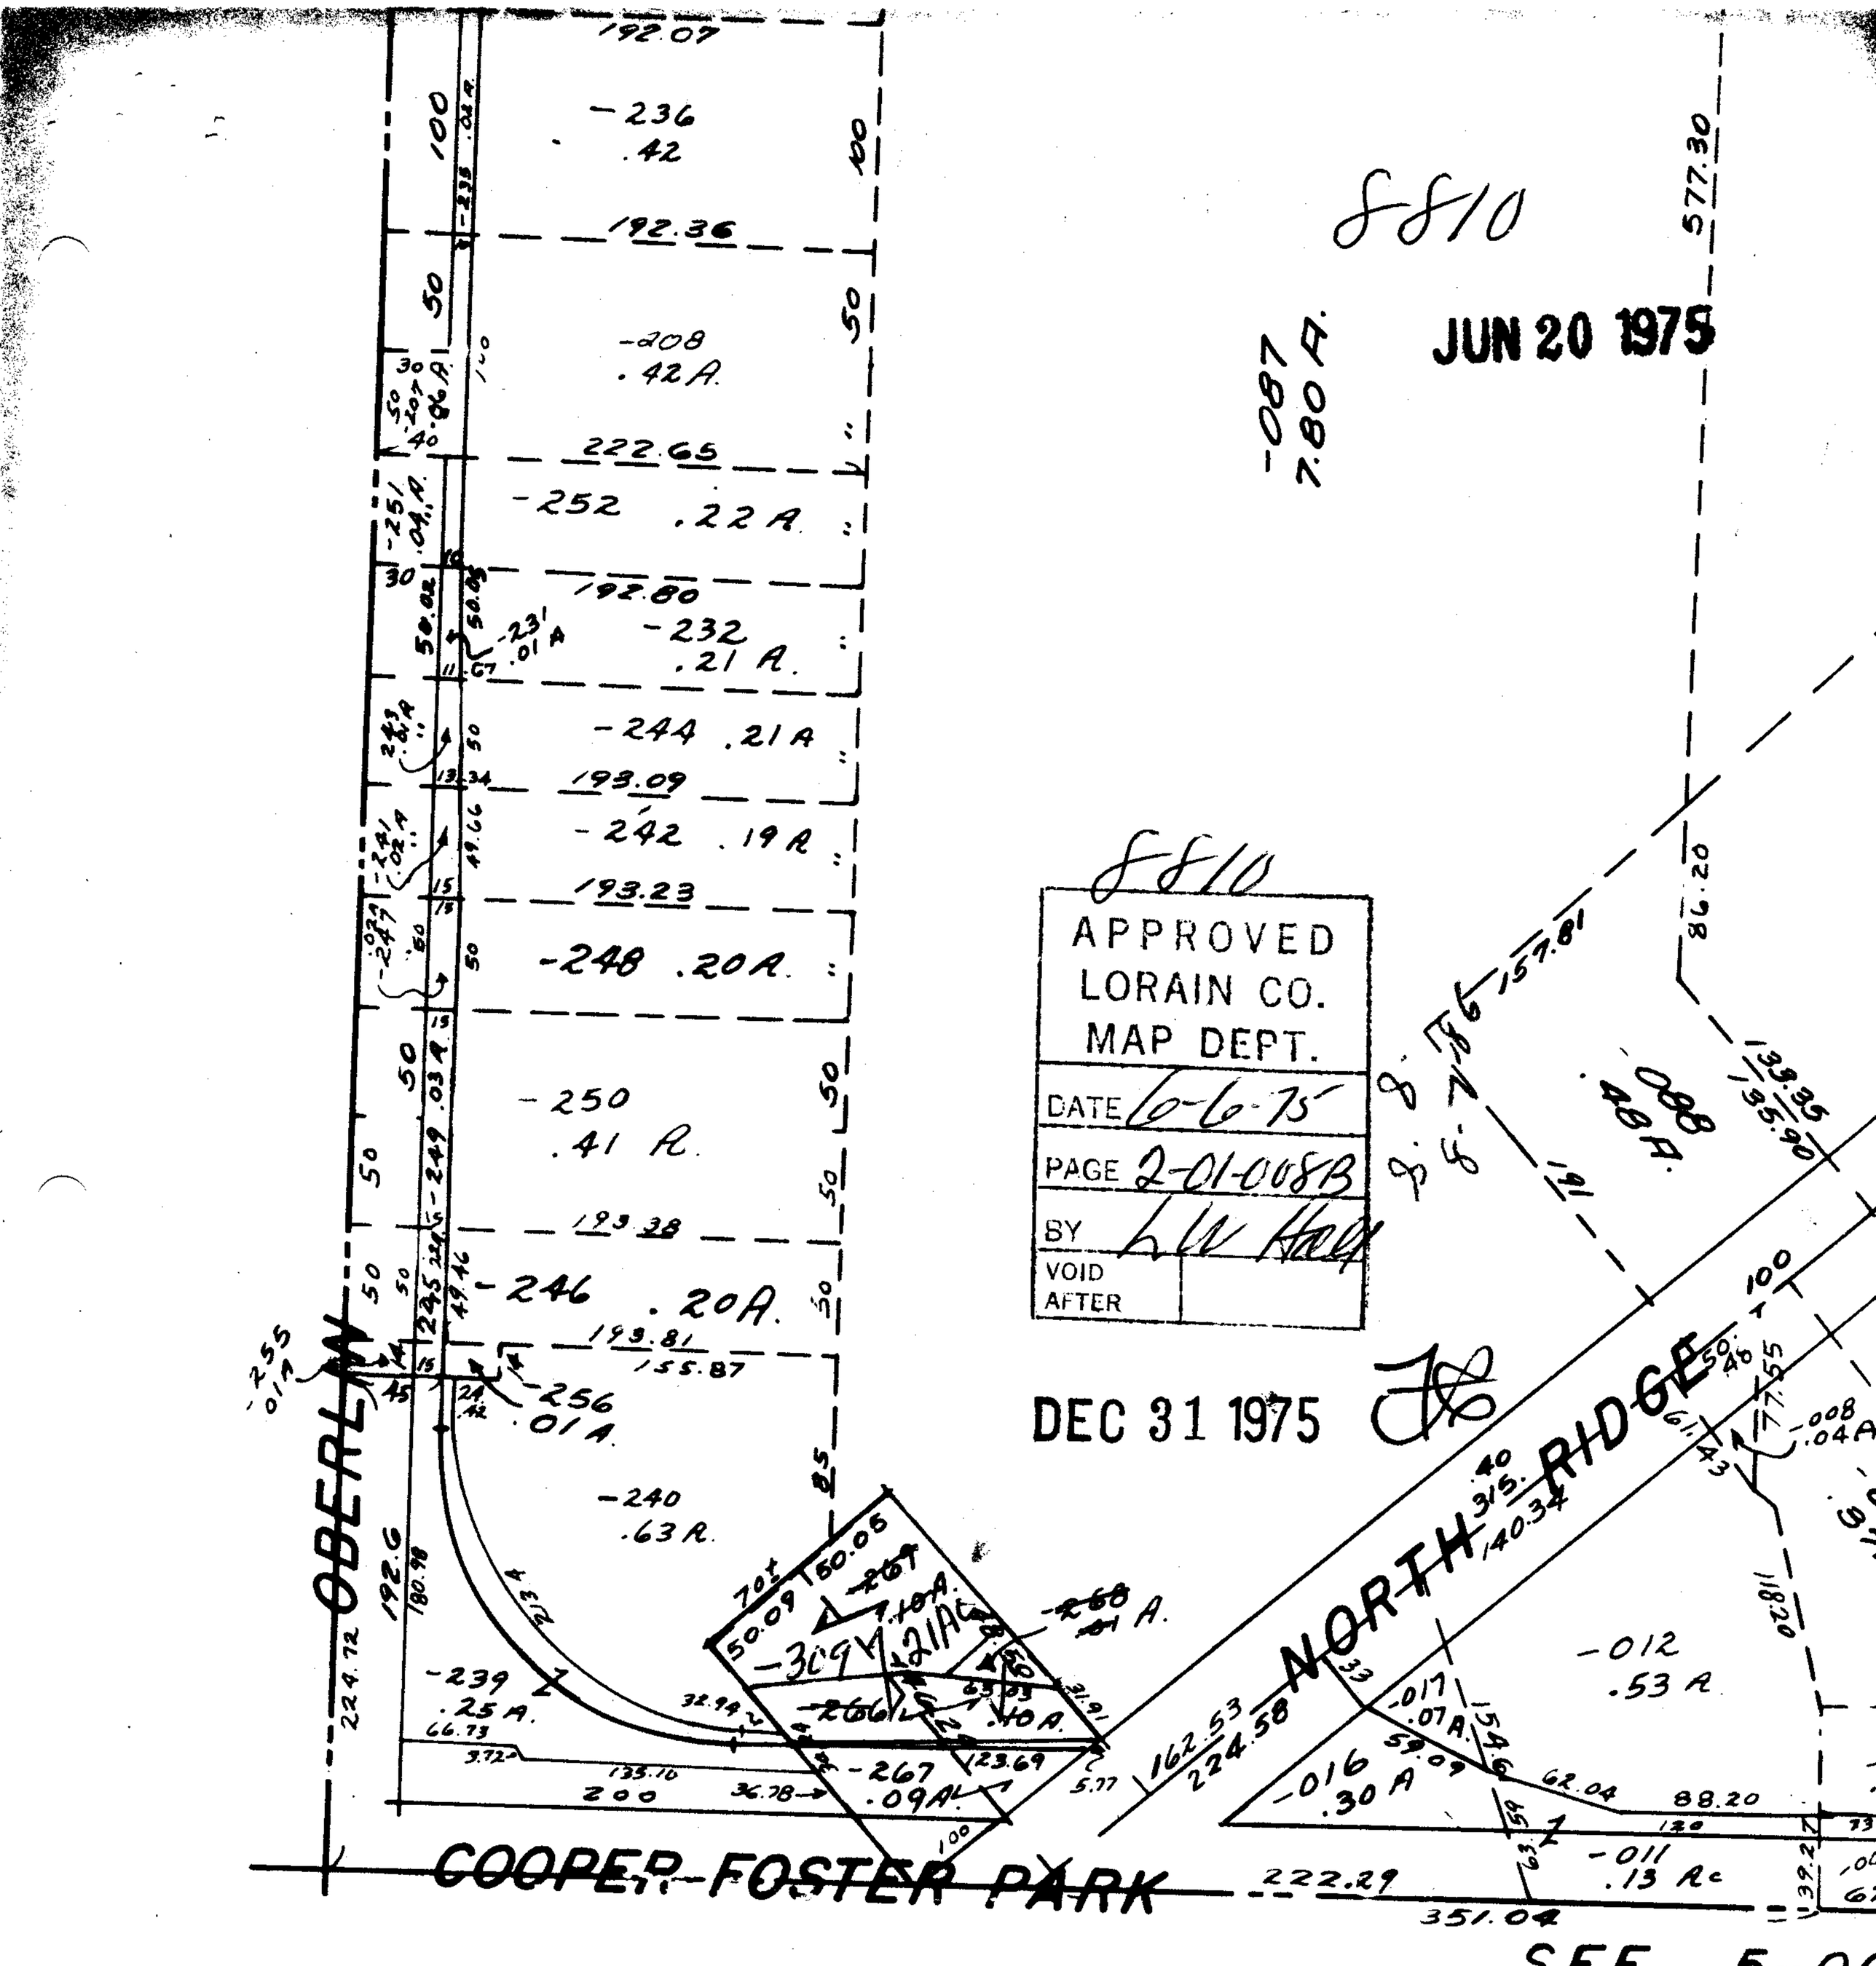

SEE 5-00

BLACK RIVER TWP.

SCALE: 1" = 100'