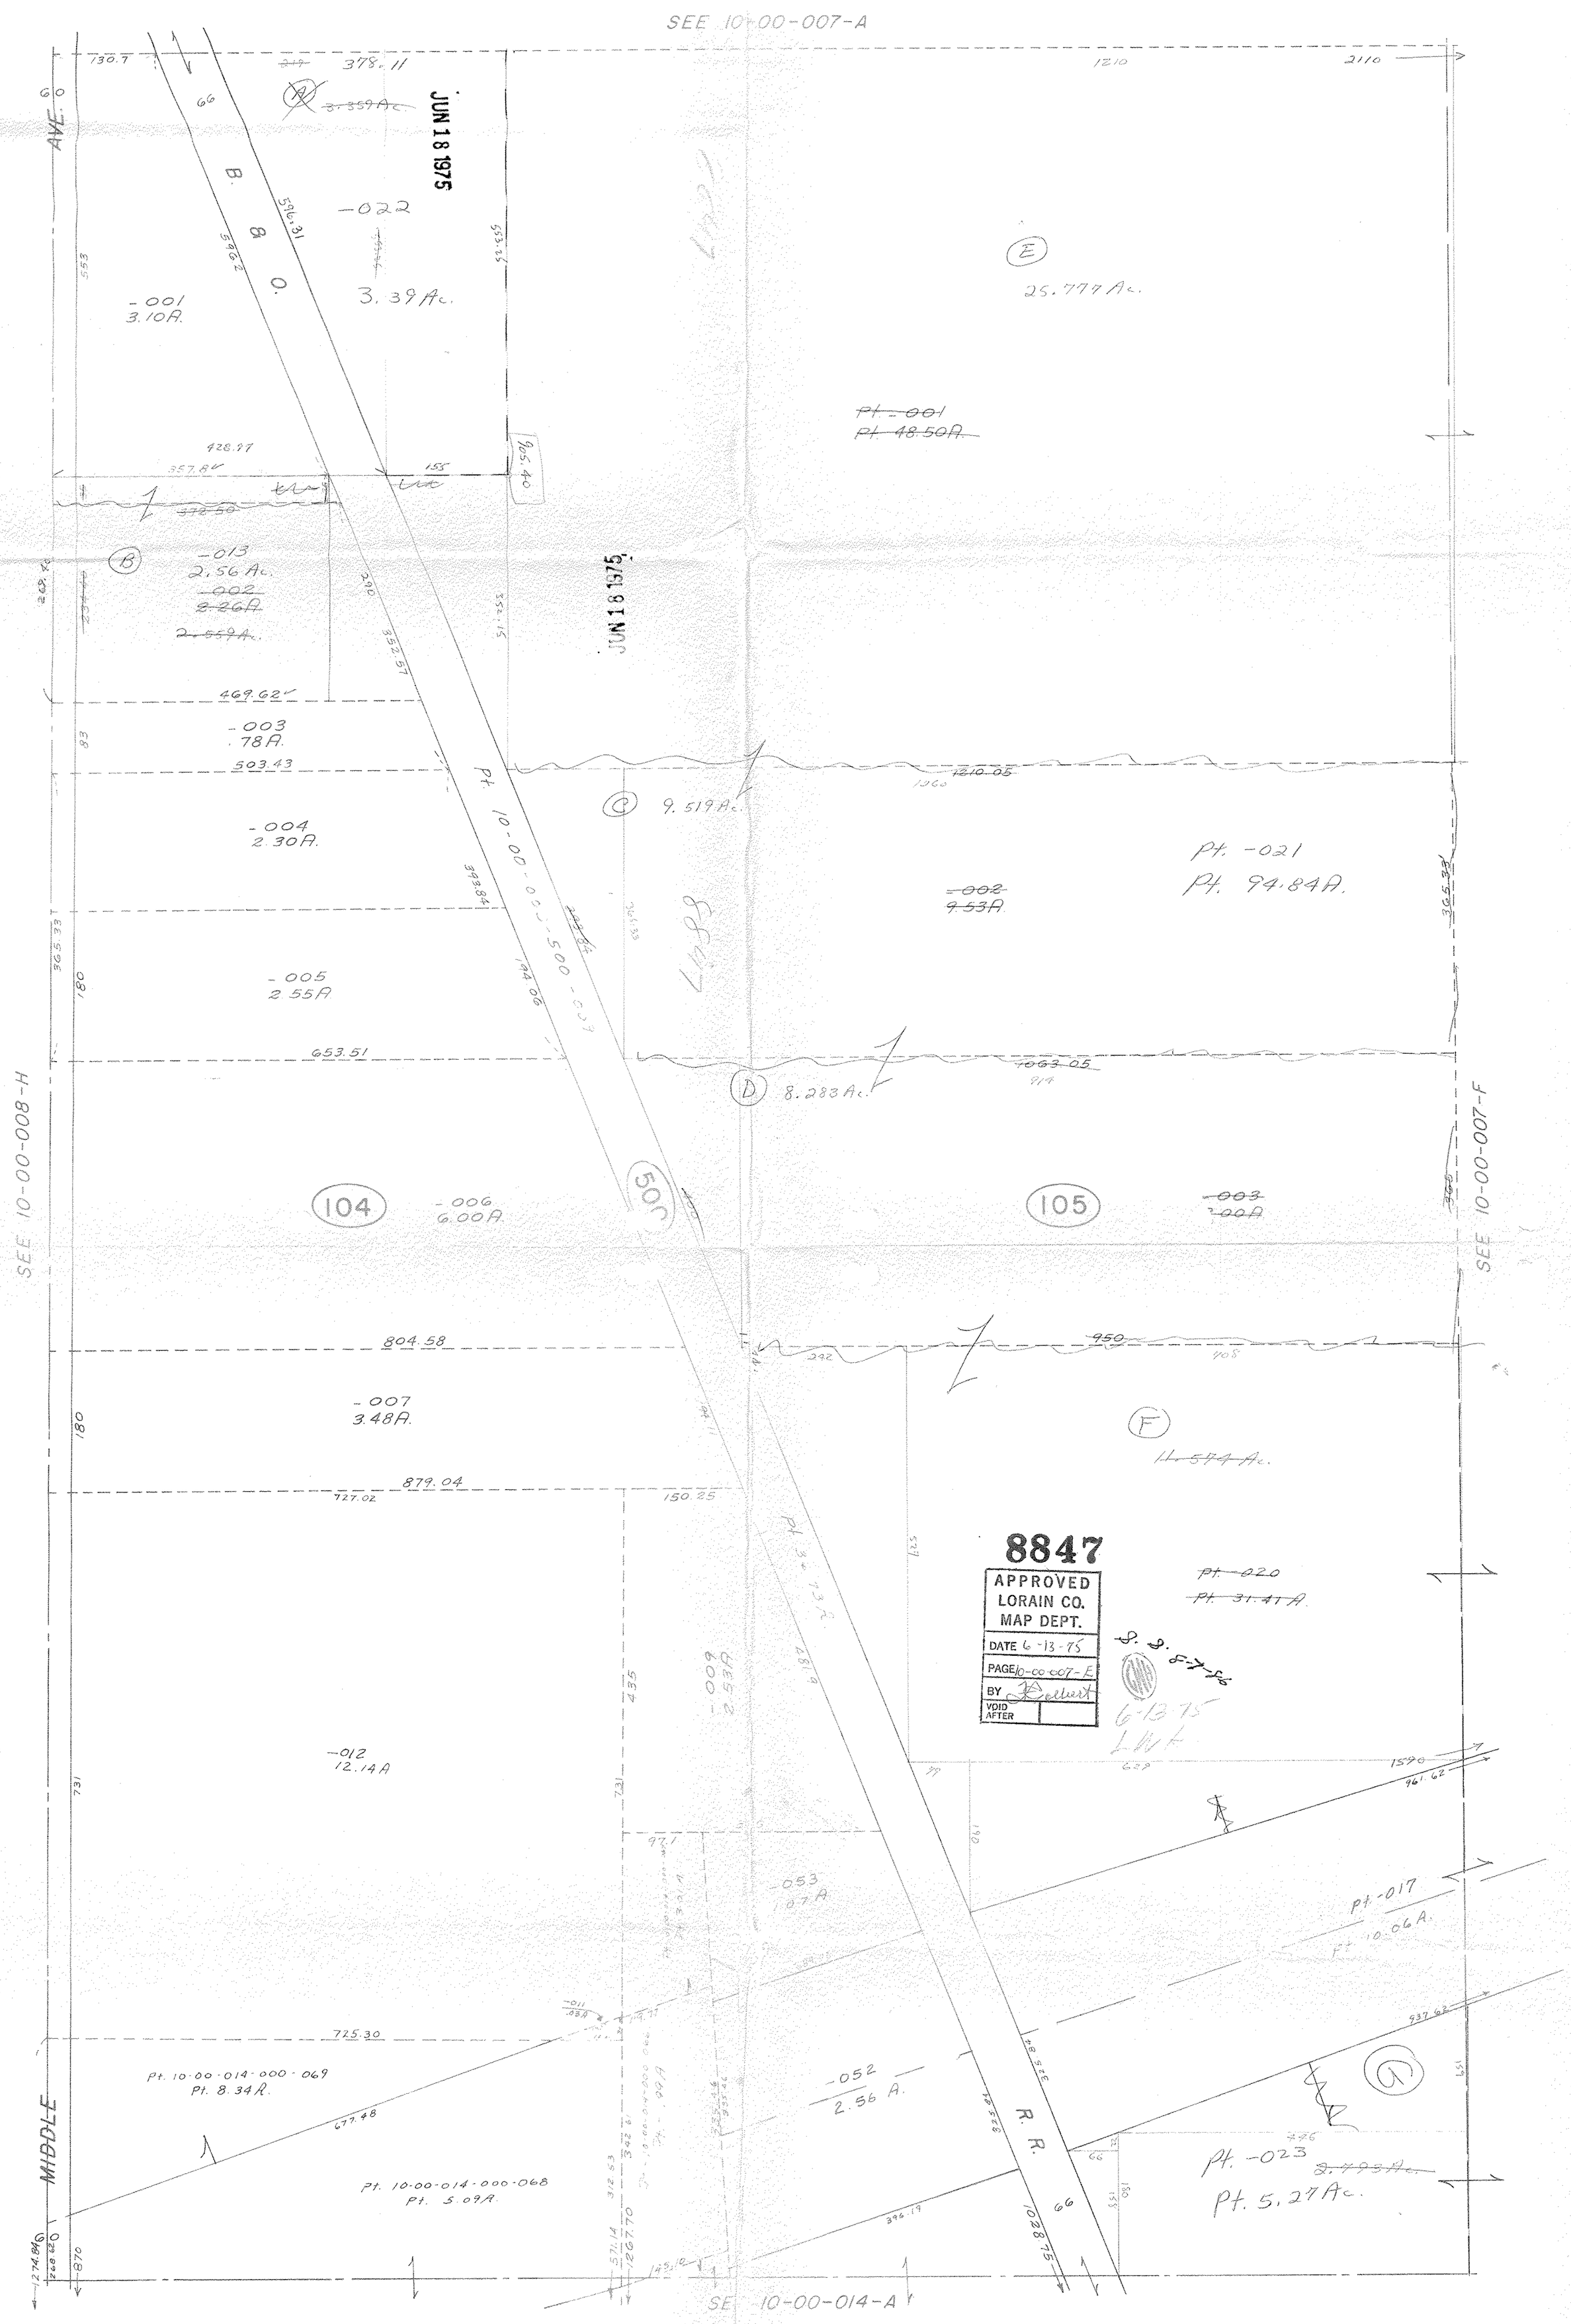

CARLISLE TWP

SCALE: 1" = 100'

W. 1/2 S.W. 1/4 SEC. 7

1963

00-007-E