


SEE 6-4

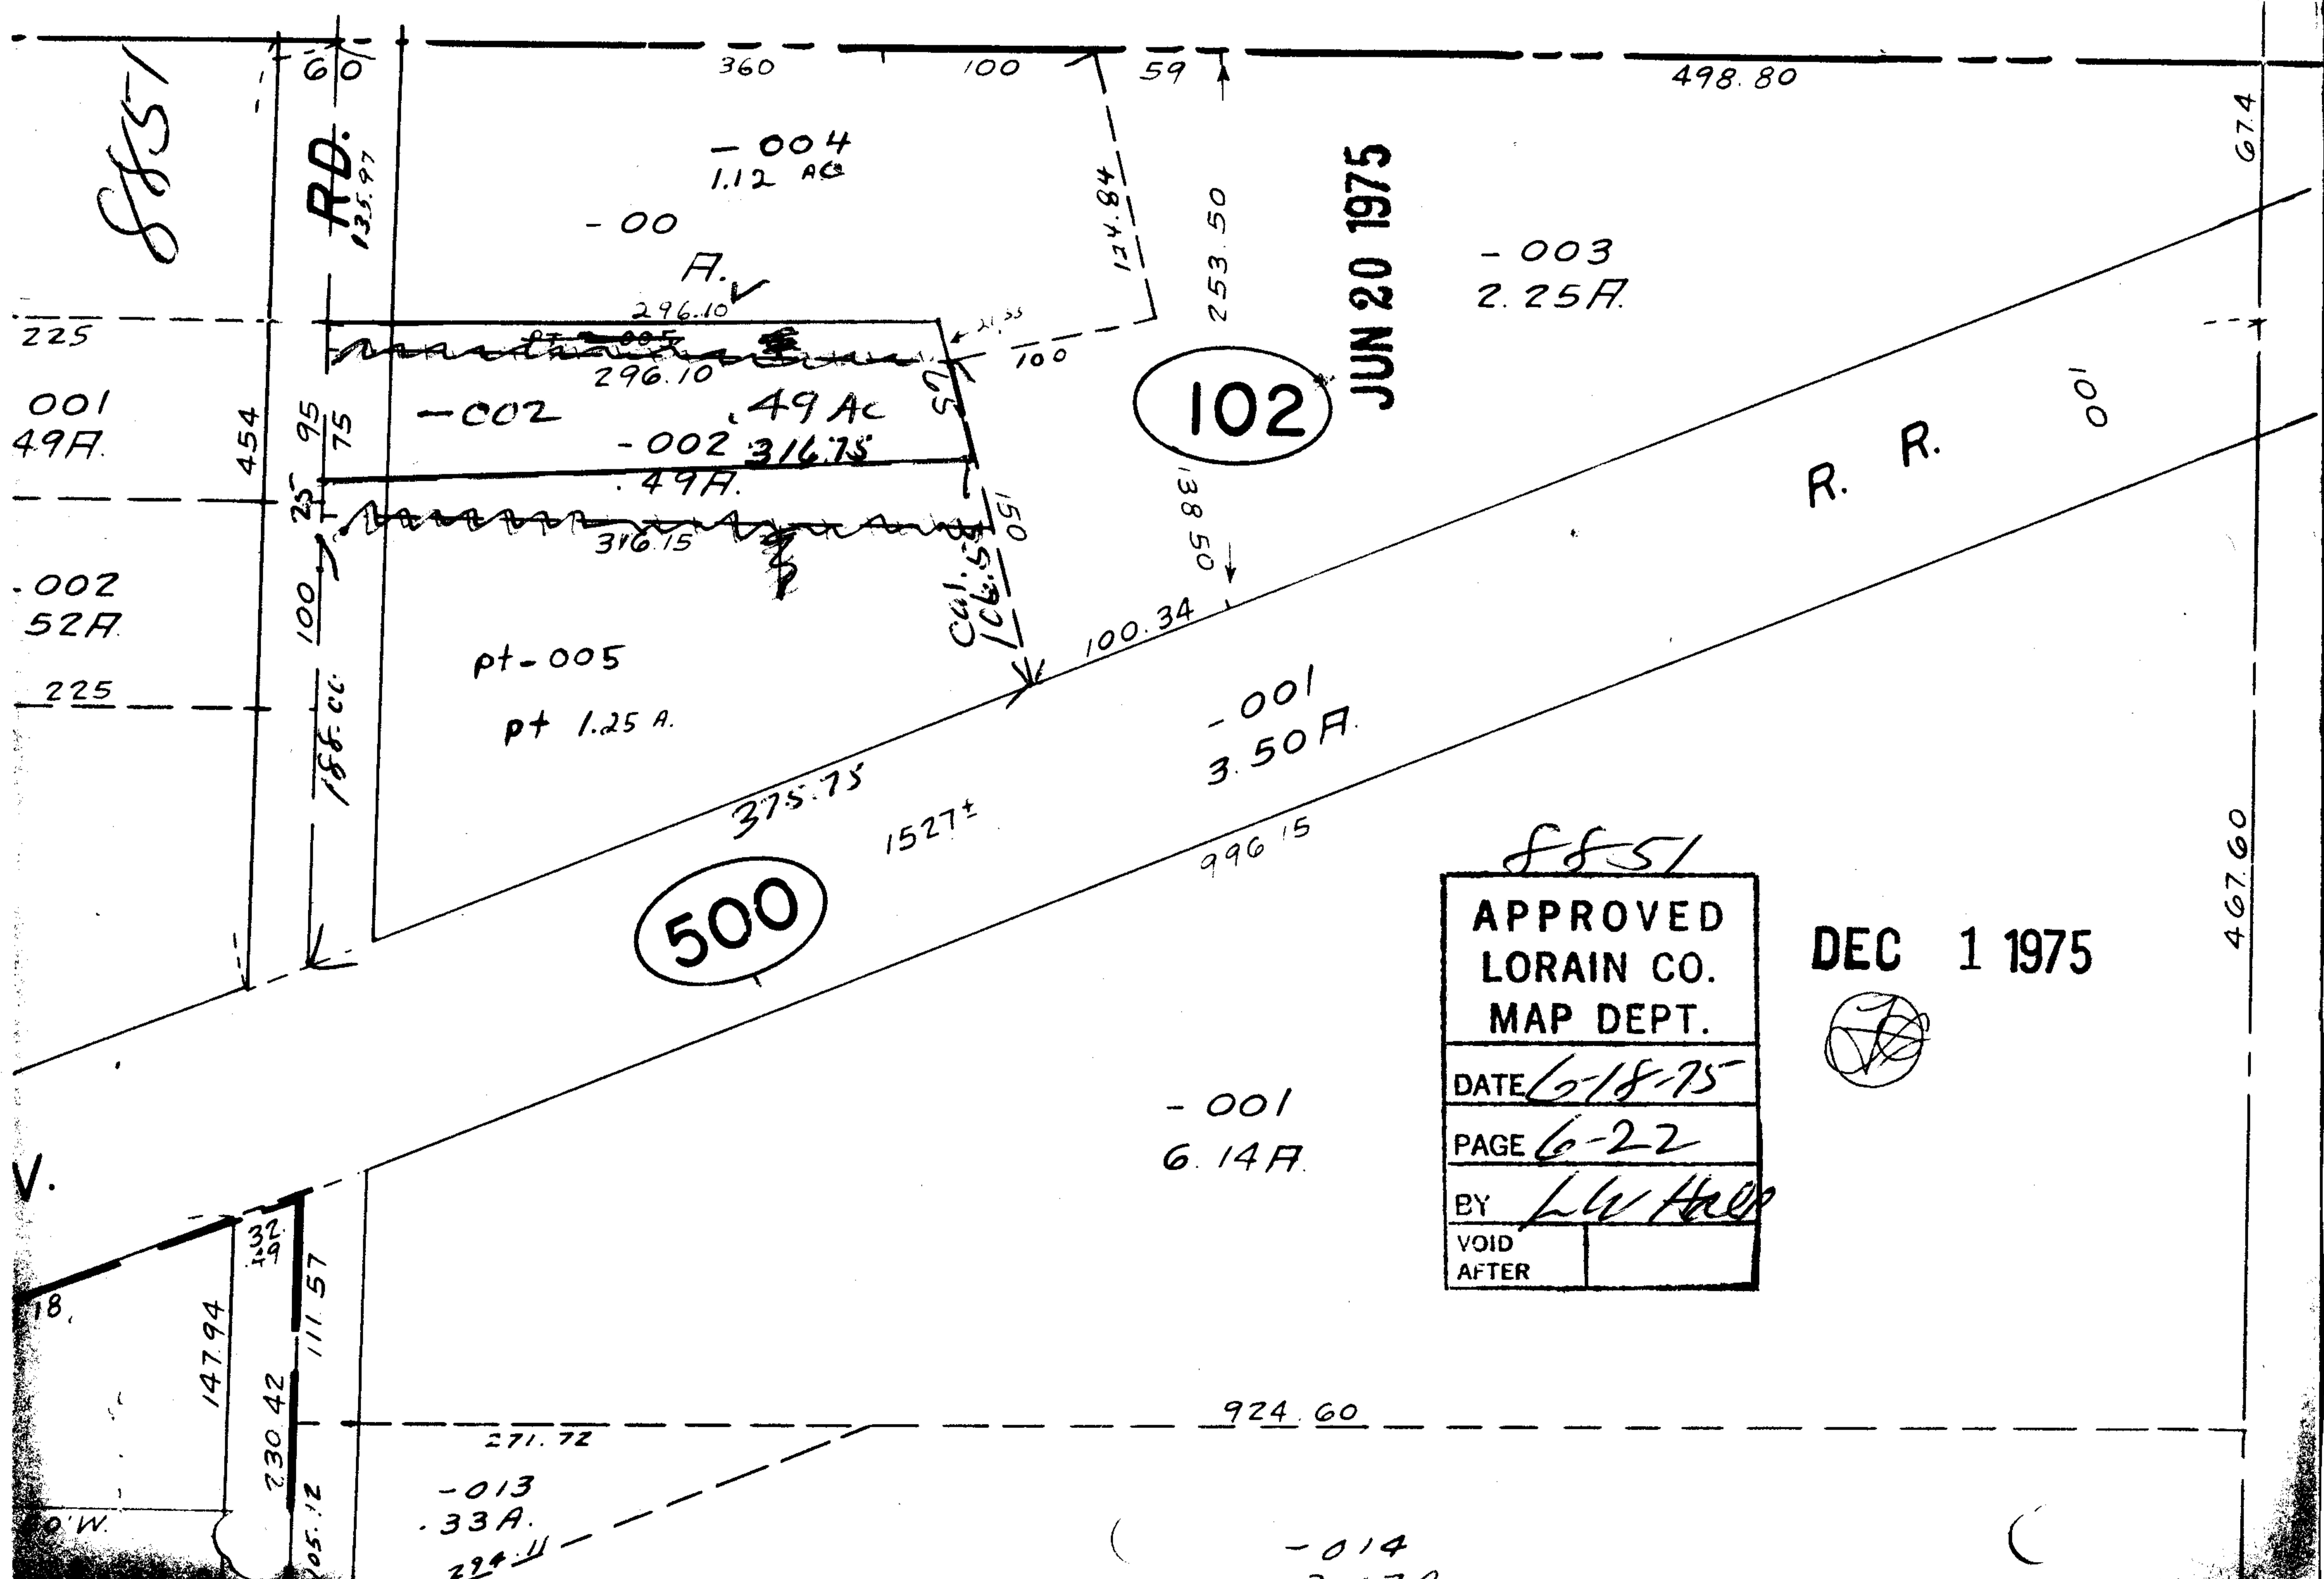

JUN 20 1975

8851

APPROVED	
LORAIN CO.	
MAP DEPT.	
DATE	6-18-75
PAGE	6-22
BY	LW Hall
VOID	
AFTER	

DEC 1 1975

