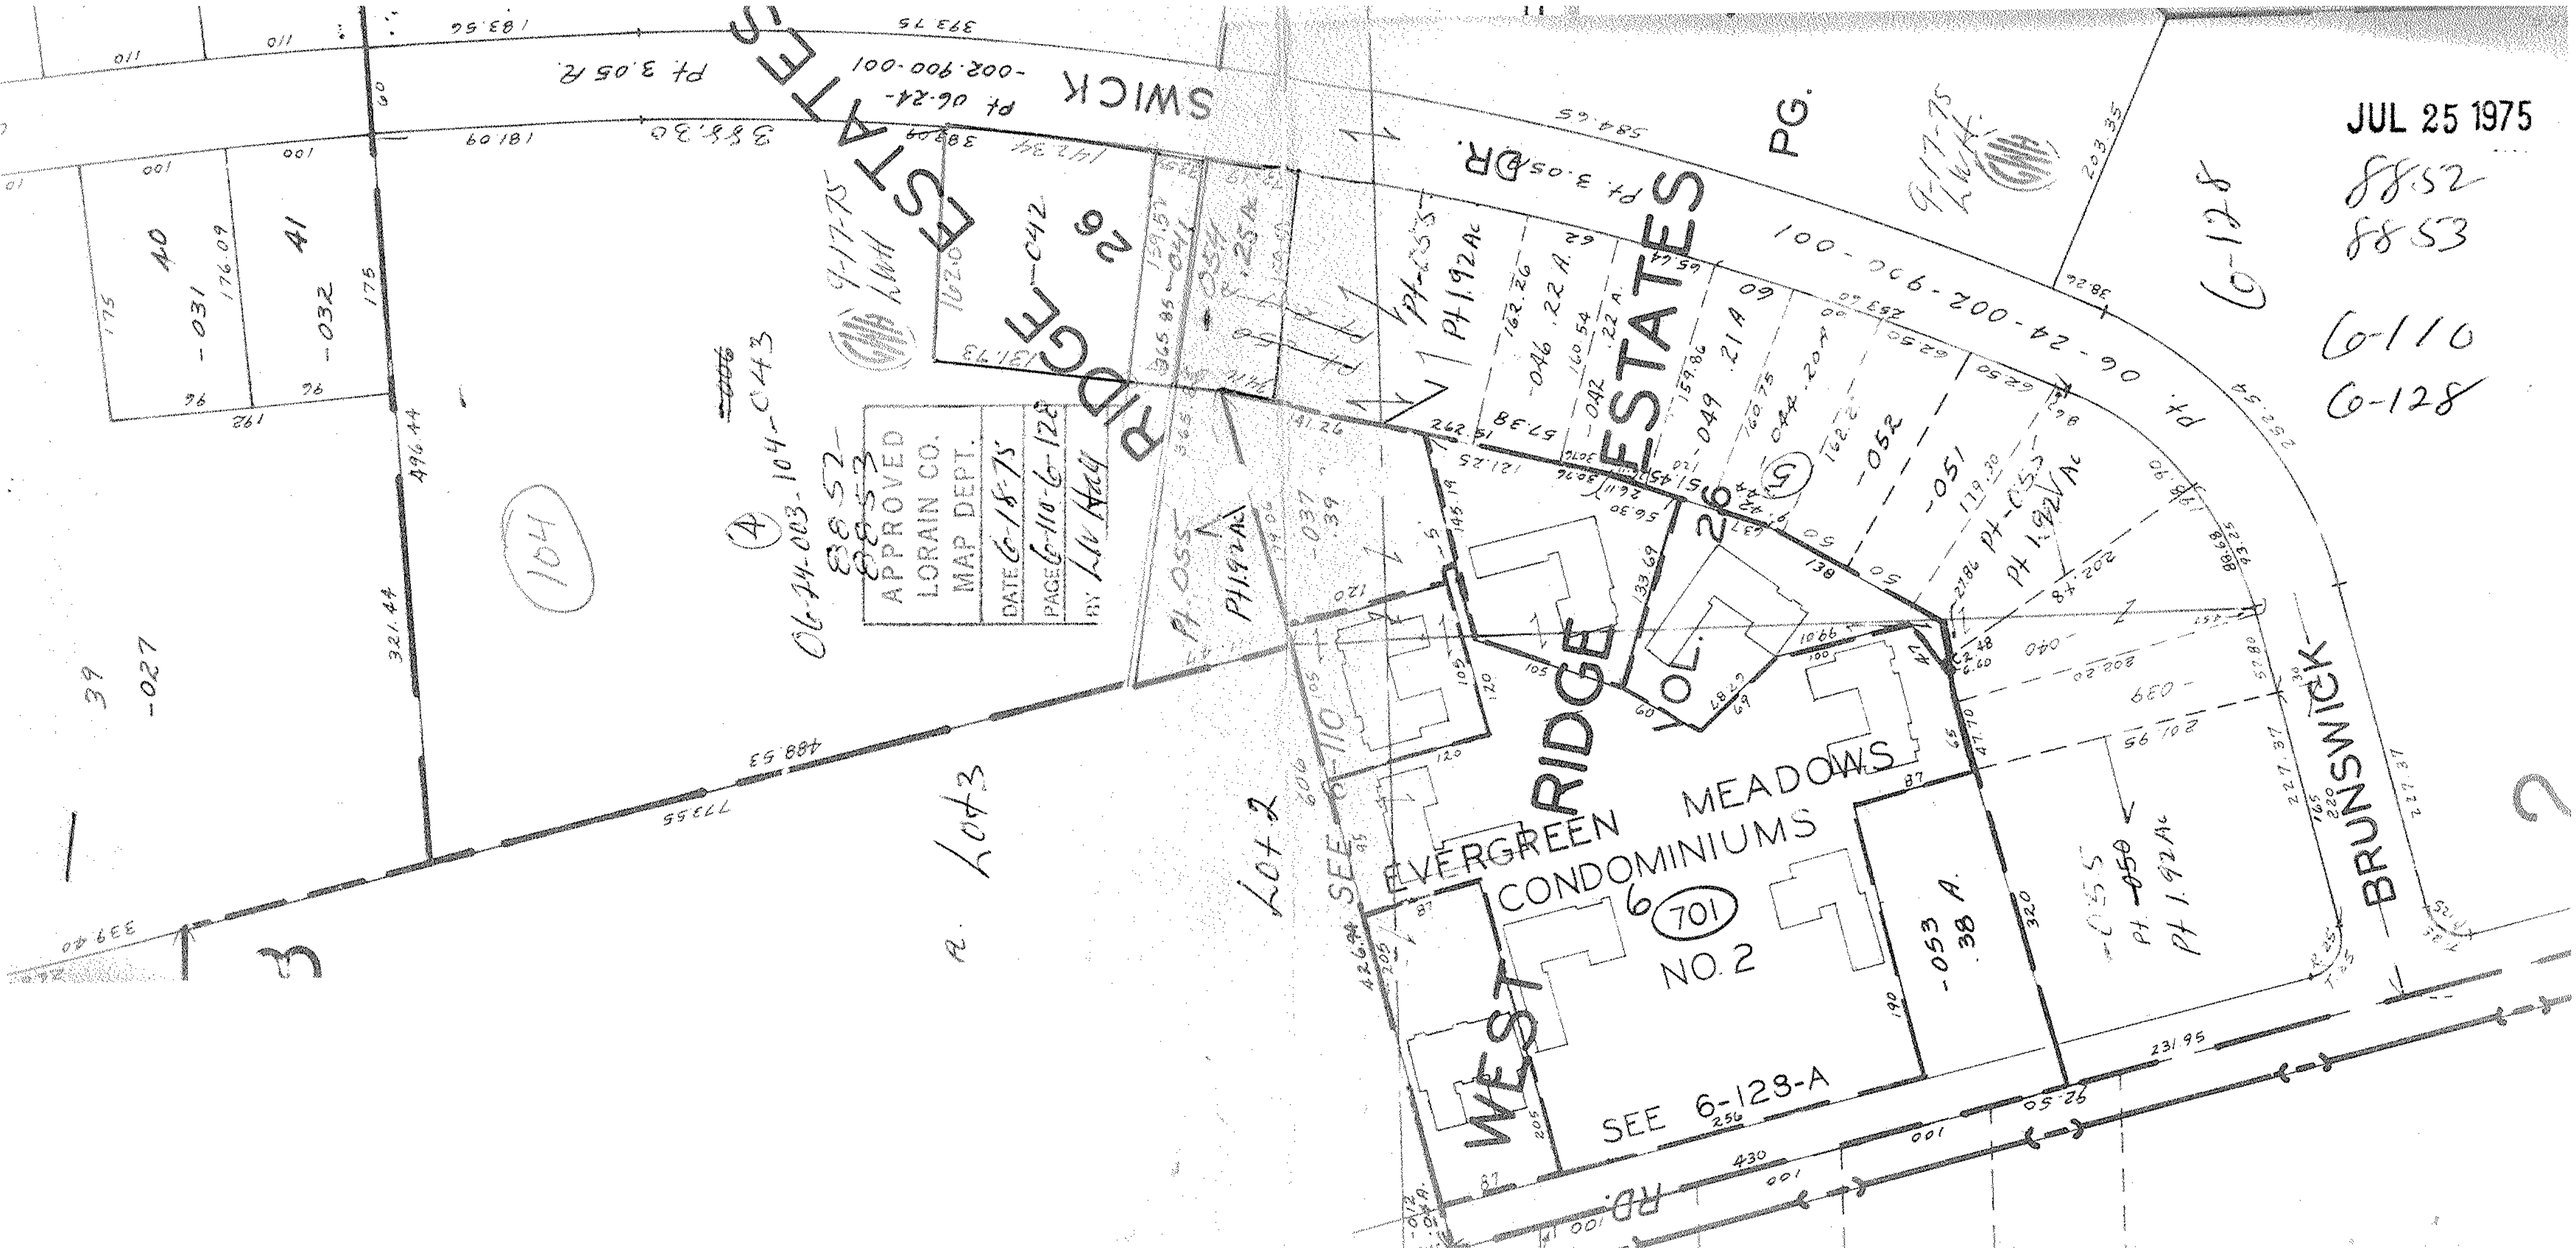
JUL 25 1975
88-52
88-53
6-110
6-128
APPROVED
LORAIN CO.
MAP DEPT.
DATE 6-18-75
PAGE 6-110-6-128
BY
SEE 6-110
SEE 6-128-A
EVERGREEN MEADOWS
CONDOMINIUMS
NO. 2
RIDGE ESTATES
WEST
BRUNSWICK
SWICK
STATES
PG.
Pt 3.05 AC
Pt 1.92 Ac
Pt 1.25 Ac
Pt 1.55 Ac
Pt 1.92 Ac
Pt 1.92 Ac
Pt 1.92