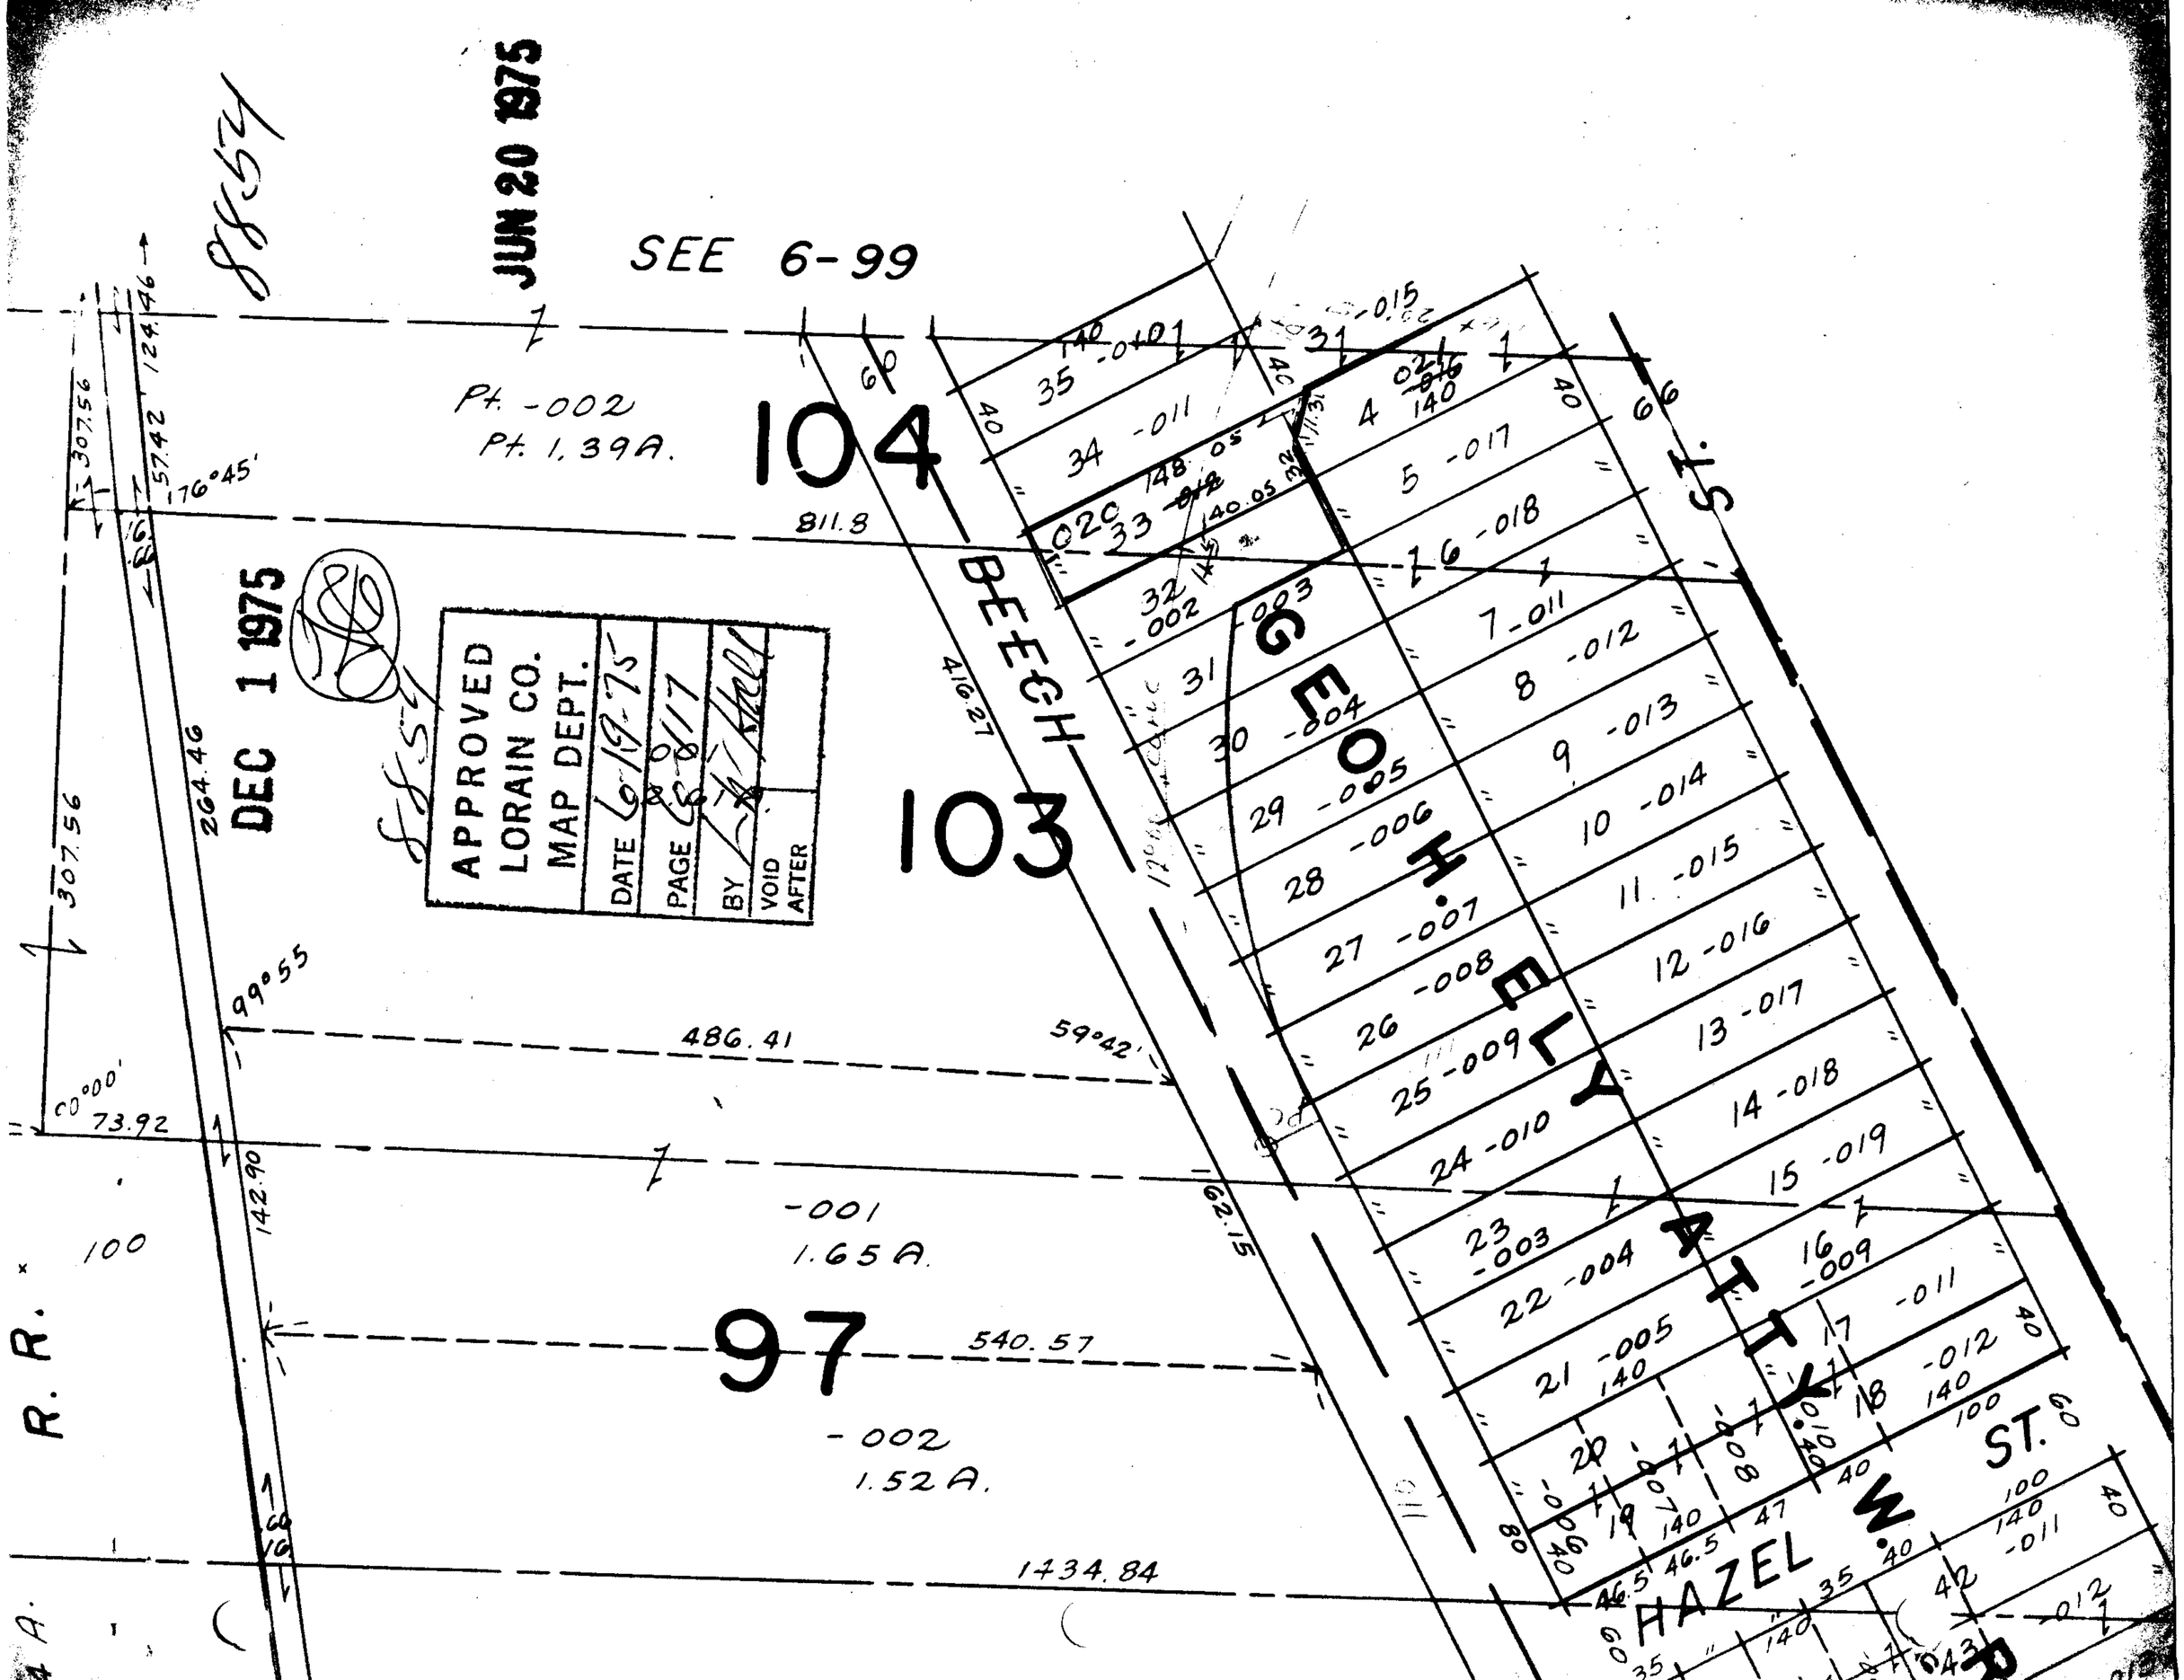

JUN 20 1975
SEE 6-99
8854
Pt. -002
Pt. 1.39A.
104
103
97
BEECH
GEOHELY ATTY.
HAZEL W. ST.
ST.
R. R.
DEC 1 1975
APPROVED
LORAIN CO.
MAP DEPT.
DATE 6-19-75
PAGE 6-117
BY
VOID AFTER
811.8
416.27
486.41
59°42'
162.15
540.57
1434.84
264.46
307.56
176°45'
99°55
73.92
142.90
-001
1.65A.
-002
1.52A.