


366
324 1325 104 70
36
36
25
2
TUSCARAWAS

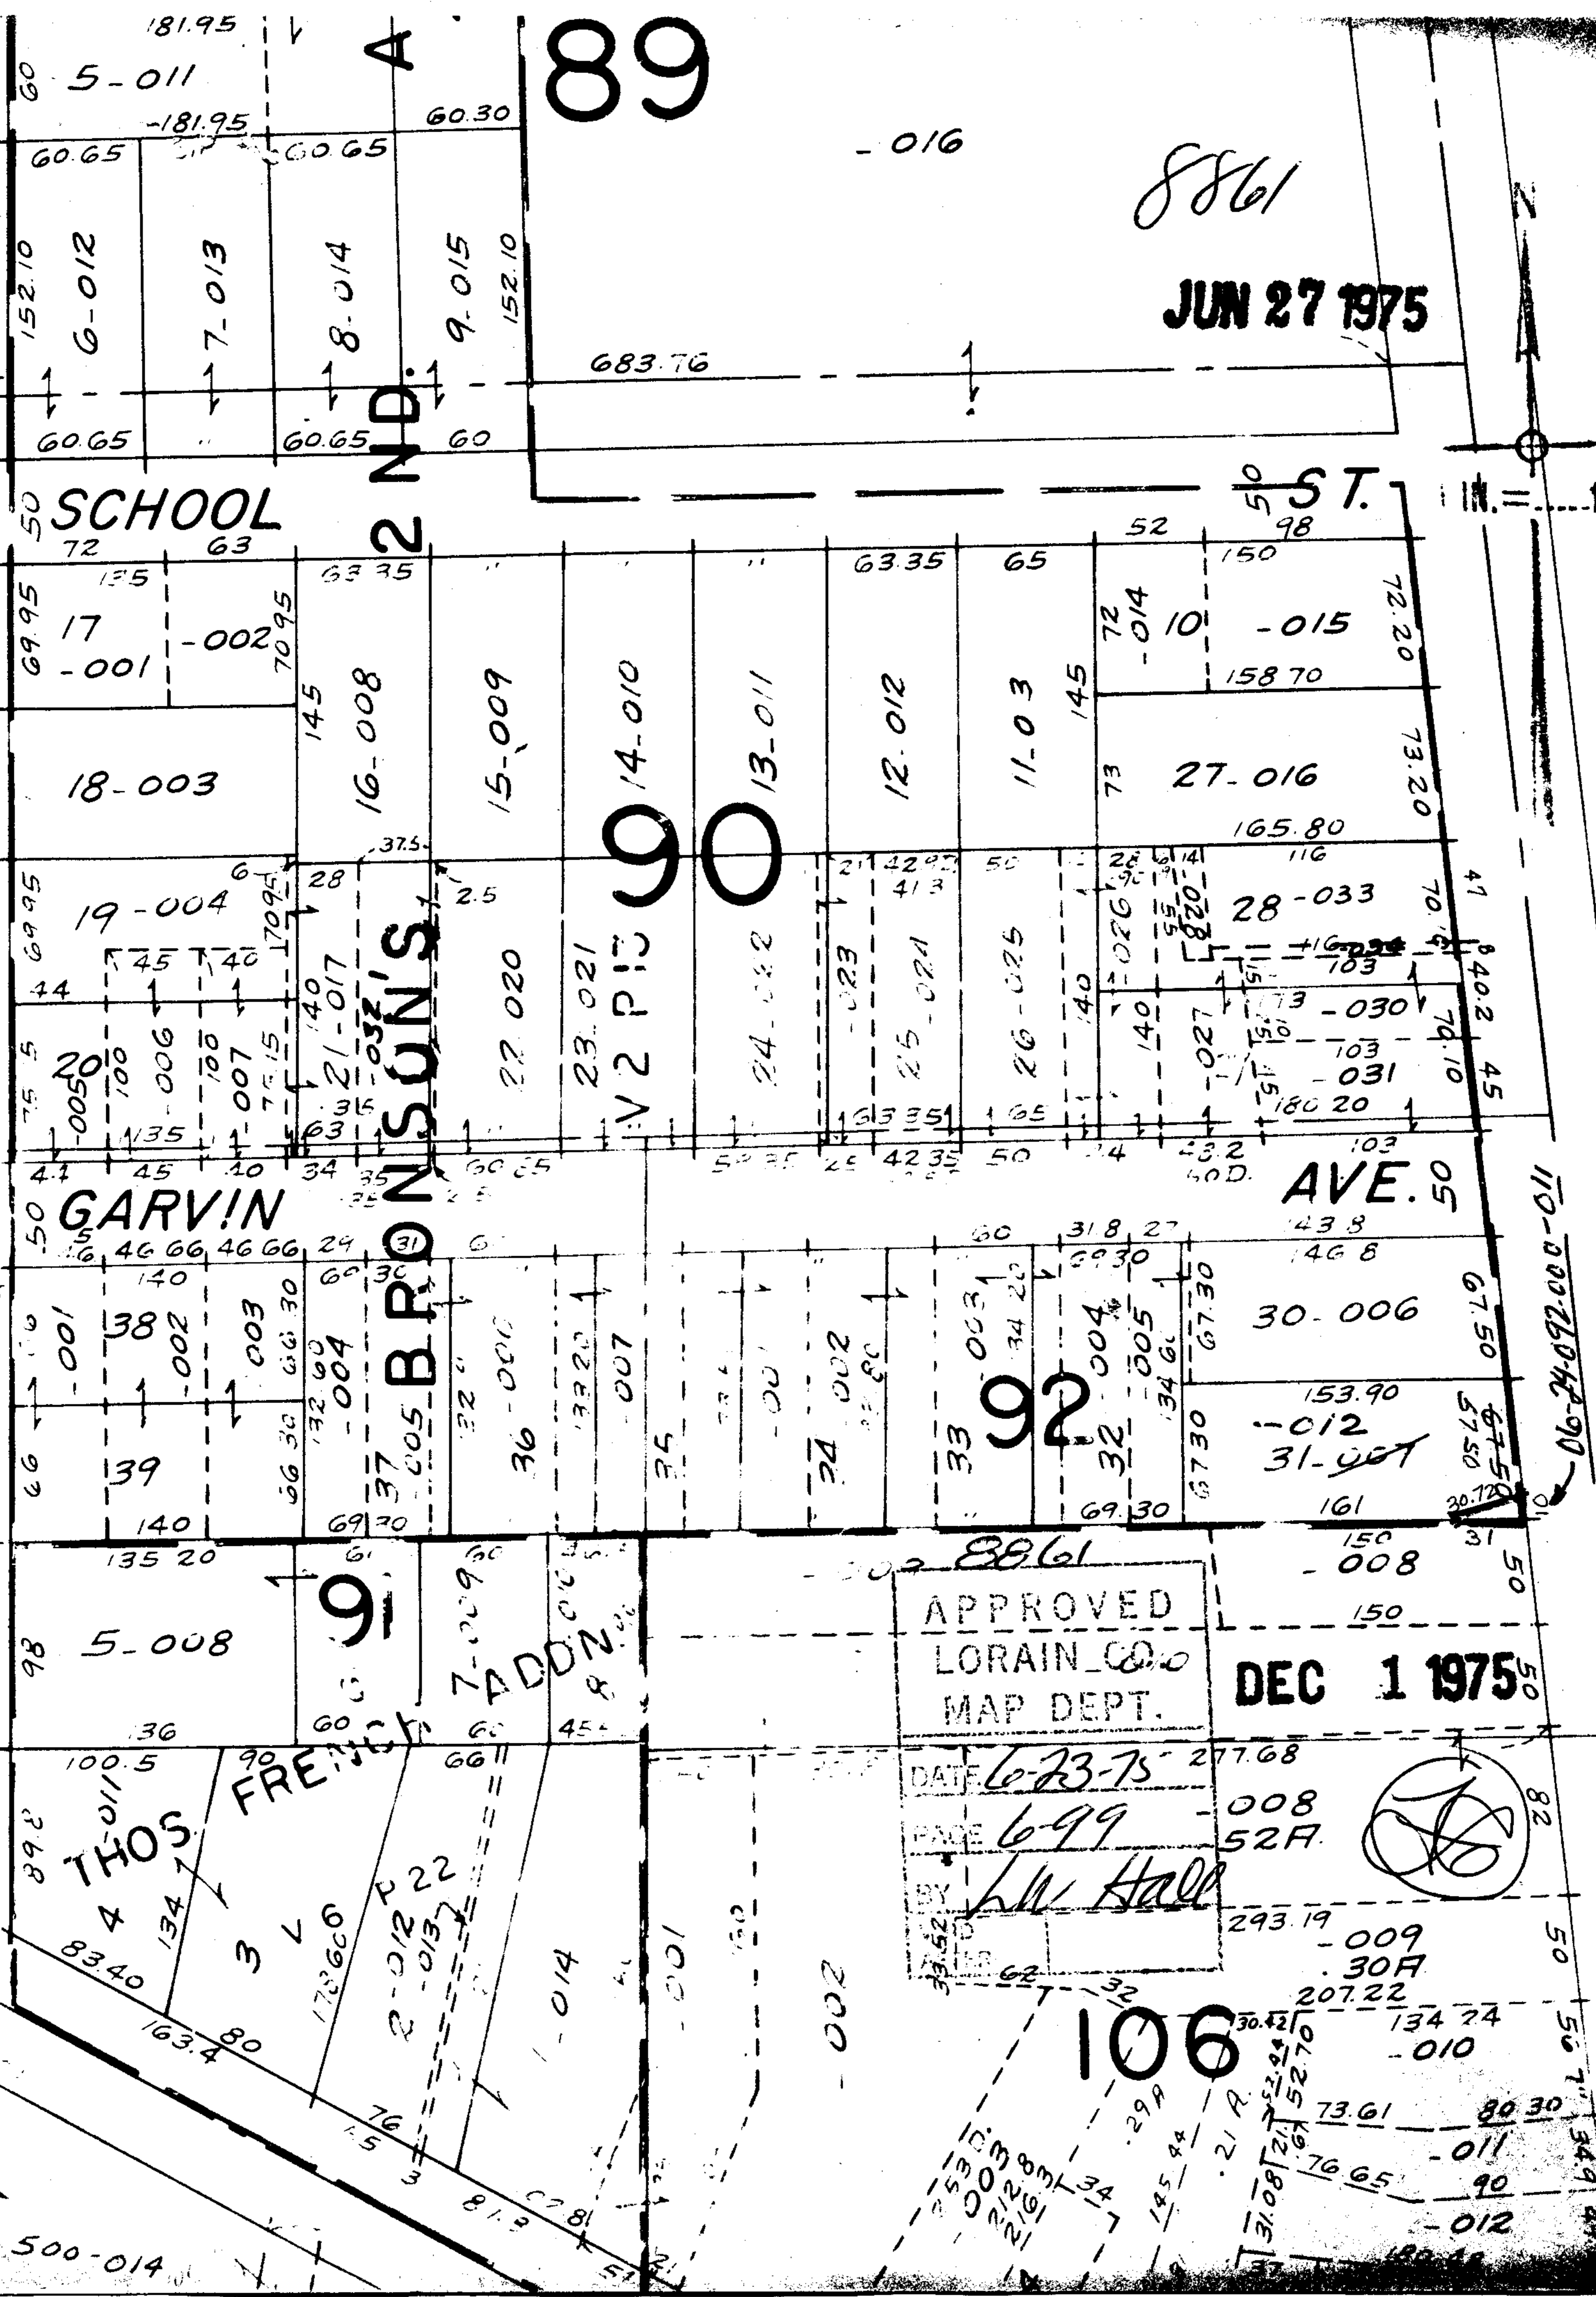

89

8861

JUN 27 1975

SCHOOL

50 ST.

18-003

2ND

BRONSON'S

90

GARVIN

AVE. 50

TUSCARAWAS

APPROVED
LORAIN CO.
MAP DEPT.

DEC 1 1975

DATE 6-23-75
PAGE 699
L.W. Hall

106

SEE 6-100

10-000-260-90

094-500-014