

8864


JUN 25 1975

SEP 25 1975



8864

APPROVED
LORAIN CO.
MAP DEPT.
DATE 6-25-75
PAGE 11-00-099B
BY LW Hall
VOID AFTER

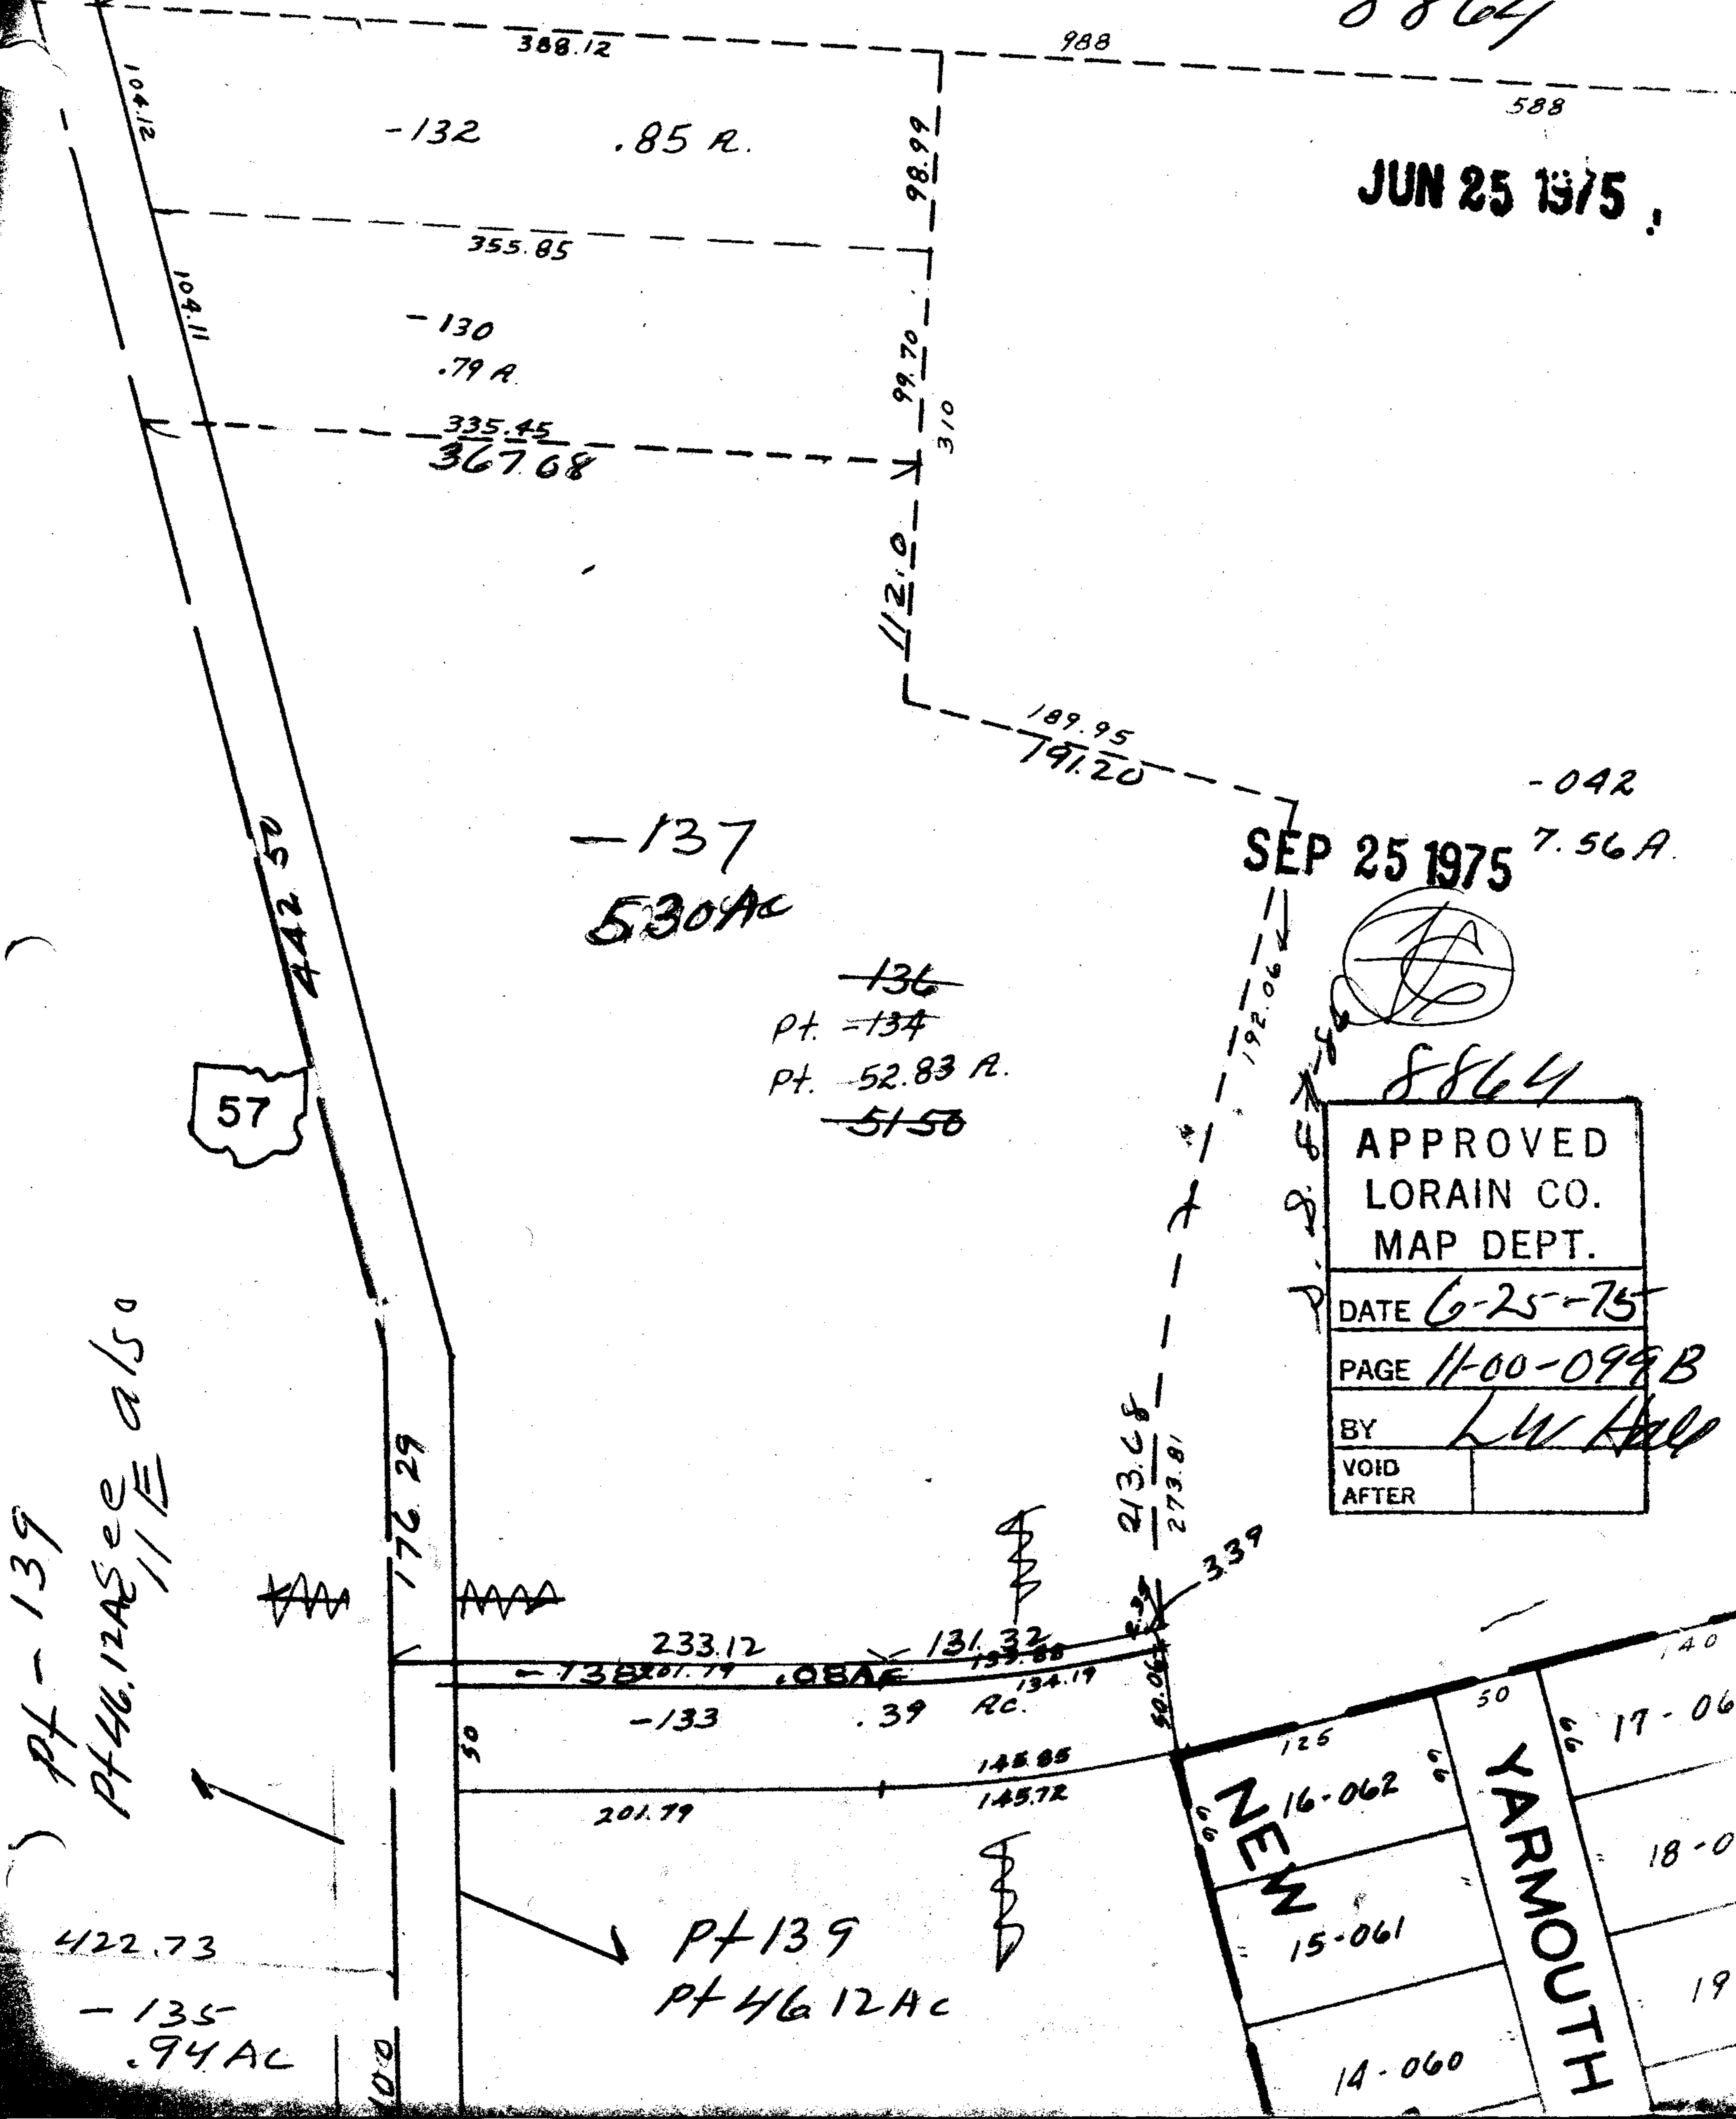

PT-139
 PT 4612 AC also
 11 E

57

 16-062
 15-061
 14-060
 YARMOUTH
 17-063
 18-06
 19-