


SUGAN

PL 07-00-048-000-052 8898
PT 504 AC

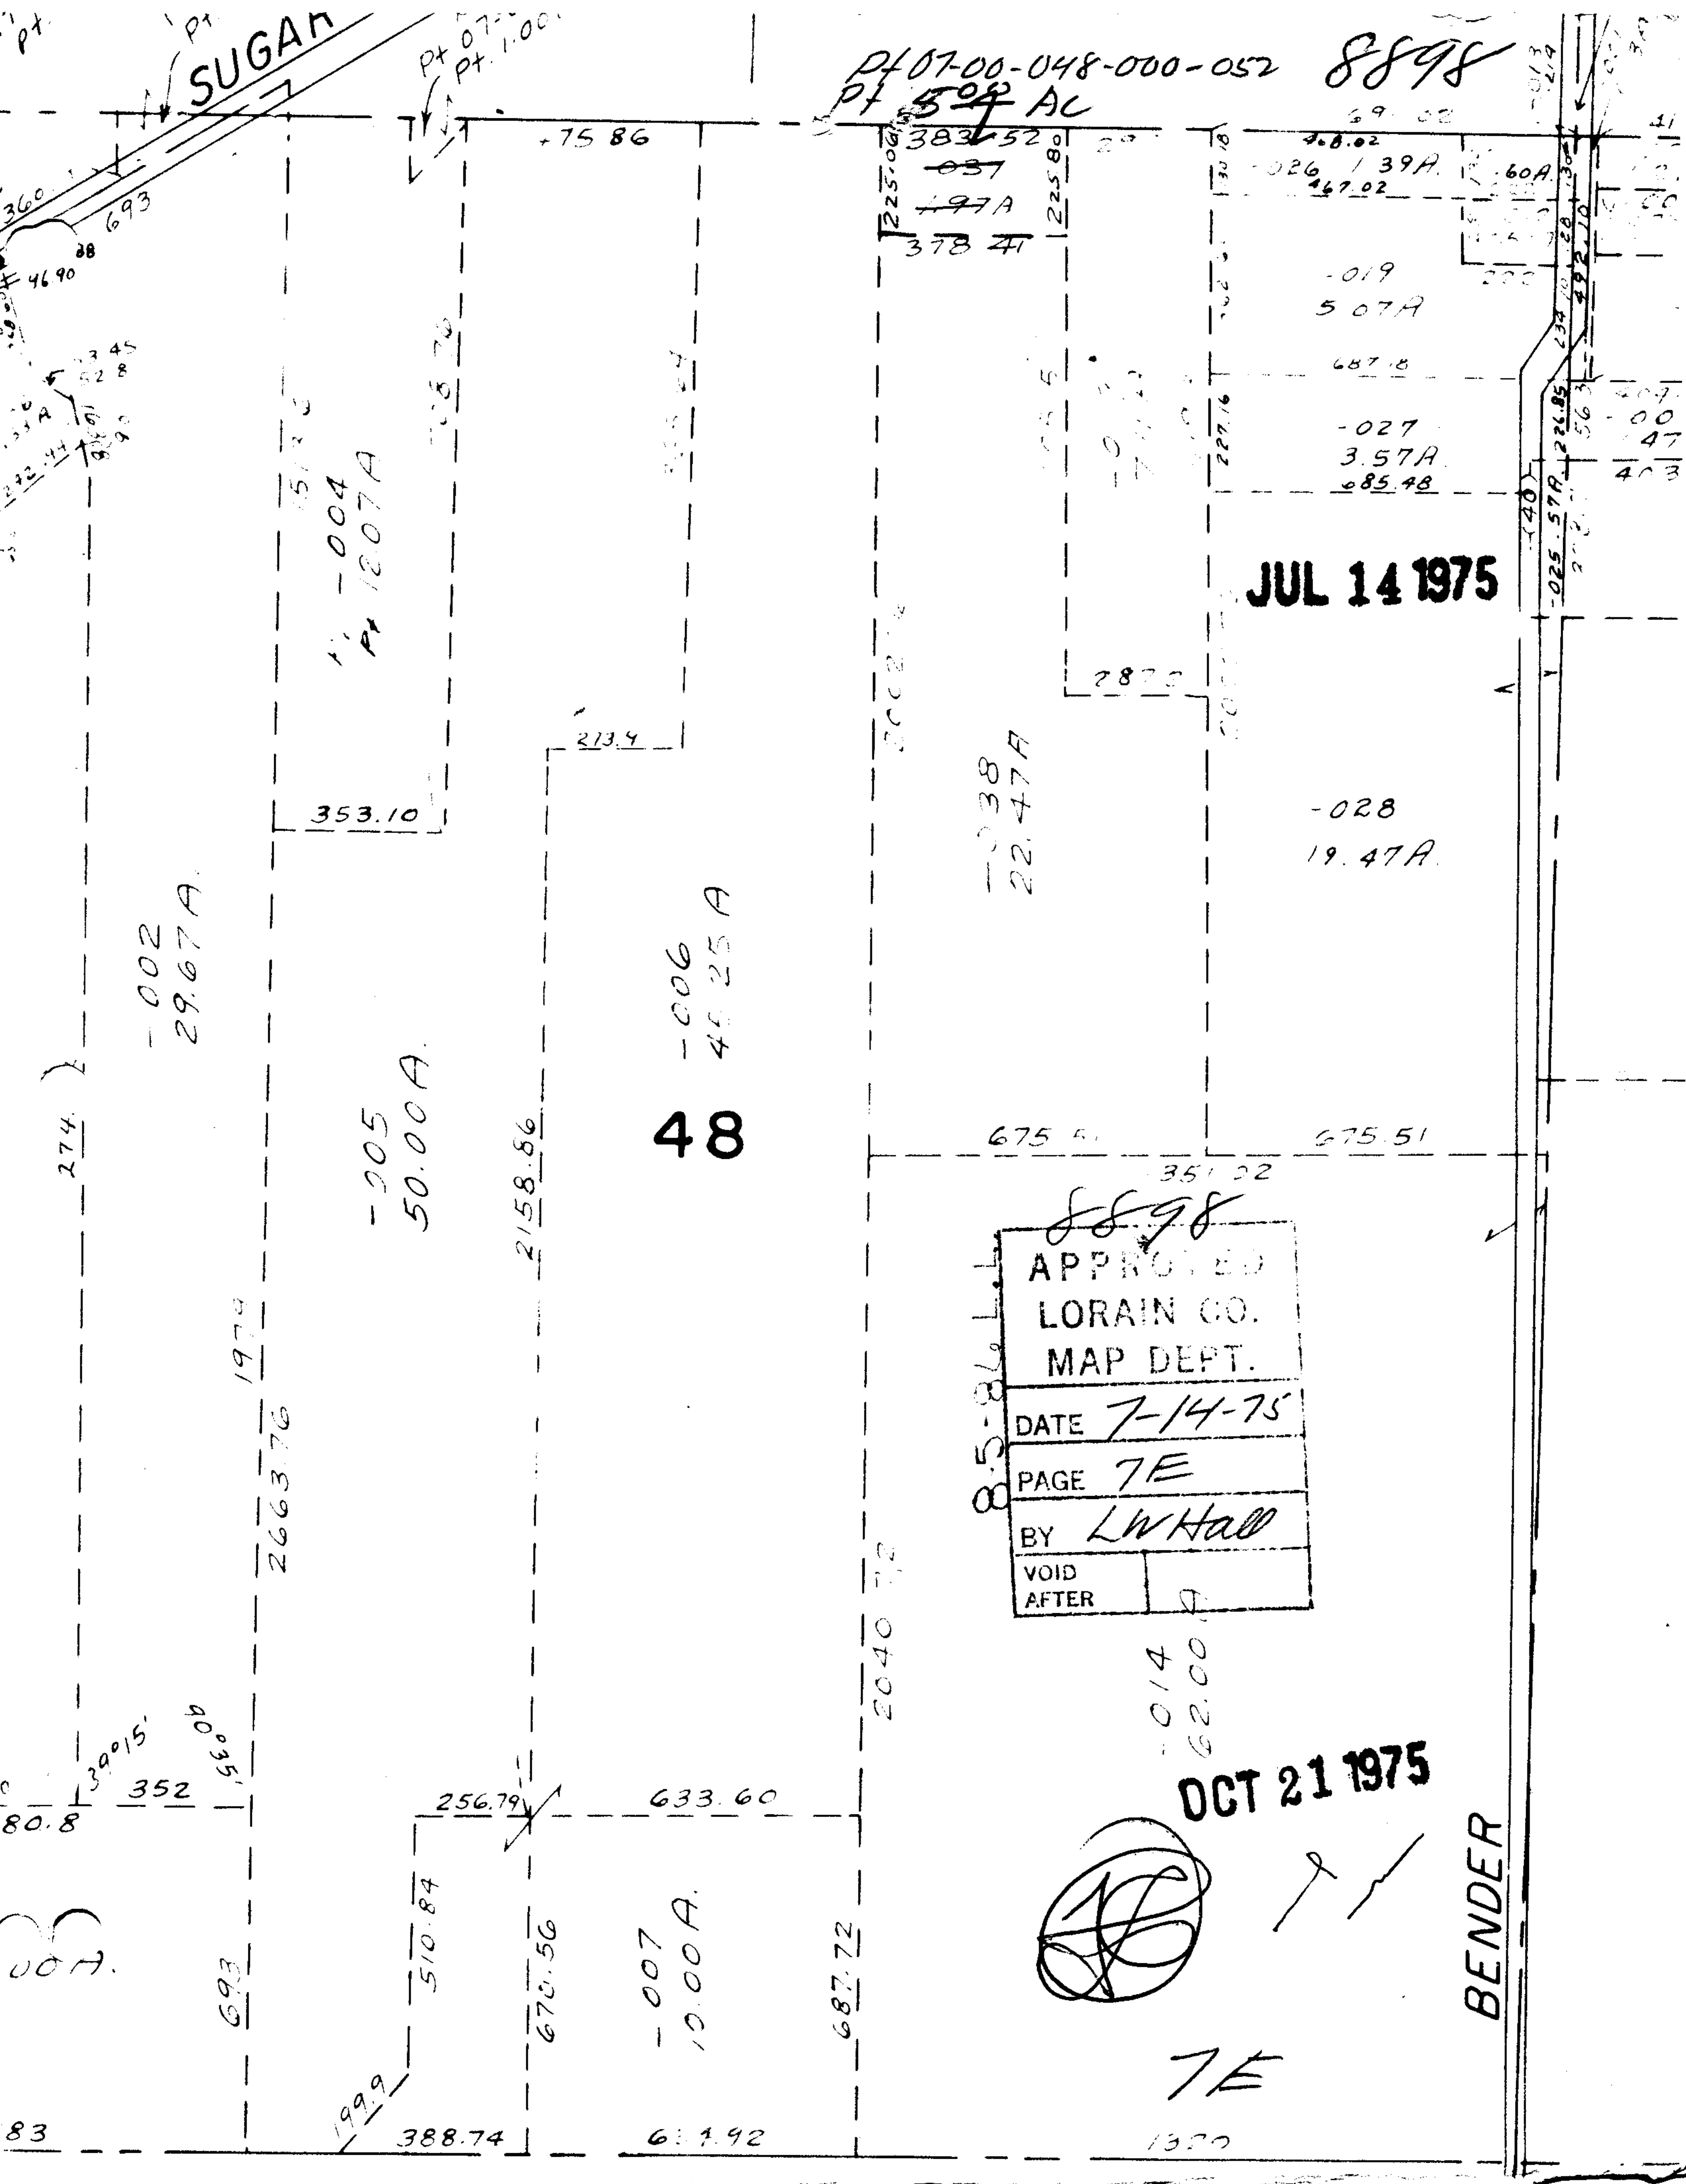

-004
12.07 A

-002
29.67 A

-005
50.00 A

48
-006
45.25 A

JUL 14 1975

8898
APPROVED
LORAIN CO.
MAP DEPT.
DATE 7-14-75
PAGE 7E
BY LWHad
VOID AFTER

OCT 21 1975

BENDER

7E