


Map For  
3 splits

039  
040  
041  
042

5-00-095A

SEE 5-00-094-

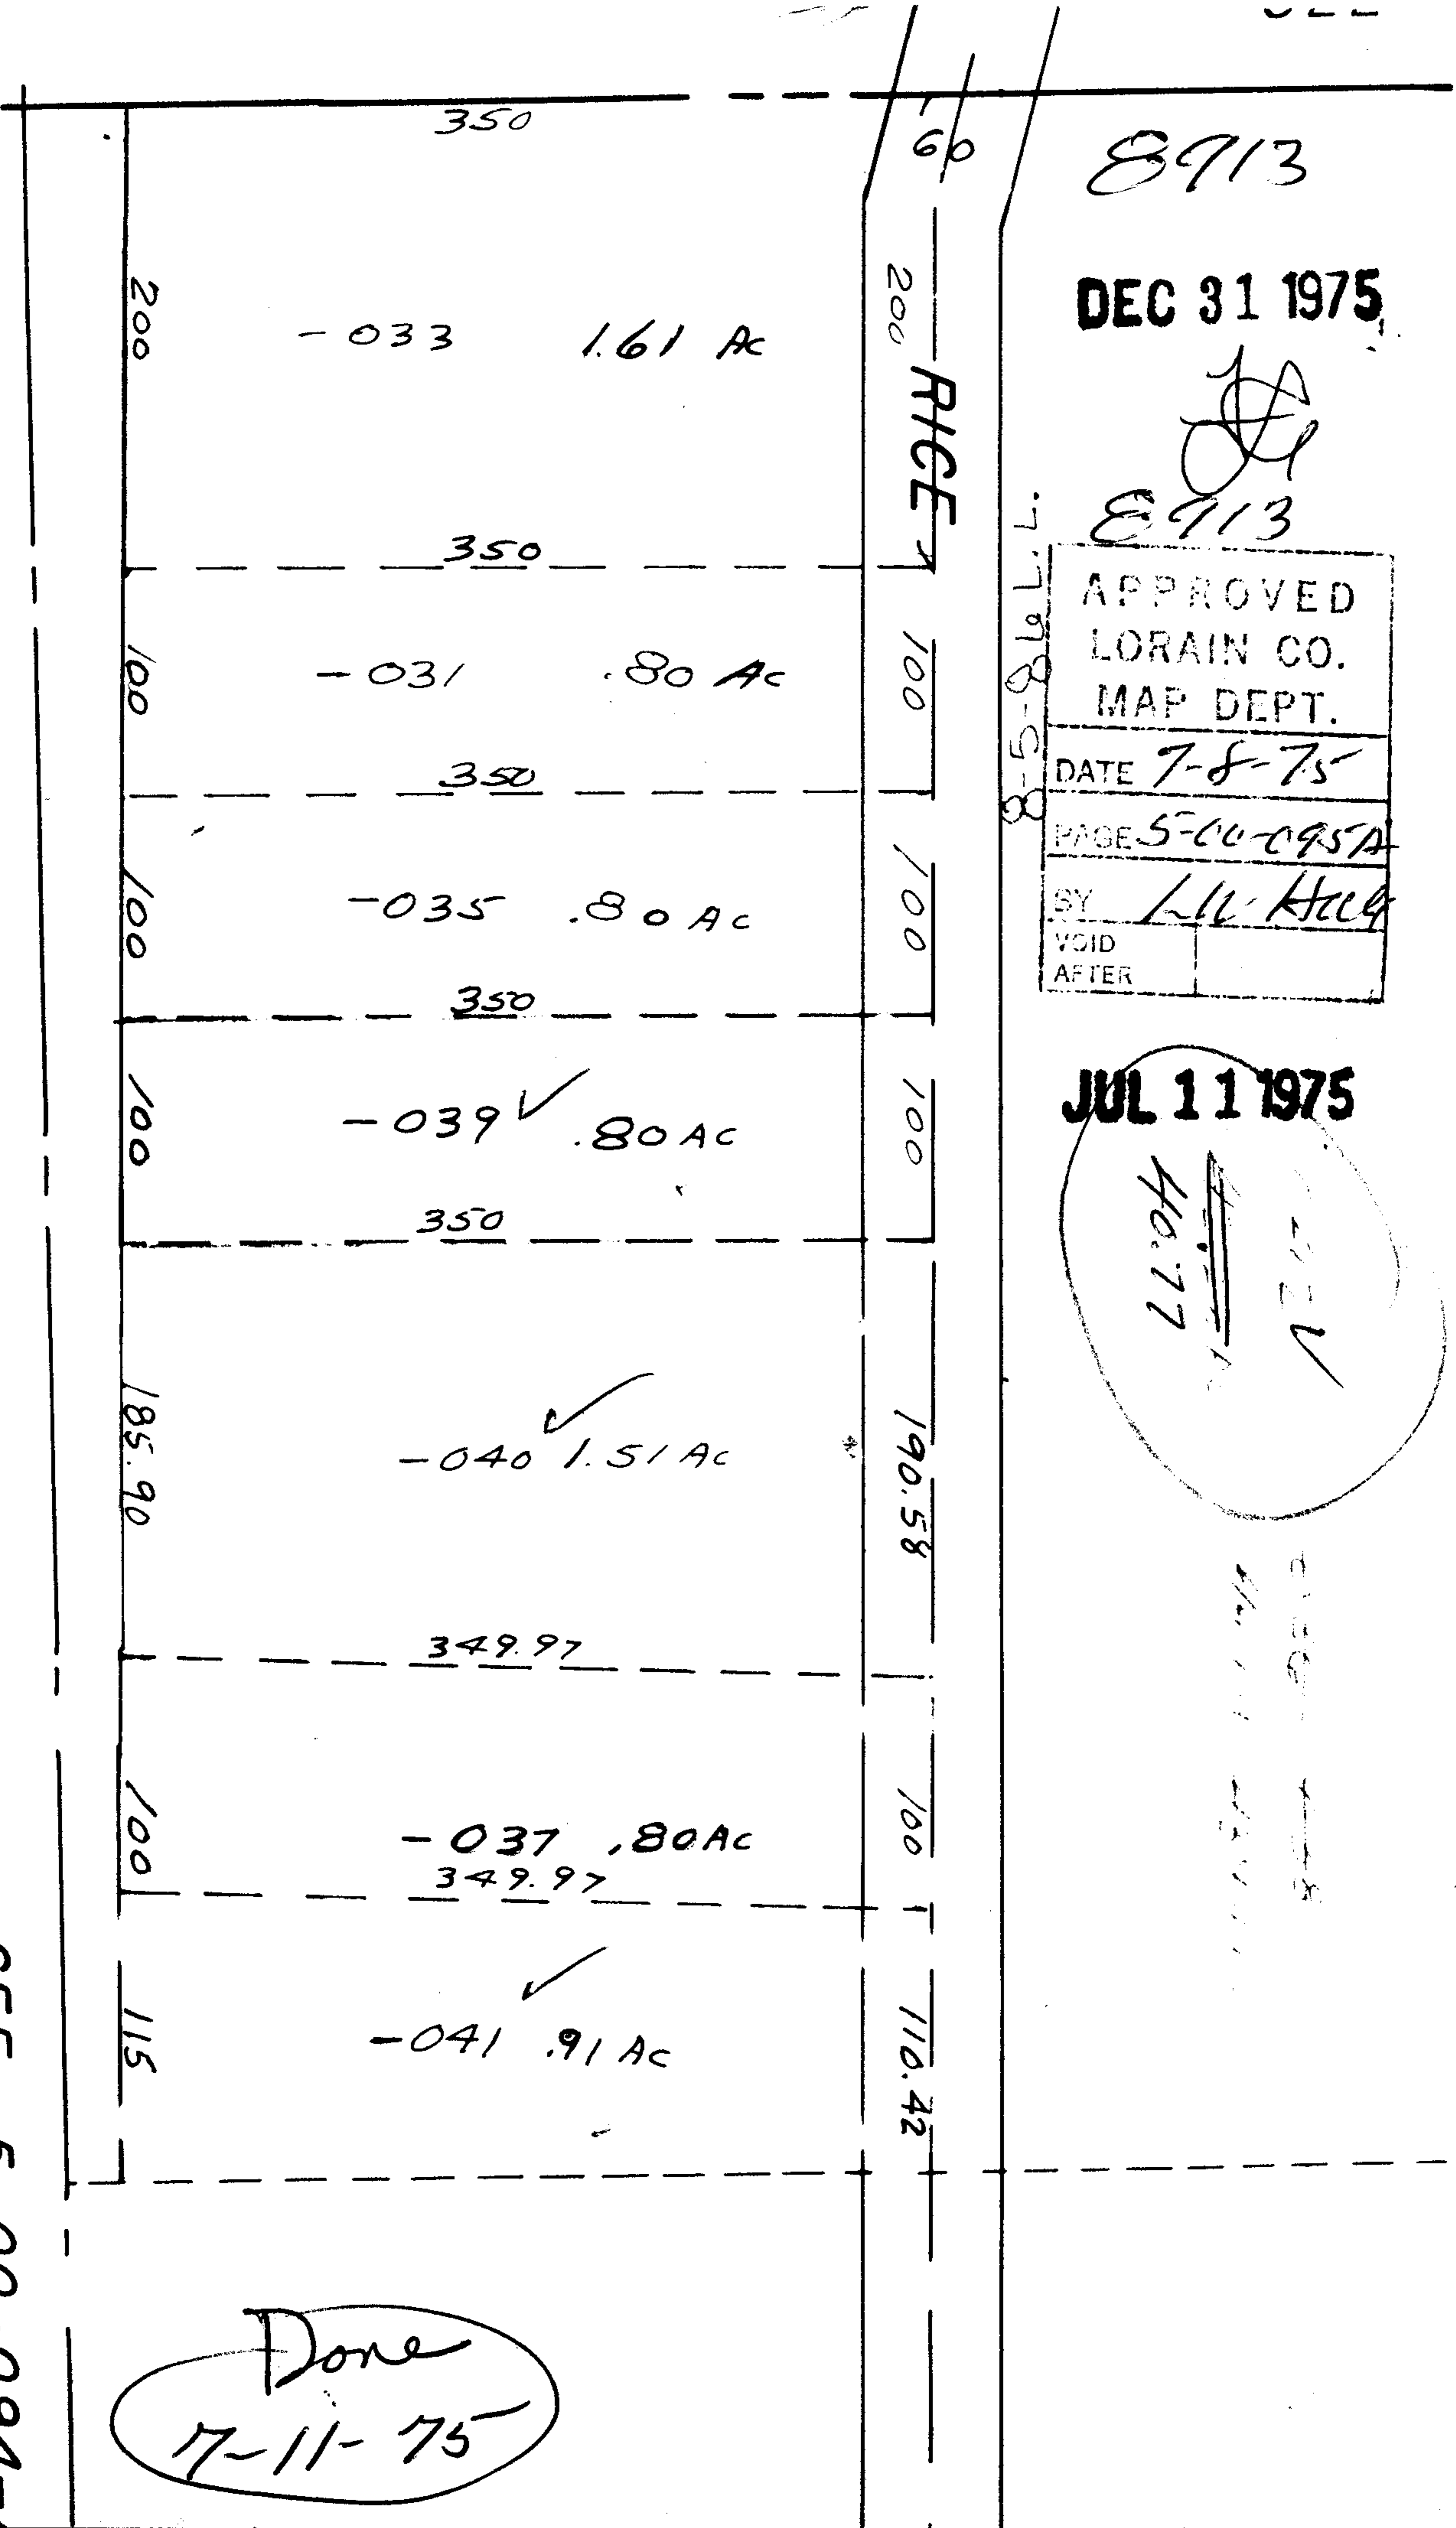

8913

DEC 31 1975

*[Signature]*

8913

APPROVED  
LORAIN CO.  
MAP DEPT.

DATE 7-8-75

PAGE 5-00-095A

BY L.W. HULL

VOID  
AFTER

JUL 11 1975

*[Handwritten notes in a circle]*  
40.77  
✓

*[Vertical handwritten notes]*