


8427

Dudley V. Bell
Appraisals

MAP SHOWING AREA OF TAKE

right of way
work limits

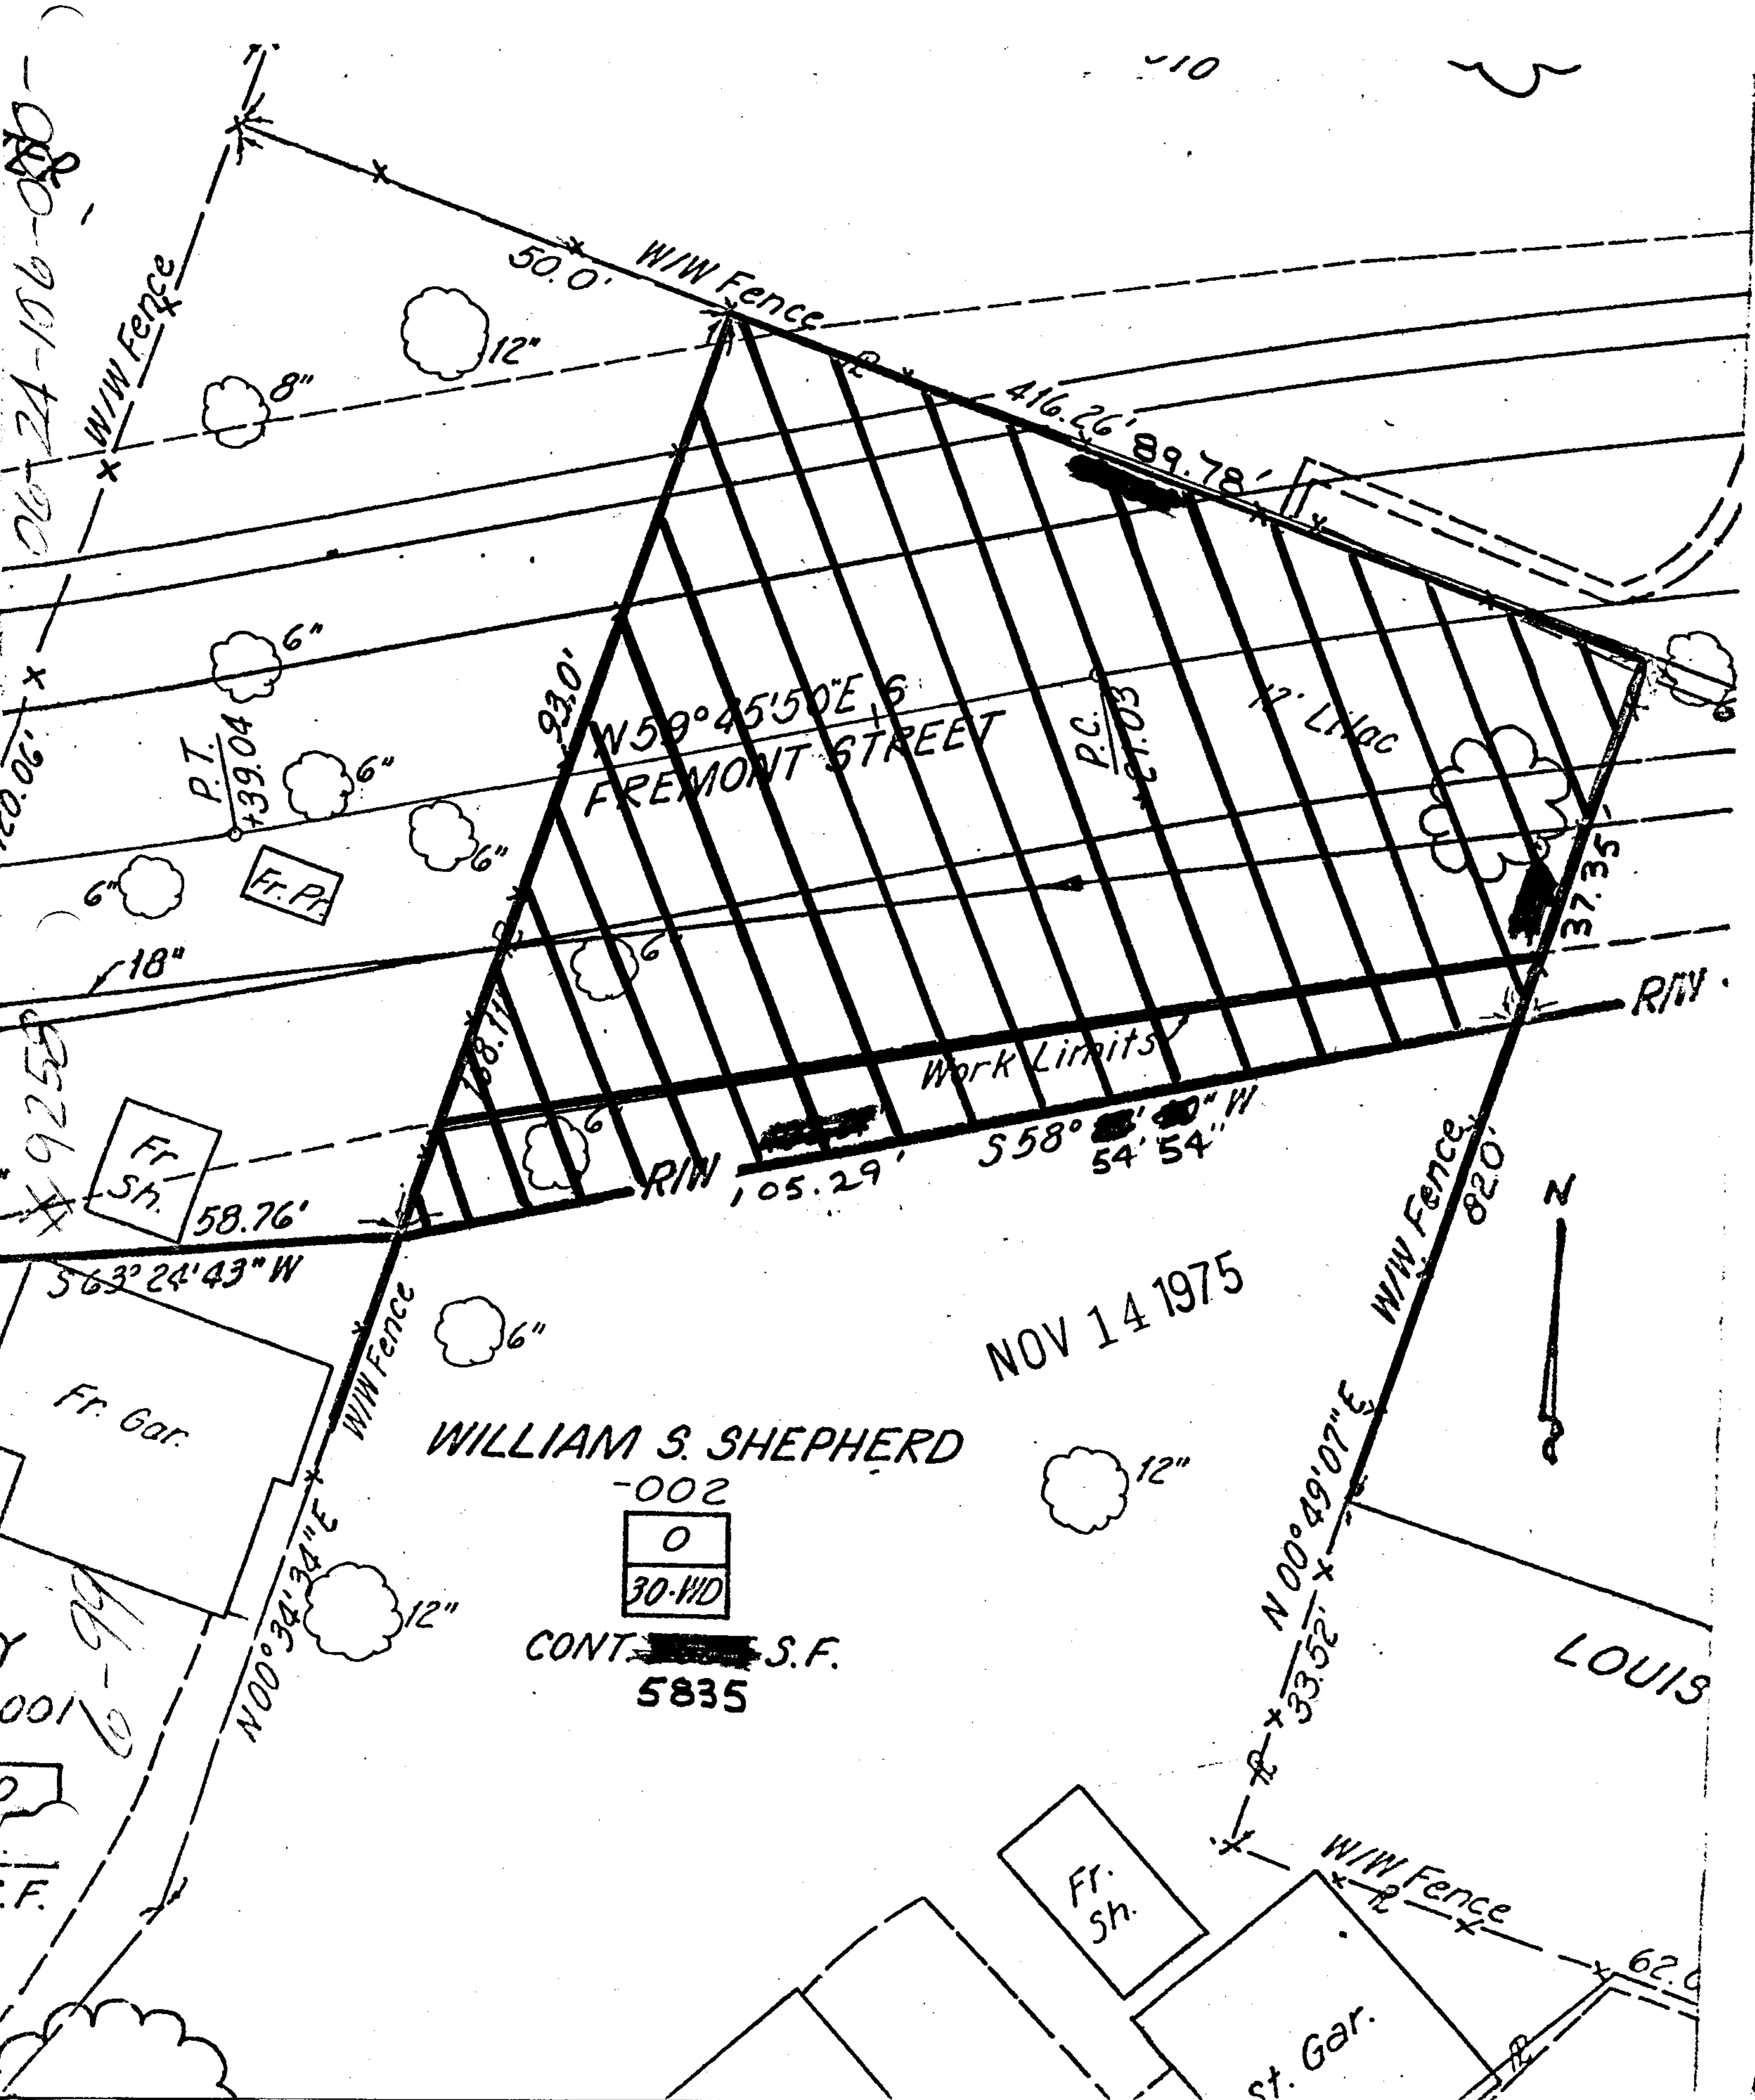

06-24-106-000-

9255

001

10

W

P.T. +39.04
Fr. Pt.

Fr. Sh. 58.76'

WILLIAM S. SHEPHERD

-002
0
30-W/D


CONT. S.F.
5835

NOV 14 1975

LOUIS

Fr. Sh.

st. Gar.

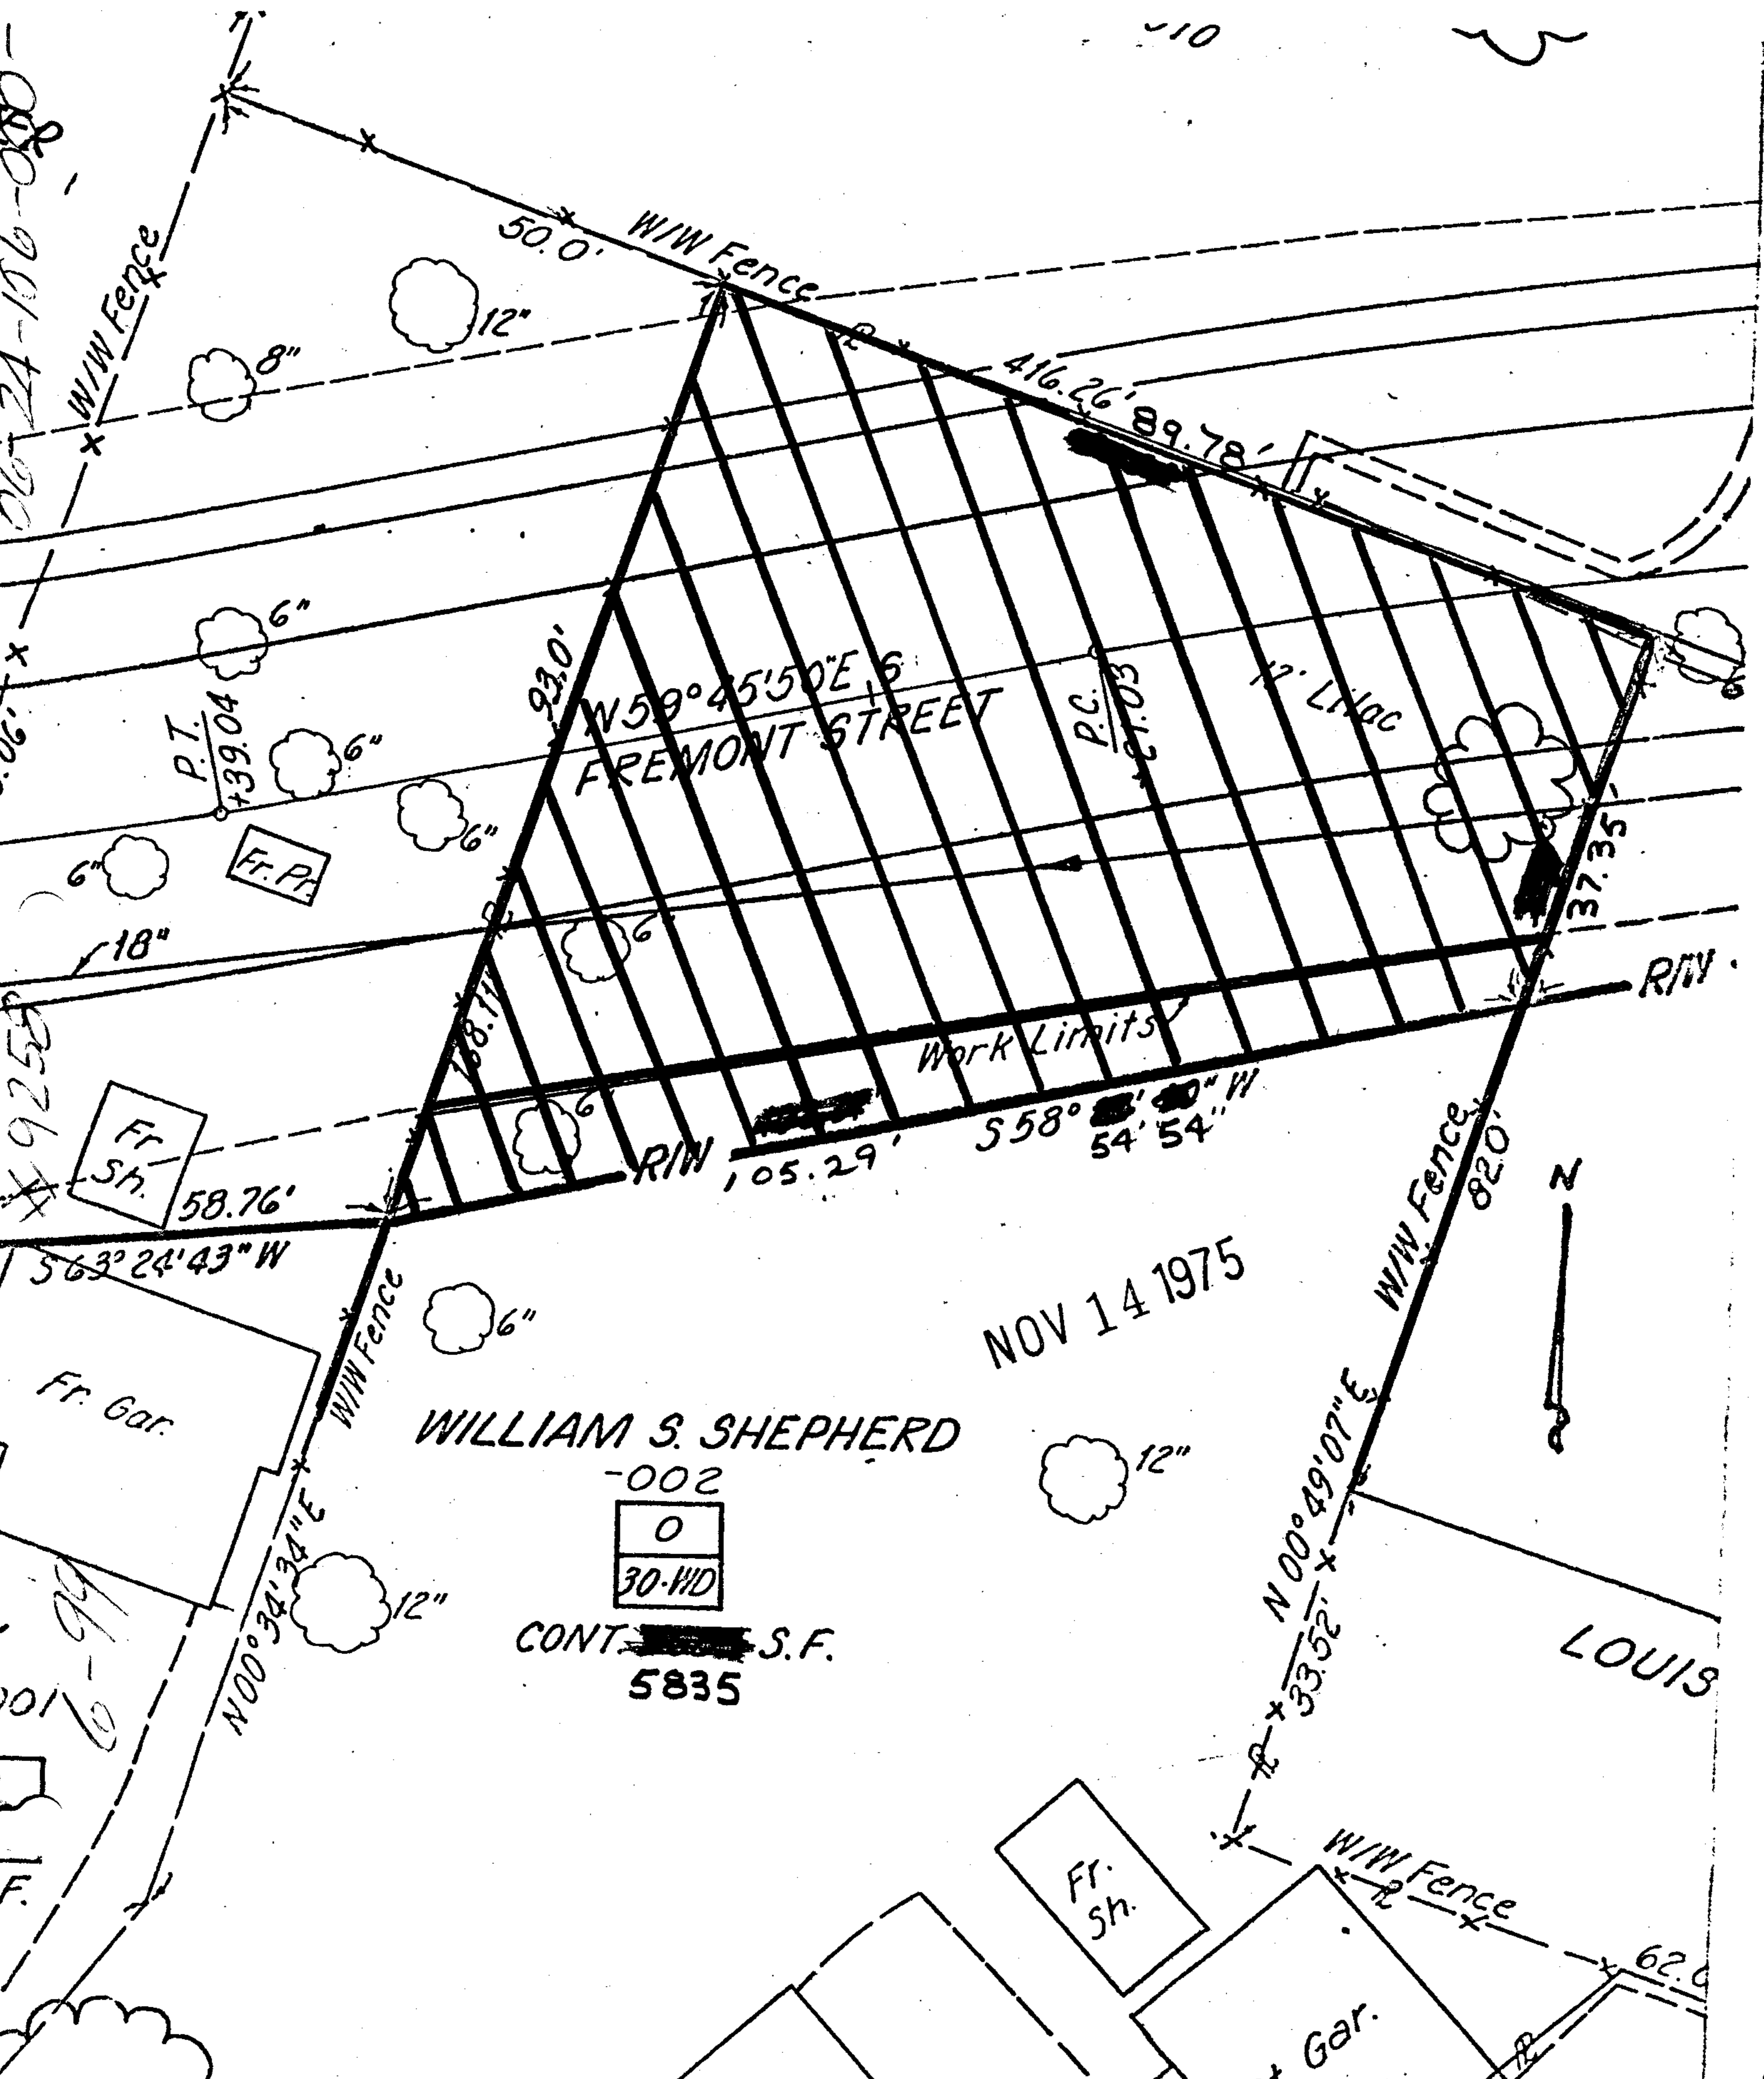

W/W Fence

6"

18"

Fr. Gar.

W/W Fence

50.0' W/W Fence

12"

6"

6"

W/W Fence

93.0'

6"

6"

12"

W/W Fence

W 59° 45' 50" E 6'

FREMONT STREET

Work Limits

105.29'

W/W Fence

416.26'

89.78'

558° 3' 40" W
54' 54"

820'

W/W Fence

37.35'

17' LIAC

W/W Fence

N 00° 49' 07" E
33.52'

W/W Fence

62.0'

Fr. Sh.

st. Gar.

















