

8936

257

JUL 18 1975

500

-001  
8.12 A.

304.92  
20  
284.92

St.

1375


8

C.

C.

ST.

C.

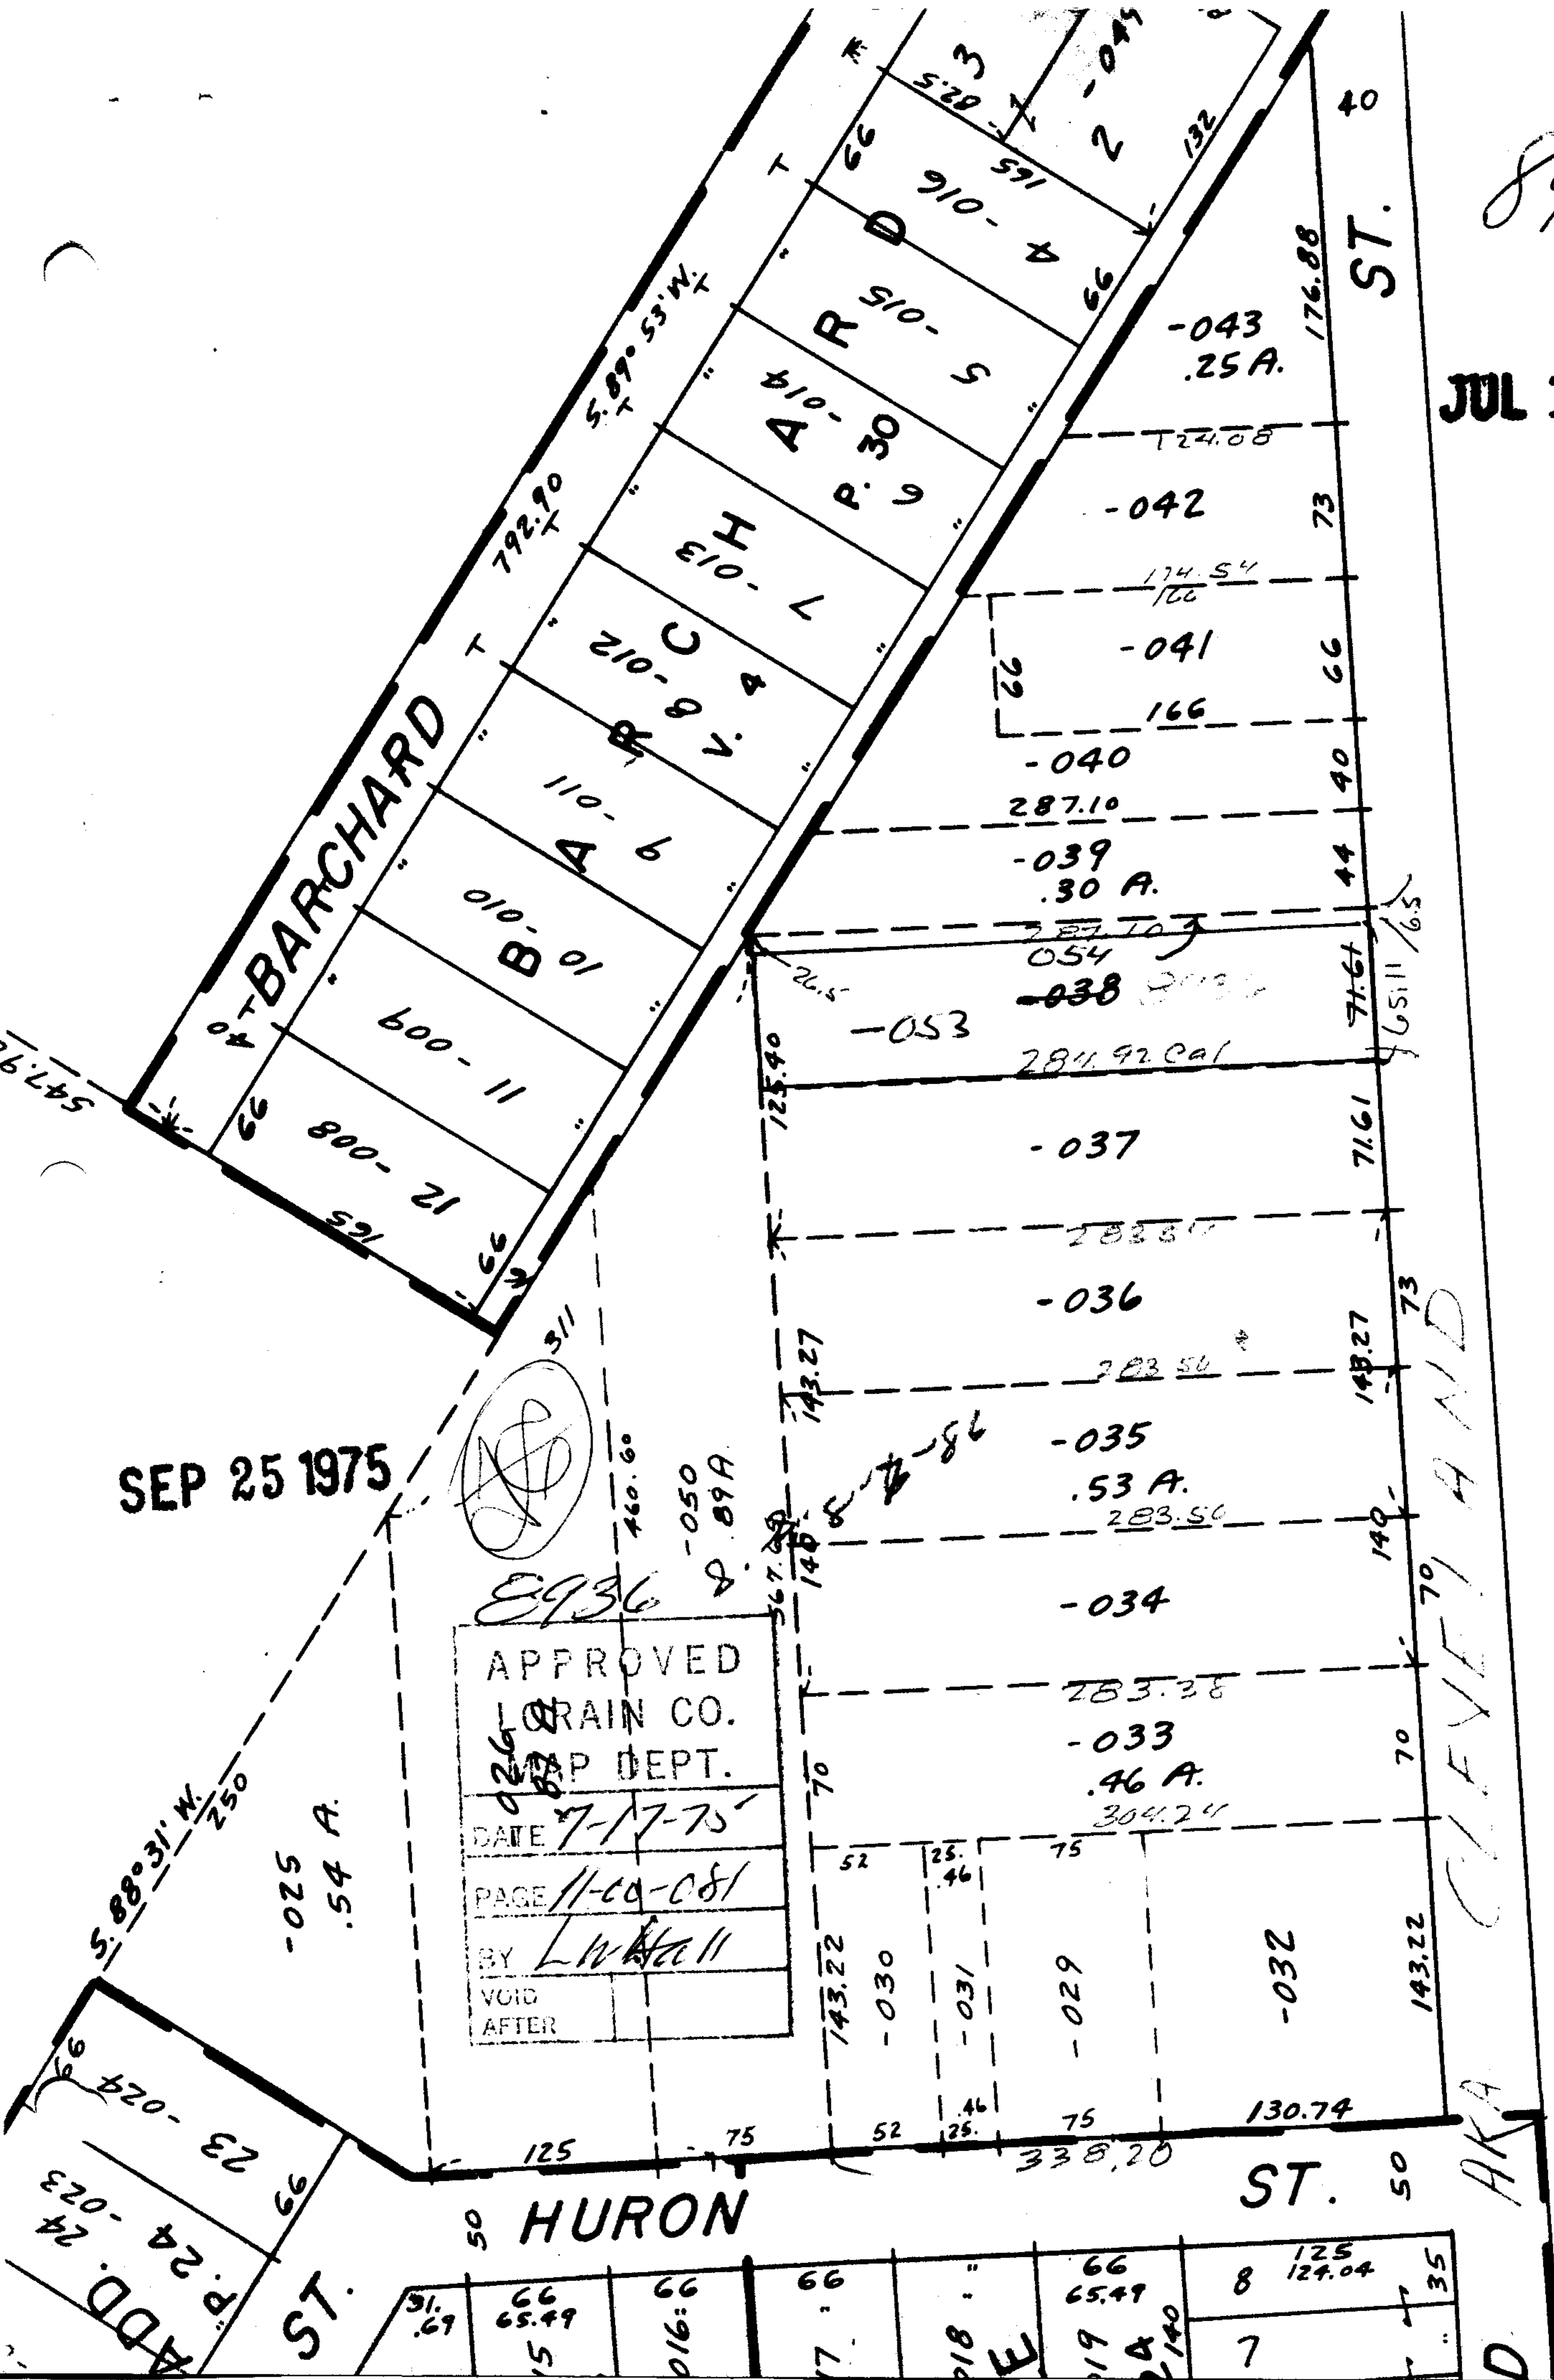

SEP 25 1975



APPROVED  
 LORAIN CO.  
 PLP DEPT.  
 DATE 7-17-75  
 PAGE 11-00-081  
 BY L. W. Hall  
 VOID AFTER

HURON ST.

ST.

AKA CLEVELAND ST.