


893 RD. JUL 21 1975

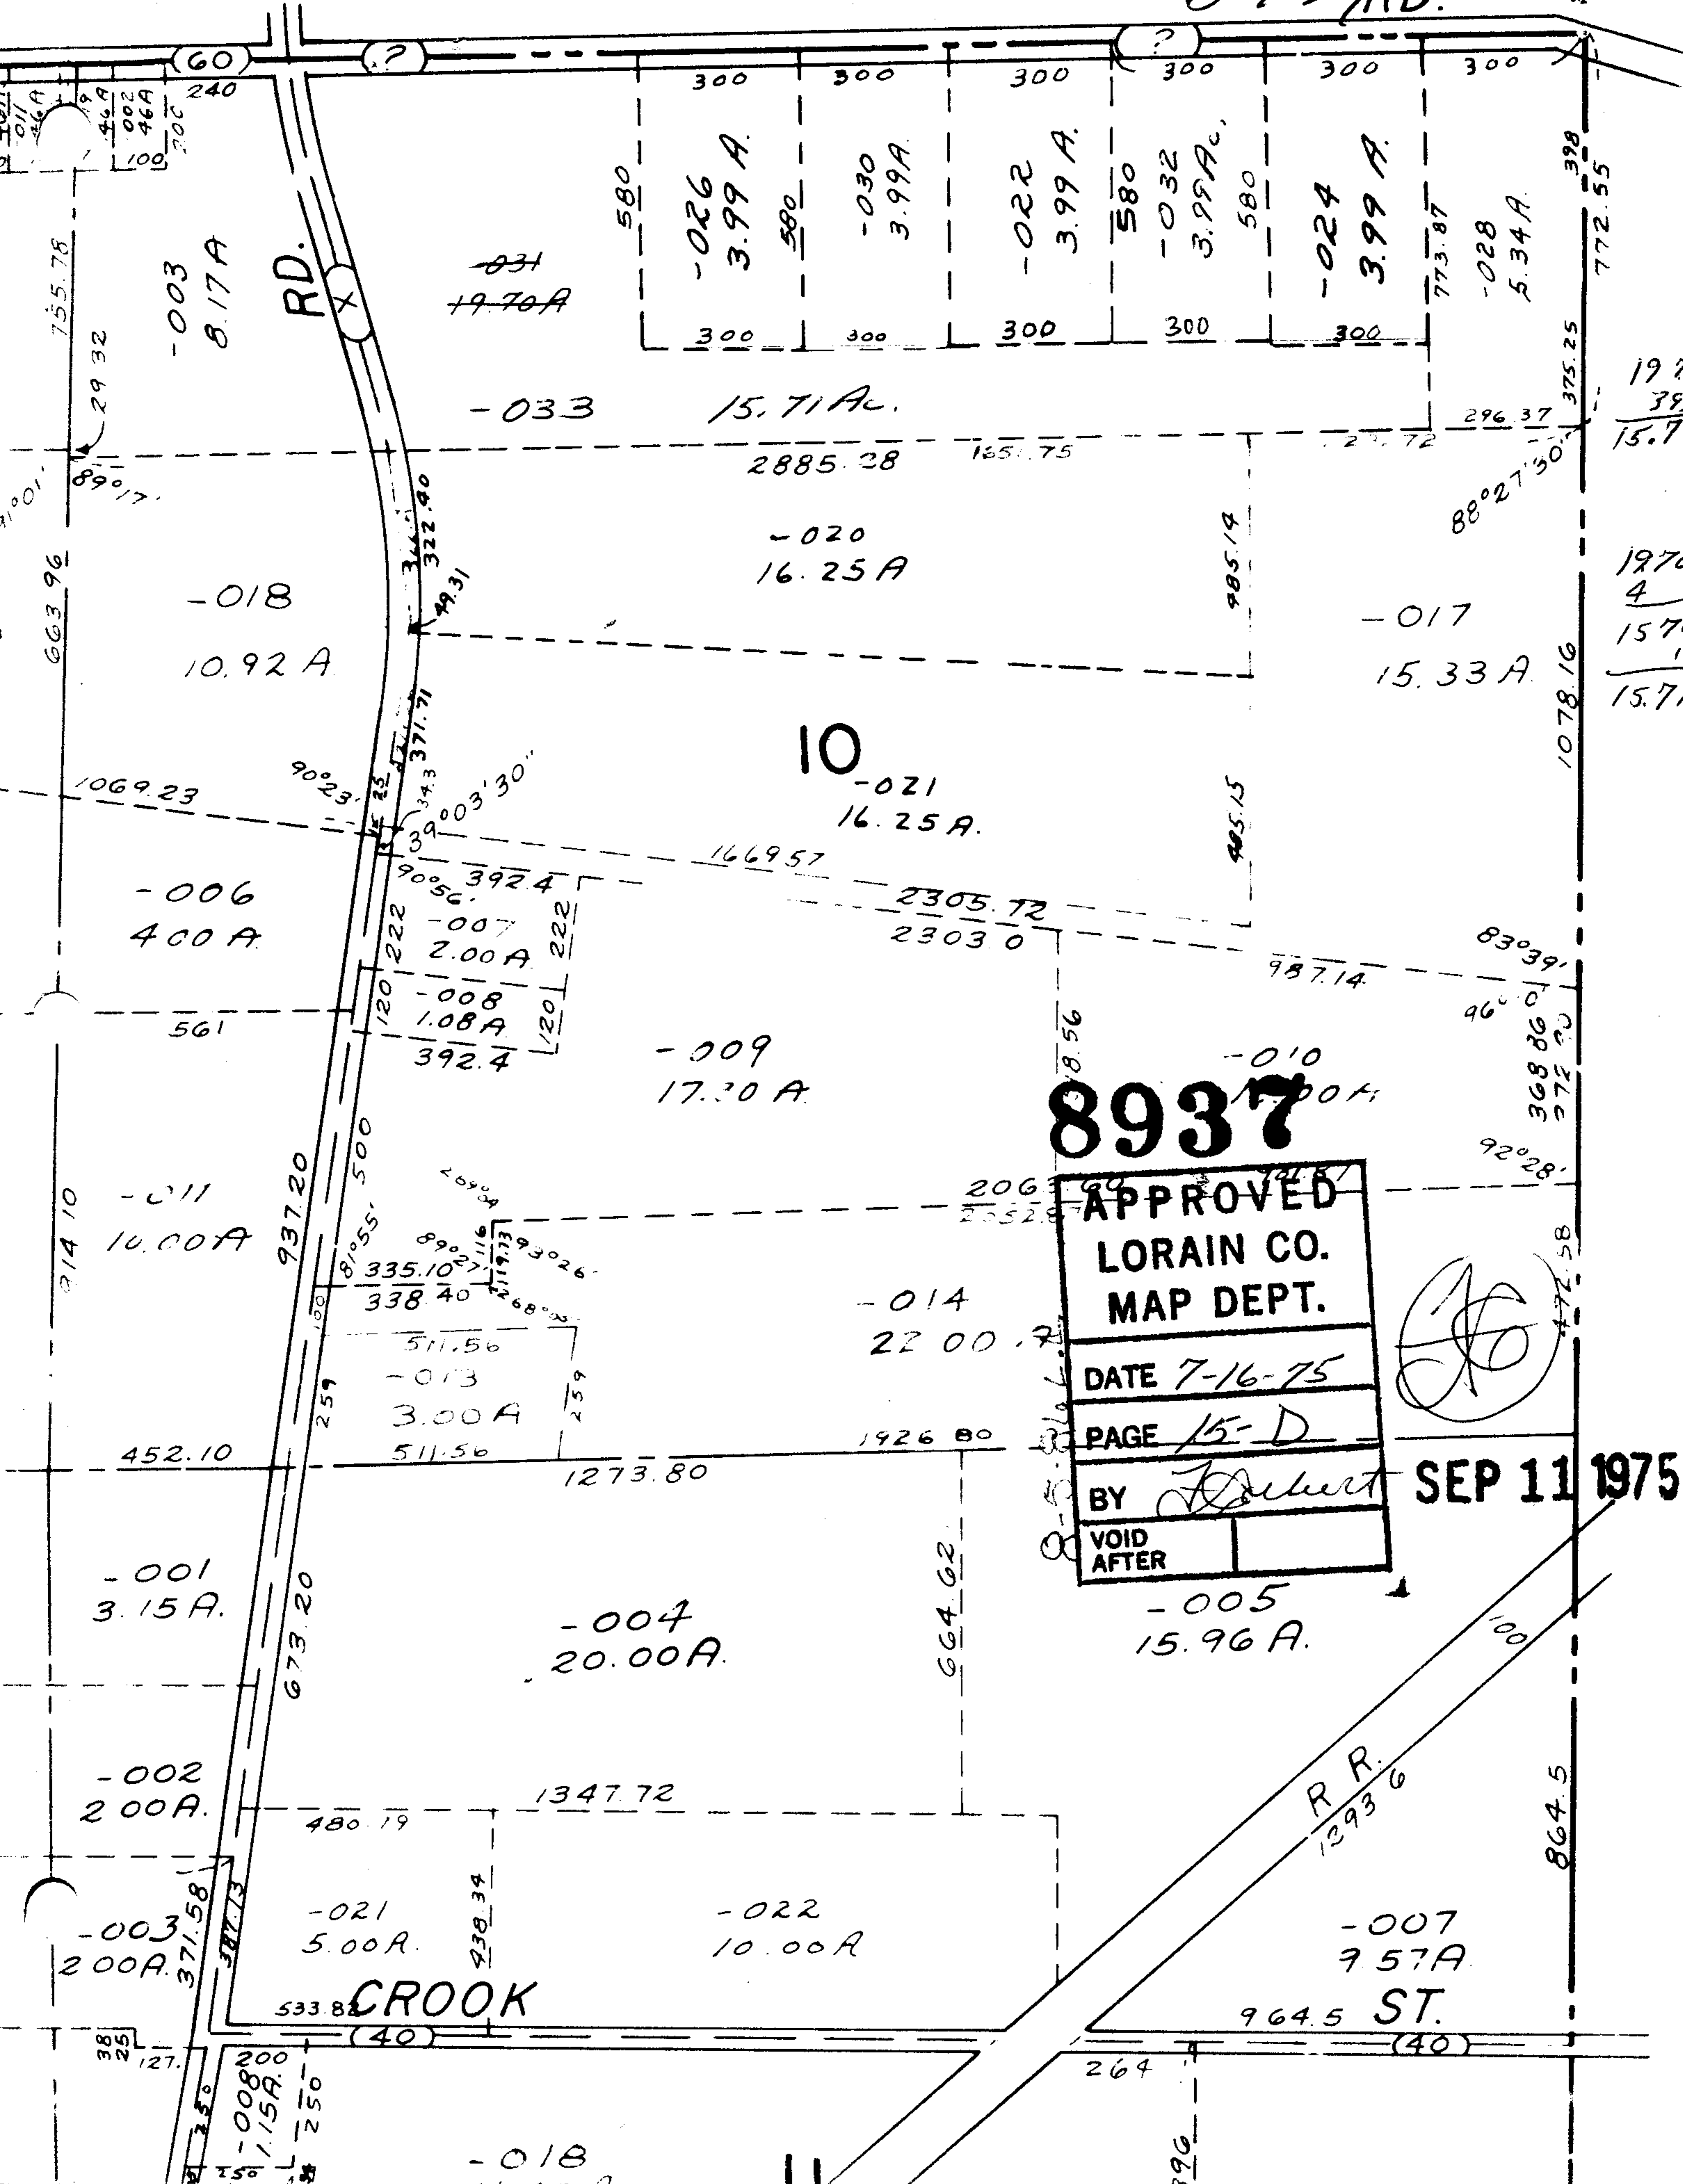

1970
399
15.71
1970
4
1570
1
15.71

8937

APPROVED
 LORAIN CO.
 MAP DEPT.
 DATE 7-16-75
 PAGE 15-D
 BY *J. Schubert*
 VOID AFTER

(Signature)
 SEP 11 1975

CROOK

R.R.
1293.6
ST.
964.5